


U. S. PUBLIC LAND SURVEY MONUMENT RECORD

SECTION 16 T 16 N, R 5 W, TOWN OF BANGOR
 LA CROSSE COUNTY

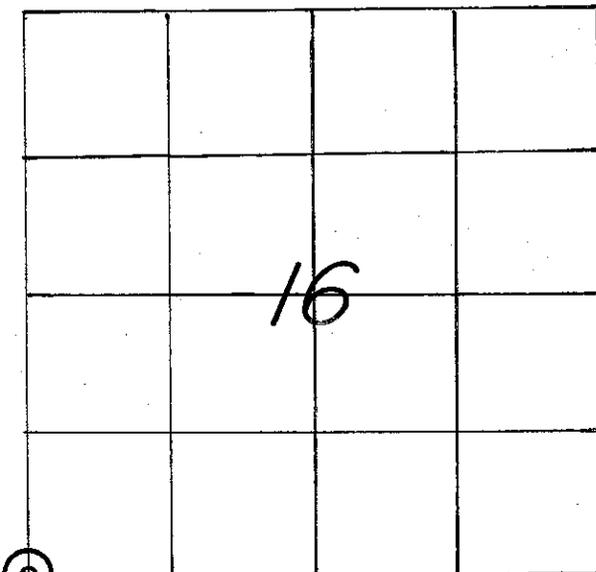

LOCATION OF LANDMARK
 CREW: **BRYAN H. MEYER**
PETER F. FOLLANSBEE
 DATE: **11/11/2009**

WISCONSIN COORDINATE SYSTEM	
North	677,919.299
East	1,707,248.160
Theta Angle	
Horiz. Order	
Vert. Order	
DATUM:	1983('91)
TYPE OF LANDMARK	
P.K. NAIL IN PAVEMENT.	
BEARINGS ARE REFERENCED TO	
GRID NORTH AS PER SECTION DATA.	


Describe any record evidence, monument evidence, testimonial evidence or any other material evidence you considered and whether the monument was found or restored through acceptance of an obliterated evidence location.

Describe or show any material discrepancy between the location of the restored corner and that of the corner previously restored or reestablished.

RECORD OF DURABLE WITNESS MONUMENTS


MAGNETIC

NO	DESCRIPTION	BEARING	DISTANCE
1	EX. 7/8" x 18" IRON BAR IN THE PASTURE	WEST ±	51.84 FT.
2	SET A 3/4" x 30" IRON BAR WITH RED PL. CAP, DOWN 4"	EAST ±	20.92 FT.
3	MOST N.-WESTERLY BOLT ON BASE OF BRIDGE RAIL	S.-EASTERLY ±	140.68 FT.
4	MOST N.-EASTERLY BOLT ON BASE OF BRIDGE RAIL	S.-WESTERLY ±	140.70 FT.

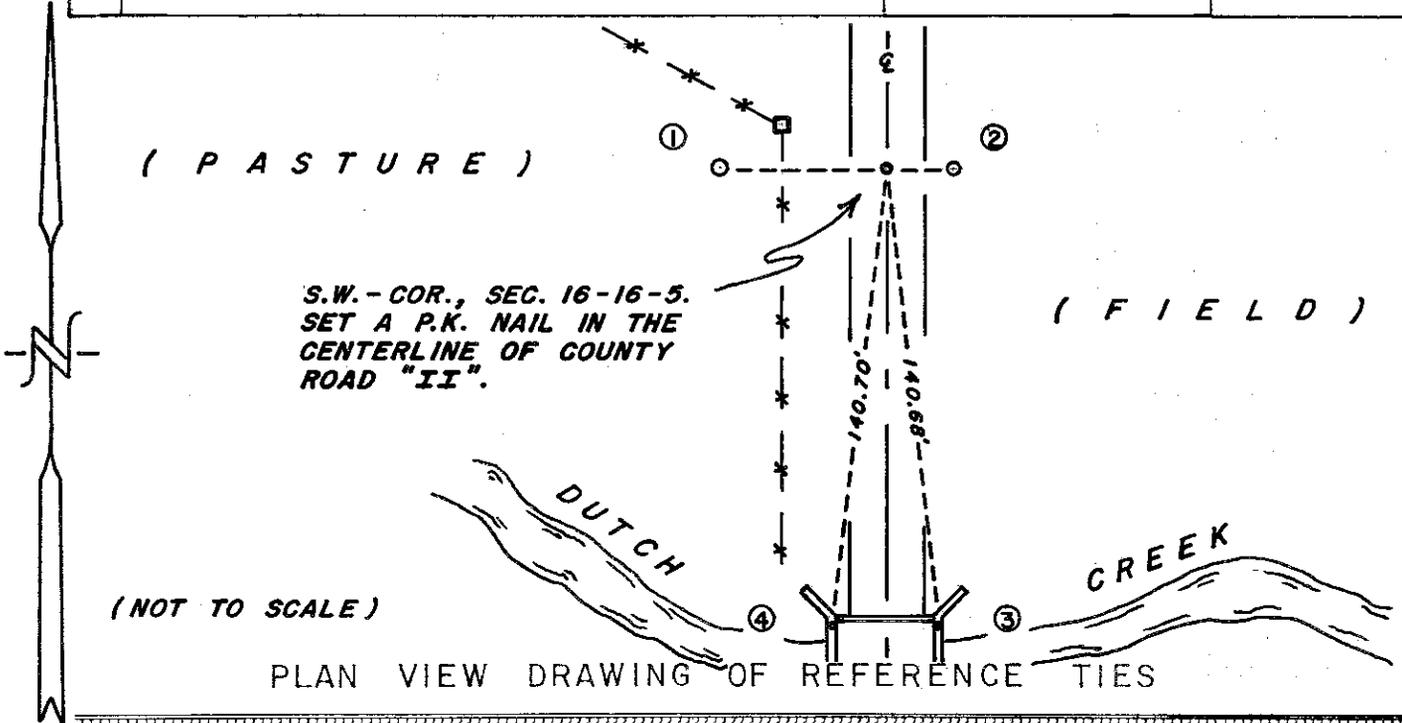


MAP SHOWING DISTANCE AND DIRECTION TO OTHER PUBLIC LAND SURVEY CORNERS USED FOR REESTABLISHING THE CORNER

(GRID BEARINGS AND DISTANCES)
(GRID FACTOR: 0.999912)
(NOT TO SCALE)

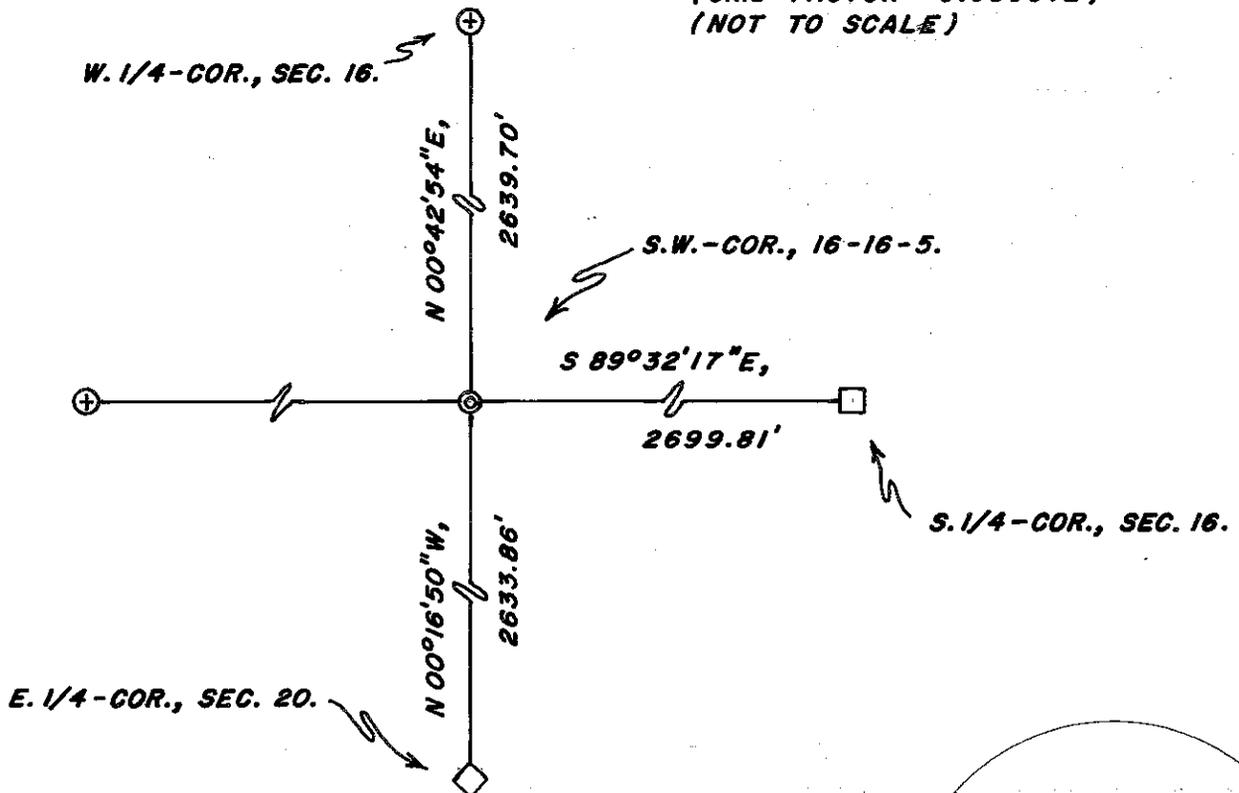

I, BRYAN H. MEYER, COUNTY SURVEYOR
HEREBY CERTIFY THAT THE CORNER LOCATION SHOWN ON THIS RECORD
WAS DETERMINED BY ME OR UNDER MY DIRECTION AND CONTROL AND
THAT THIS U. S. PUBLIC LAND SURVEY MONUMENT RECORD IS CORRECT
AND COMPLETE TO THE BEST OF MY KNOWLEDGE AND BELIEF.

Bryan H. Meyer Signature July 9, 2010 Date

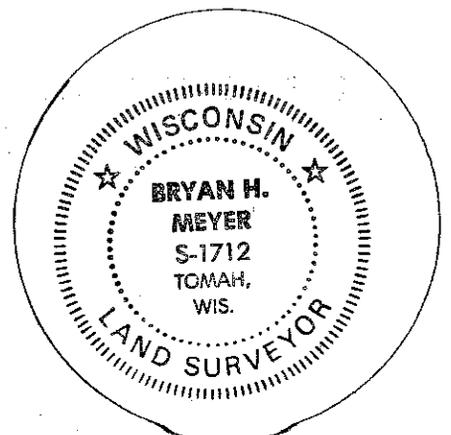


Seal

21605170000

U. S. PUBLIC LAND SURVEY MONUMENT RECORD

SECTION 16 T 16 N, R 5 W, TOWN OF BANGOR
 LA CROSSE COUNTY

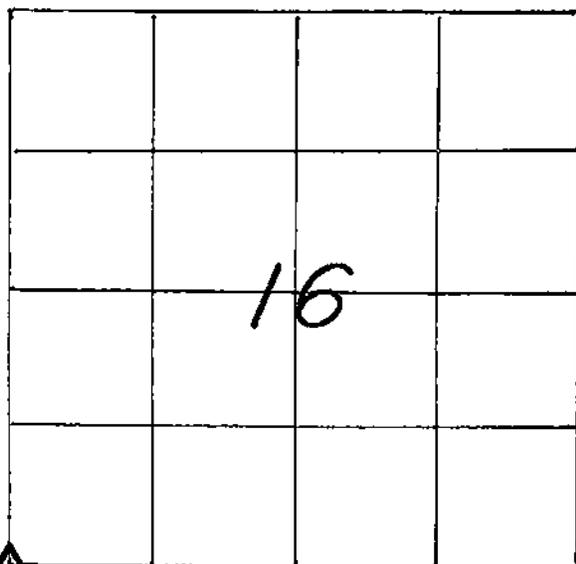

LOCATION OF LANDMARK

CREW: WILLIAM C. JUNG
 PETER F. FOLLANSBEE
 DATE: 2/04/1998

WISCONSIN COORDINATE SYSTEM

North

East

Theta Angle

Horiz. Order

Vert. Order

TYPE OF LANDMARK

EXISTING RAILROAD SPIKE.

BEARINGS ARE REFERENCED TO


Describe any record evidence, monument evidence, testimonial evidence or any other material evidence you considered and whether the monument was found or restored through acceptance of an obliterated evidence location.

Crook set a P.K. nail at this location in 1978. Bob Chalsma tied into it in 1984. It was apparently used as a bridge tie in 1985. In 1992 I was at this corner and found that the P.K. had been paved over as I got a Schonstedt reading. I did not dig up the pavement as it was very hard. I set a railroad spike over the reading. After looking at his measurements and the recorded ones to the South, Fairchild and I agreed that this location should be accepted and used as the corner. Describe or show any material discrepancy between the location of the restored corner and that of the corner previously restored or reestablished.

NONE KNOWN.


RECORD OF DURABLE WITNESS MONUMENTS

NO	DESCRIPTION	BEARING	DISTANCE
1	SET A 7/8" x 18" IRON BAR IN THE PASTURE	WEST ±	51.84 FT.
2	SET A NAIL IN THE N.E.-SIDE 13" BOX ELDER	EAST ±	38.25 FT.
3	SET A NAIL IN THE N.E.-SIDE 11" BOX ELDER	S.'EASTERLY ±	52.60 FT.
4	SET P.K. NAIL IN AT N-EDGE OF STEEL BRIDGE DECK	SOUTH ±	139.40 FT.

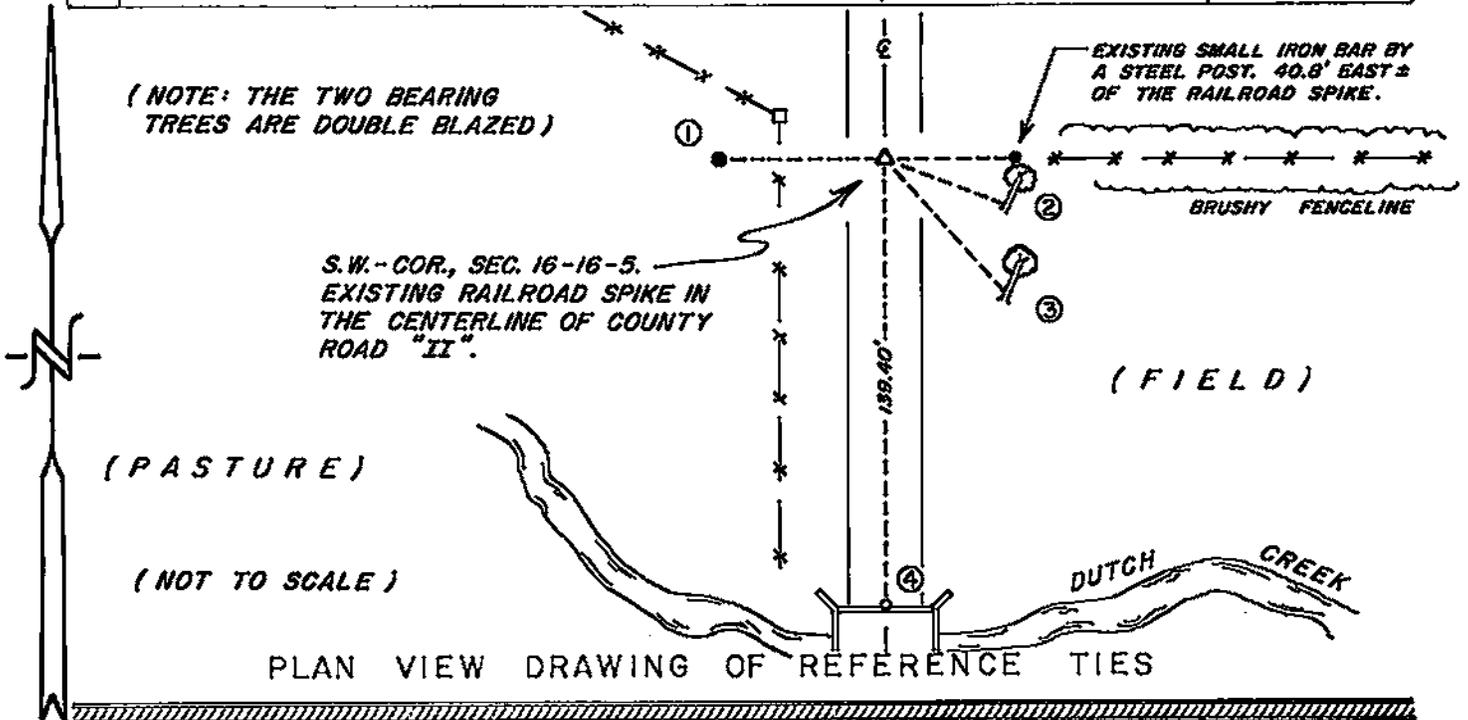

MAP SHOWING DISTANCE AND DIRECTION TO OTHER PUBLIC LAND SURVEY CORNERS USED FOR REESTABLISHING THE CORNER


(not to scale)

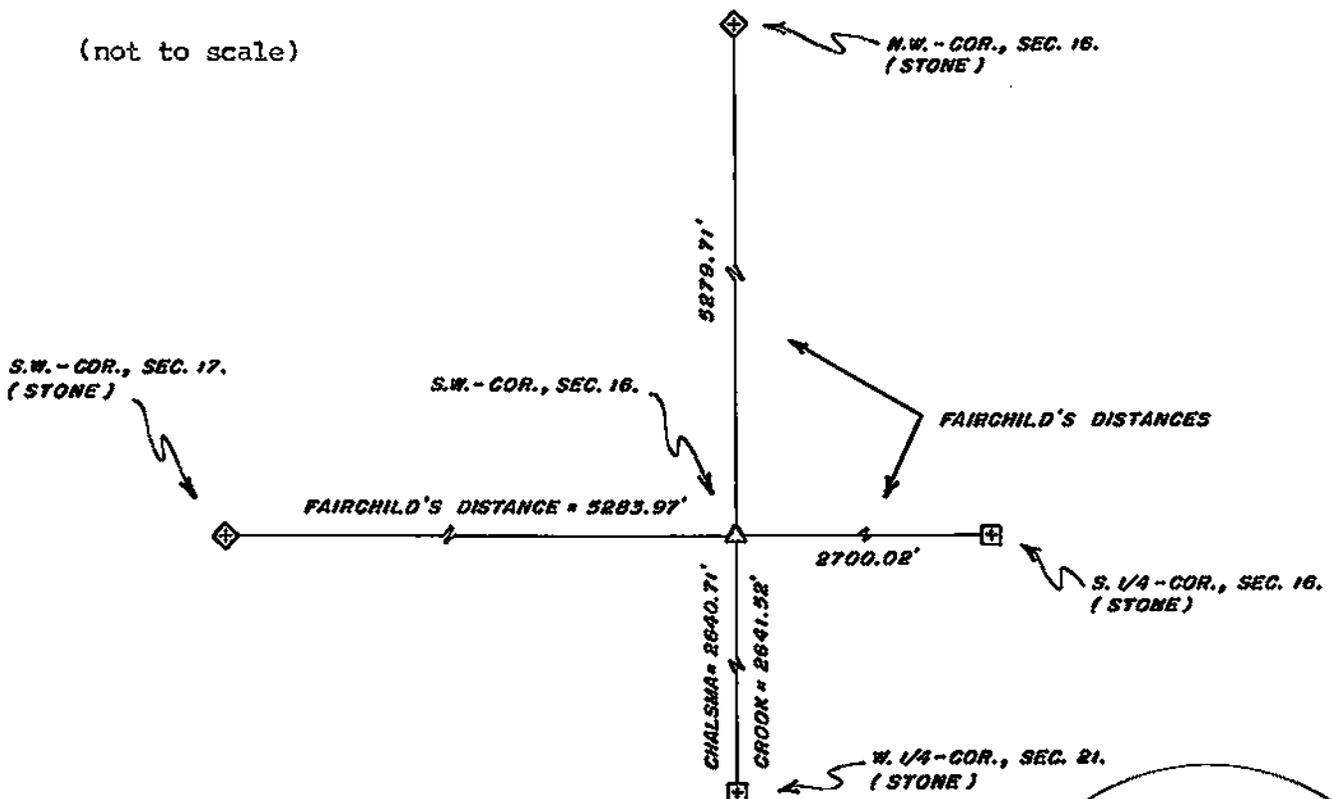

I, WILLIAM C. JUNG, COUNTY SURVEYOR
 HEREBY CERTIFY THAT THE CORNER LOCATION SHOWN ON THIS RECORD WAS DETERMINED BY ME OR UNDER MY DIRECTION AND CONTROL AND THAT THIS U. S. PUBLIC LAND SURVEY MONUMENT RECORD IS CORRECT AND COMPLETE TO THE BEST OF MY KNOWLEDGE AND BELIEF.

William C. Jung
 Signature

2/6/98
 Date

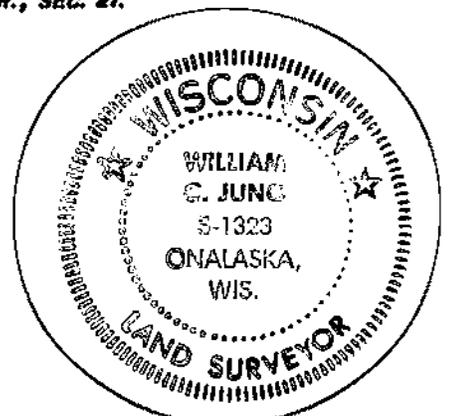

Seal