


U. S. PUBLIC LAND SURVEY MONUMENT RECORD

SECTION 16 T 16 N, R 5 W, TOWN OF BANGOR

LA CROSSE COUNTY

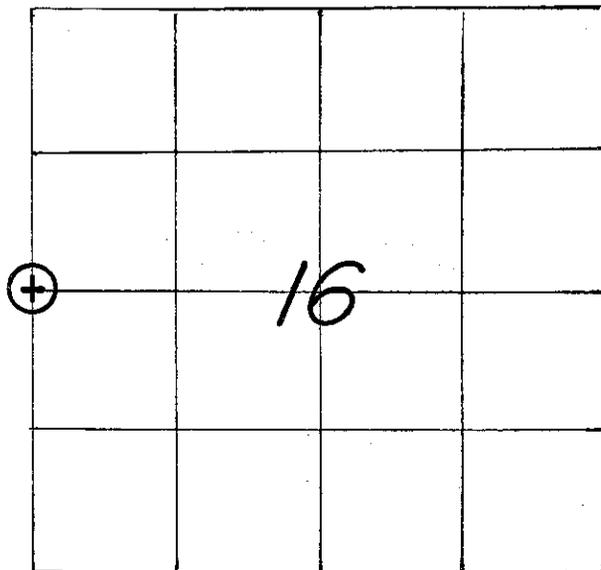

LOCATION OF LANDMARK

CREW: **BRYAN H. MEYER**
PETER F. FOLLANSBEE
 DATE: **11/11/2009**


WISCONSIN COORDINATE SYSTEM	
North	680,558.793
East	1,707,281.103
Theta Angle	
Horiz. Order	
Vert. Order	
DATUM:	NAD 1983('91)
TYPE OF LANDMARK	
3/4" x 30" IRON BAR WITH ALUMINUM CAP.	
BEARINGS ARE REFERENCED TO	
GRID NORTH AS PER SECTION DATA.	

Describe any record evidence, monument evidence, testimonial evidence or any other material evidence you considered and whether the monument was found or restored through acceptance of an obliterated evidence location.


Describe or show any material discrepancy between the location of the restored corner and that of the corner previously restored or reestablished.

RECORD OF DURABLE WITNESS MONUMENTS

NO	DESCRIPTION	MAGNETIC BEARING	DISTANCE
1	SET A NAIL IN N.W.-SIDE OF A 17" ASPEN	S 31° W	24.21 FT.
2	SET A NAIL IN S.W.-SIDE OF A 9-1/2" ELM	N 61° W	21.09 FT.
3	SET A NAIL IN S.E.-SIDE OF A 10-1/2" CHERRY	N 29° E	SLOPE=37.47'
4	SET A P.K. NAIL IN N.E.-SIDE OF A 5" CHERRY	S 40° E	34.51 FT.

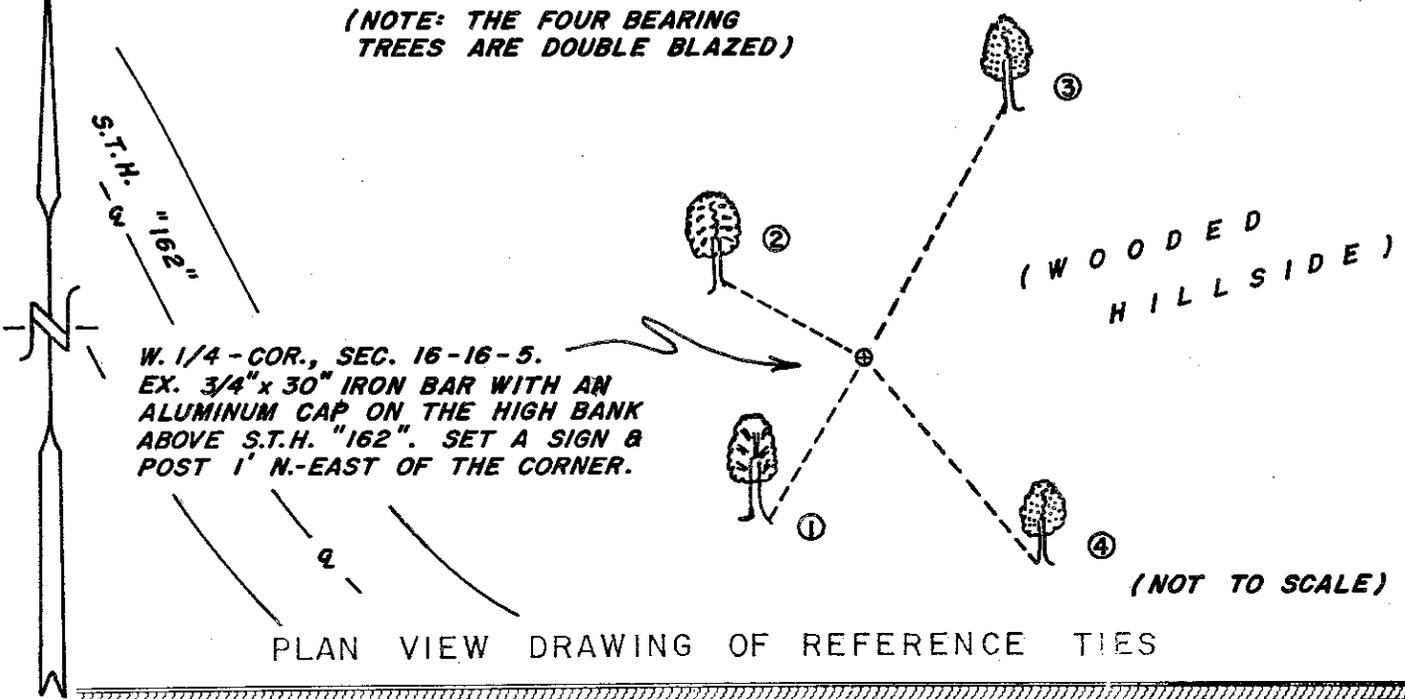


MAP SHOWING DISTANCE AND DIRECTION TO OTHER PUBLIC LAND SURVEY CORNERS USED FOR REESTABLISHING THE CORNER

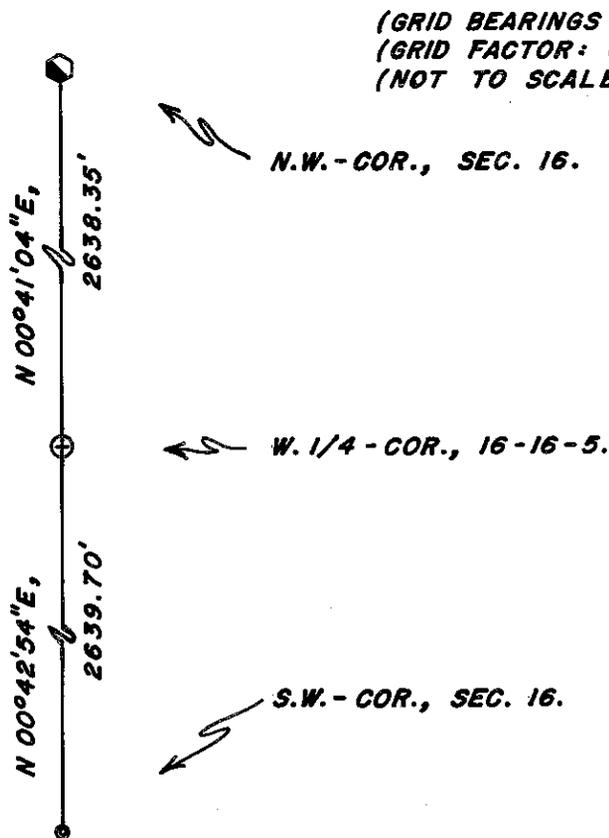

I, BRYAN H. MEYER, COUNTY SURVEYOR
 HEREBY CERTIFY THAT THE CORNER LOCATION SHOWN ON THIS RECORD WAS DETERMINED BY ME OR UNDER MY DIRECTION AND CONTROL AND THAT THIS U. S. PUBLIC LAND SURVEY MONUMENT RECORD IS CORRECT AND COMPLETE TO THE BEST OF MY KNOWLEDGE AND BELIEF.

Bryan H. Meyer
 Signature

July 9, 2010
 Date

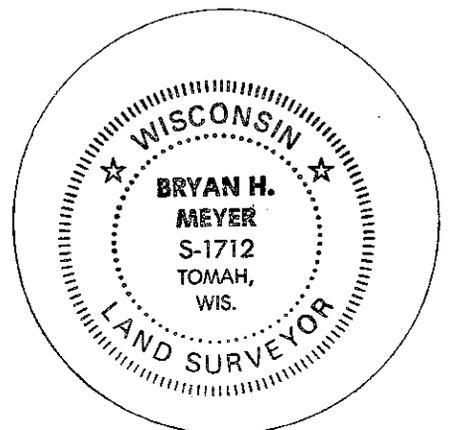


Seal

21605172000

U. S. PUBLIC LAND SURVEY MONUMENT RECORD

SECTION 16 T 16 N, R 5 W, TOWN OF BANGOR
LA CROSSE COUNTY

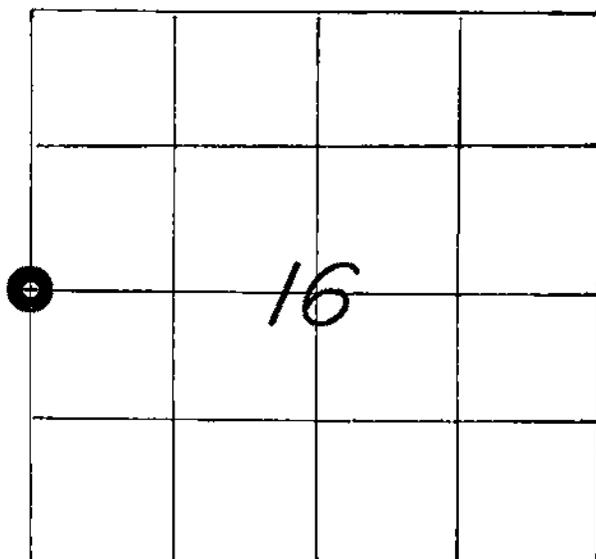

LOCATION OF LANDMARK

CREW: WILLIAM C. JUNG
PETER F. FOLLANSBEE
DATE: 7/22/1998

WISCONSIN COORDINATE SYSTEM

North

East

Theta Angle

Horiz. Order

Vert. Order

TYPE OF LANDMARK

3/4" x 30" IRON BAR WITH ALUMINUM CAP

BEARINGS ARE REFERENCED TO

Describe any record evidence, monument evidence, testimonial evidence or any other material evidence you considered and whether the monument was found or restored through acceptance of an obliterated evidence location.

A stone was on record at this corner but ^{we} were not able to find the portion in the grd.

In 1985 Mr. Burbach told Perry Dahl, my engineering aide, that the stone at this corner had been "pulled out" by someone. I found the top 1' of a 6" square stone.

On more than one occasion we searched for this corner but had no luck. We dug and

probed at length. Using Paul Fairchild's survey points and data, we set the corner

by single proportionate measurement. An iron bar w/cap was set. Fairchild's West line

measurement was 5279.71 .

Describe or show any material discrepancy between the location of the restored corner and that of the corner previously restored or reestablished.

None known.

