


U. S. PUBLIC LAND SURVEY MONUMENT RECORD

SECTION 30 T 16 N, R 5 W, TOWN OF BANGOR

LA CROSSE COUNTY

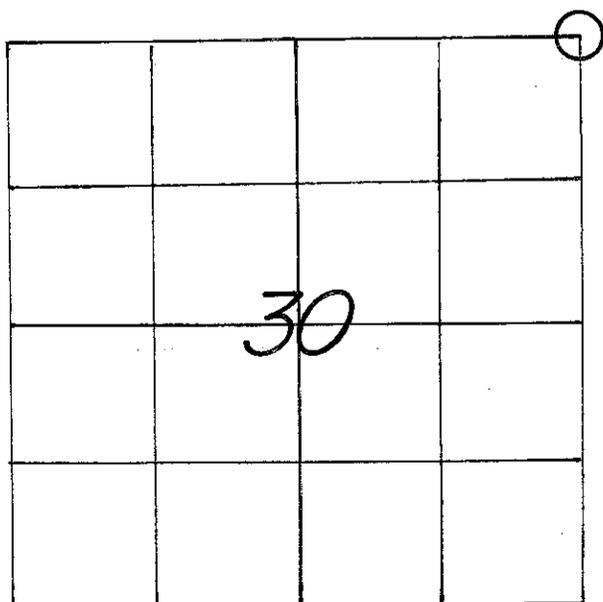

WISCONSIN COORDINATE SYSTEM
North
East
Theta Angle
Horiz. Order
Vert. Order
TYPE OF LANDMARK
<i>1-1/4" x 29" IRON PIPE.</i>
BEARINGS ARE REFERENCED TO

LOCATION OF LANDMARK

CREW: **BRYAN H. MEYER**
PETER F. FOLLANSBEE
 DATE: **11/12/2009**


Describe any record evidence, monument evidence, testimonial evidence or any other material evidence you considered and whether the monument was found or restored through acceptance of an obliterated evidence location.

Describe or show any material discrepancy between the location of the restored corner and that of the corner previously restored or reestablished.

RECORD OF DURABLE WITNESS MONUMENTS

MAGNETIC

NO	DESCRIPTION	BEARING	DISTANCE
1	SET A NAIL IN E.-SIDE OF A 14" RED OAK	N 09° W	29.50 FT.
2	SET A NAIL IN S.W.-SIDE OF A 3-1/2" HICKORY	S 22° E	19.75 FT.
3	SET A NEW NAIL IN N.W.-SIDE 9" OAK w/ TOP BROKEN	S 38° W	SLOPE = 25.38'
4	EX. NAIL IN AN OAK LEANING AT 45°	S 76° W	17.87 FT.

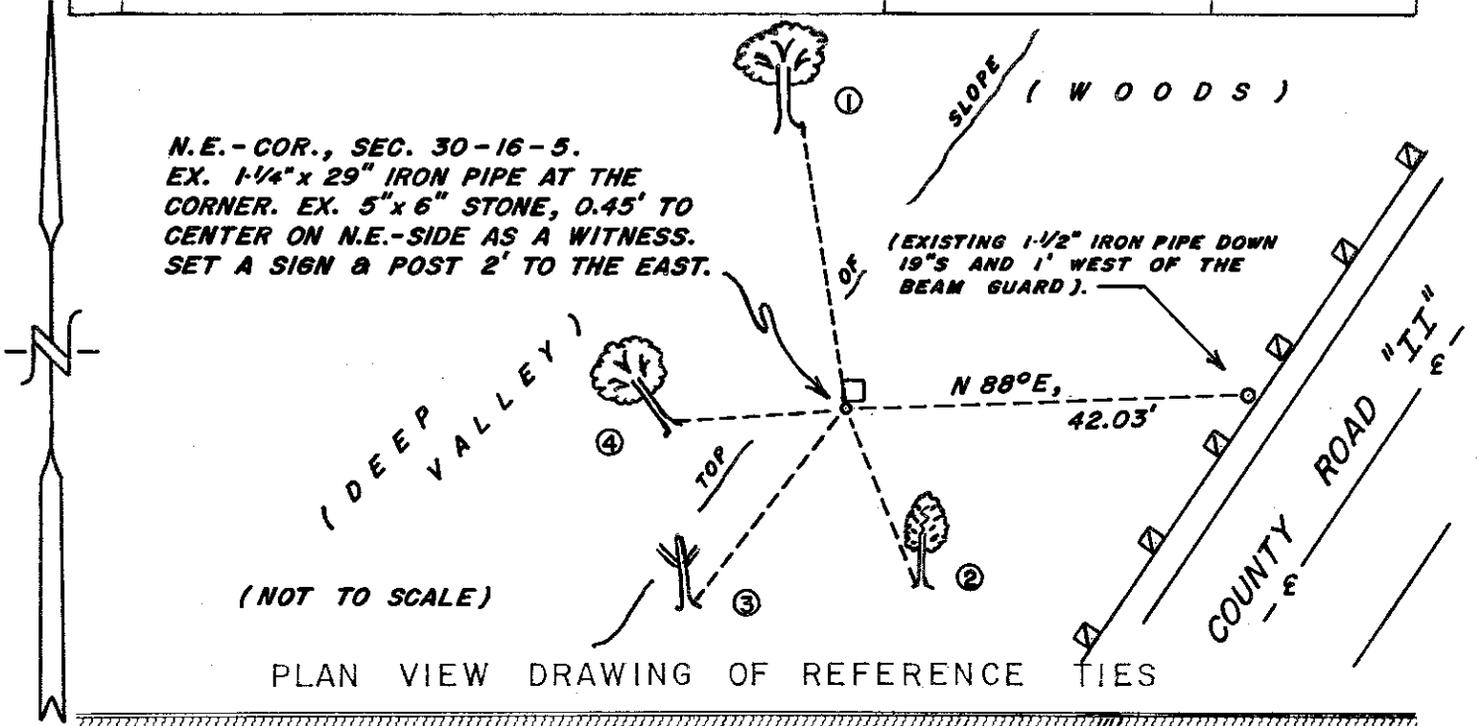

PLAN VIEW DRAWING OF REFERENCE TIES

MAP SHOWING DISTANCE AND DIRECTION TO OTHER PUBLIC LAND SURVEY CORNERS USED FOR REESTABLISHING THE CORNER

I, BRYAN H. MEYER, COUNTY SURVEYOR
 HEREBY CERTIFY THAT THE CORNER LOCATION SHOWN ON THIS RECORD
 WAS DETERMINED BY ME OR UNDER MY DIRECTION AND CONTROL AND
 THAT THIS U. S. PUBLIC LAND SURVEY MONUMENT RECORD IS CORRECT
 AND COMPLETE TO THE BEST OF MY KNOWLEDGE AND BELIEF.

Bryan H. Meyer
 Signature

July 9, 2010
 Date




Seal

21605190000

U. S. PUBLIC LAND SURVEY MONUMENT RECORD

SECTION 30 T 16 N, R 5 W, TOWN OF BANGOR

LA CROSSE COUNTY

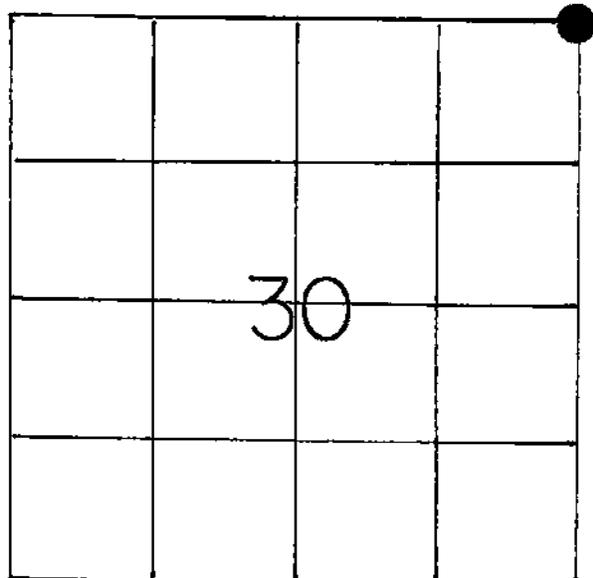

LOCATION OF LANDMARK

Crew: William Jung

7/11/84

WISCONSIN COORDINATE SYSTEM

North

East

Theta Angle

Horiz. Order

Vert. Order

TYPE OF LANDMARK

1 1/4" IRON PIPE

BEARINGS ARE REFERENCED TO

Describe any record evidence, monument evidence, testimonial evidence or any other material evidence you considered and whether the monument was found or restored through acceptance of an obliterated evidence location.

Ken Carlson found a 1 1/4" pipe with a stone lying next to it in May of 1978. I found an iron pipe at the corner with a stone with the top broken off lying by the pipe. I removed the pipe and replaced it with a 1 1/4"x29" iron pipe and set the 5"x6" stone Northeast of and 0.45' from the pipe. The pipe is the corner. ↖ (up 9") I put a mound of rocks around the pipe and stone. The pipe is just East of the slope crest. I accepted the location of the pipe as the best available evidence of the original government corner position.

Describe or show any material discrepancy between the location of the restored corner and that of the corner previously restored or reestablished.


None known.

RECORD OF DURABLE WITNESS MONUMENTS
MAGNETIC

NO	DESCRIPTION	BEARING	DISTANCE
1	NAIL IN 7" HICKORY, DOUBLE-BLAZED	N72°W	9.87'
2	NAIL IN 7" OAK, DOUBLE-BLAZED	S76°W	17.87'
3	NAIL IN 7" OAK, DOUBLE-BLAZED	S38°W	24.25'
4	SET 1 1/2" IRON PIPE (under guard rail)	N87°E	41.9'

(Each distance is to a hack on the side of the tree.)

↑
nail in

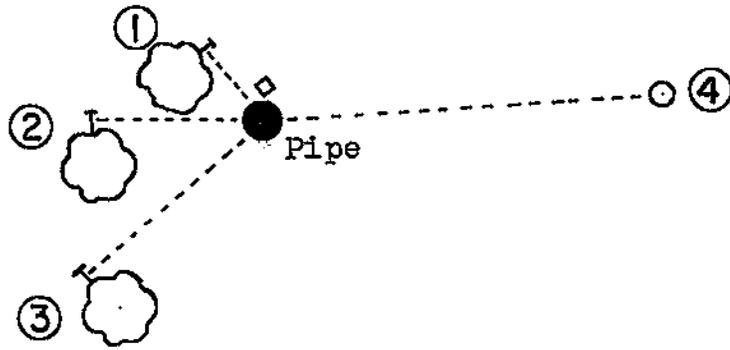

PLAN VIEW DRAWING OF REFERENCE TIES


MAP SHOWING DISTANCE AND DIRECTION TO OTHER PUBLIC LAND SURVEY CORNERS USED FOR REESTABLISHING THE CORNER

See Carlson's section summary of Section 30, dated 5/15/78.

I, William C. Jung, Deputy County Surveyor,
HEREBY CERTIFY THAT THE CORNER LOCATION SHOWN ON THIS RECORD
WAS DETERMINED BY ME OR UNDER MY DIRECTION AND CONTROL AND
THAT THIS U. S. PUBLIC LAND SURVEY MONUMENT RECORD IS CORRECT
AND COMPLETE TO THE BEST OF MY KNOWLEDGE AND BELIEF.

William C. Jung
Signature

2/11/86
Date

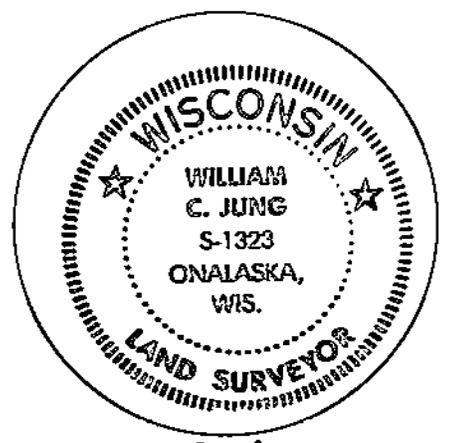

Seal