


21605190020

## U. S. PUBLIC LAND SURVEY MONUMENT RECORD

SECTION 19 T 16 N, R 5 W, TOWN OF BANGOR  
 LA CROSSE COUNTY

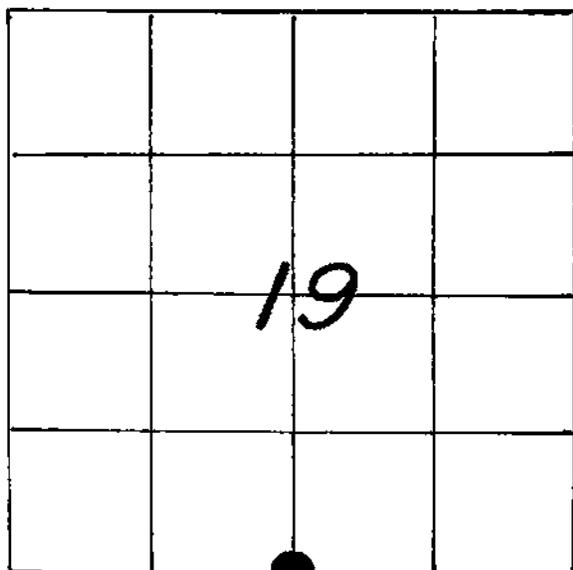

LOCATION OF LANDMARK

Crew: WILLIAM C. JUNG  
 PETER F. FOLLANSBEE  
 Date: 4/30/1996

Describe any record evidence, monument evidence, testimonial evidence or any other material evidence you considered and whether the monument was found or restored through acceptance of an obliterated evidence location.

Ken Carlson set an iron bar at this corner in 1978. He set the corner by single proportionate measurement. I found his iron bar and accepted it as the corner. We found no evidence of an old stone.

Describe or show any material discrepancy between the location of the restored corner and that of the corner previously restored or reestablished.

NONE KNOWN.

## WISCONSIN COORDINATE SYSTEM

North

East

Theta Angle

Horiz. Order

Vert. Order

## TYPE OF LANDMARK

1½" round Iron Bar.

BEARINGS ARE REFERENCED TO

RECORD OF DURABLE WITNESS MONUMENTS

NO	DESCRIPTION	MAGNETIC BEARING	DISTANCE
1	Set P.K. Nail in NW-side 14" Burr Oak	S 46°W	33.47 Ft.
2	Set P.K. Nail in SE-side 5½" Basswood <sup>w/sign</sup>	S 67°W	13.18 Ft.
3	Set P.K. Nail in W.-side 6½" Basswood	N 47°E	41.72 Ft.
4	Set P.K. Nail in SW-side 14½" Basswood	S 46°E	37.57 Ft.

S.¼-Cor., Sec. 19-16-5.  
 Found a 1½" round Iron Bar  
 with a steel post to the  
 north. Mounded the corner  
 with rocks.

( WOODS )

( WOODS )

Note: distances are to P.K.  
 Nails set in single  
 blazed trees.

( Not to scale )


PLAN VIEW DRAWING OF REFERENCE TIES

MAP SHOWING DISTANCE AND DIRECTION TO OTHER PUBLIC LAND SURVEY CORNERS USED FOR REESTABLISHING THE CORNER

No further section measurements were made by me at this time.

I, William C. Jung, County Surveyor  
 HEREBY CERTIFY THAT THE CORNER LOCATION SHOWN ON THIS RECORD  
 WAS DETERMINED BY ME OR UNDER MY DIRECTION AND CONTROL AND  
 THAT THIS U. S. PUBLIC LAND SURVEY MONUMENT RECORD IS CORRECT  
 AND COMPLETE TO THE BEST OF MY KNOWLEDGE AND BELIEF.

William C. Jung                      10/30/96  
 Signature                                      Date

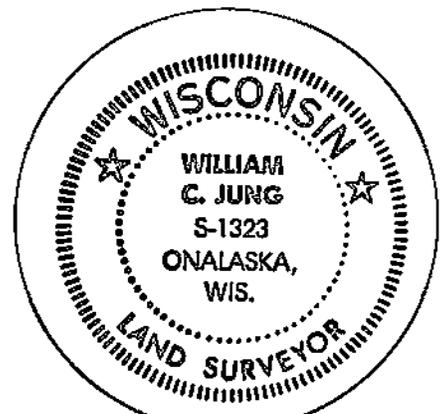

Seal.