


21605192000

## U. S. PUBLIC LAND SURVEY MONUMENT RECORD

SECTION 19 T 16 N, R 5 W, TOWN OF Bangor  
 LA CROSSE COUNTY

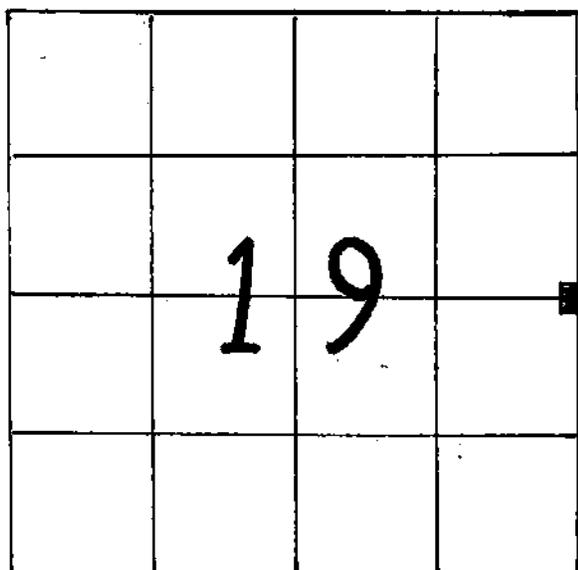

LOCATION OF LANDMARK

Crew: William C. Jung

Date: 5/2/91

## WISCONSIN COORDINATE SYSTEM

North

East

Theta Angle

Horiz. Order

Vert. Order

## TYPE OF LANDMARK

Stone

## BEARINGS ARE REFERENCED TO

Describe any record evidence, monument evidence, testimonial evidence or any other material evidence you considered and whether the monument was found or restored through acceptance of an obliterated evidence location.

I found an old 6" square stone split in half and lying on the ground. It appears that a combination of time, frost, water, and erosion "kicked" the old stone out of the ground. I reset it where it appeared to have been set, that is at the North end of the line fence. I tied the stone off with fence wire and set a 1" iron pipe as a witness pipe on the North side of the stone. The stone is the corner and the pipe is 0.43' from the center of the stone. The stone was scribed "1/4 S" and is up about 6" or so. The center of the stone is 1.52' North of the North edge of the steel fence post. I accepted the stone as the best available evidence of the original government corner position.

Describe or show any material discrepancy between the location of the restored corner and that of the corner previously restored or reestablished.


None known.

RECORD OF DURABLE WITNESS MONUMENTS

Magnetic

NO	DESCRIPTION	BEARING	DISTANCE
1	P.K. nail in unblazed 12" birch	N25°E	slope=24.43
2	" 12" hickory	N80°E	" =60.96
3	" (4) tree birch group	S40°E	" = 4.14
4			

\* \* distances are from P.K. nails directly to stone

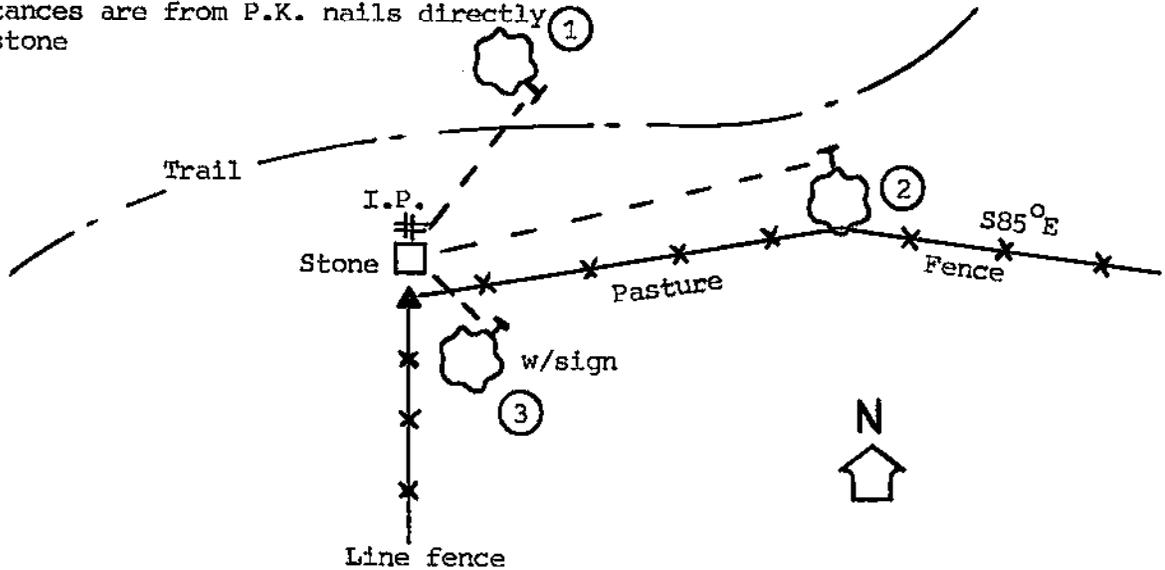

(not to scale)

PLAN VIEW DRAWING OF REFERENCE TIES


MAP SHOWING DISTANCE AND DIRECTION TO OTHER PUBLIC LAND SURVEY CORNERS USED FOR REESTABLISHING THE CORNER

No section measurements made by me at this time.

I, William C. Jung, Deputy County Surveyor,  
 HEREBY CERTIFY THAT THE CORNER LOCATION SHOWN ON THIS RECORD  
 WAS DETERMINED BY ME OR UNDER MY DIRECTION AND CONTROL AND  
 THAT THIS U. S. PUBLIC LAND SURVEY MONUMENT RECORD IS CORRECT  
 AND COMPLETE TO THE BEST OF MY KNOWLEDGE AND BELIEF.

William C. Jung  
 Signature

May 8, 1991  
 Date

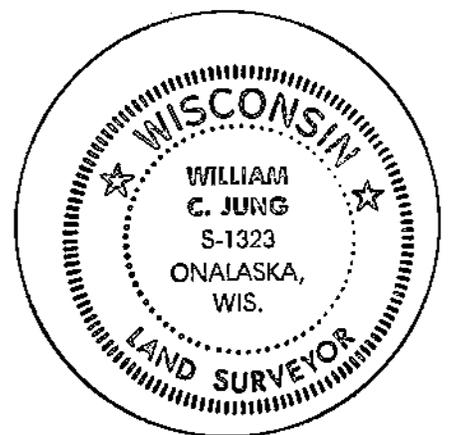

Seal