


21605200000

U. S. PUBLIC LAND SURVEY MONUMENT RECORD

SECTION 28 T 16 N, R 5 W, TOWN OF BANGOR  
 LA CROSSE COUNTY

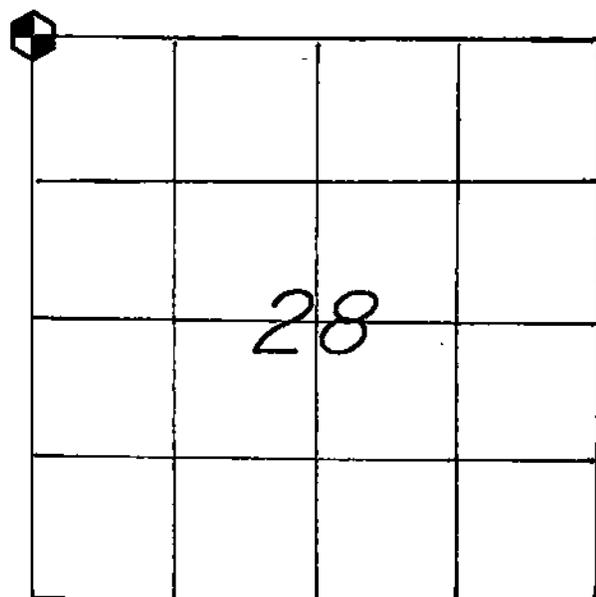

WISCONSIN COORDINATE SYSTEM
North
East
Theta Angle
Horiz. Order
Vert. Order
TYPE OF LANDMARK
Set brass cap Lunde marker.
BEARINGS ARE REFERENCED TO

LOCATION OF LANDMARK

Crew: WILLIAM C. JUNG  
 PETER F. FOLLANSBEE  
 Date: 9/06/1996

Describe any record evidence, monument evidence, testimonial evidence or any other material evidence you considered and whether the monument was found or restored through acceptance of an obliterated evidence location.

Mike Harding from Solberg and Associates computed out a corner location for this corner that I agree with. Peter and I, along with Mike and Scott from Solberg's, dug a very large hole looking for a stone. Unfortunately we found no evidence of the 1867 stone or the original corner. We set a brass capped Lunde marker at Harding's calculated corner position.

Describe or show any material discrepancy between the location of the restored corner and that of the corner previously restored or reestablished.

None Known,

