


21605200020

U. S. PUBLIC LAND SURVEY MONUMENT RECORD

SECTION 29 T 16 N, R 5 W, TOWN OF BANGOR  
 LA CROSSE COUNTY

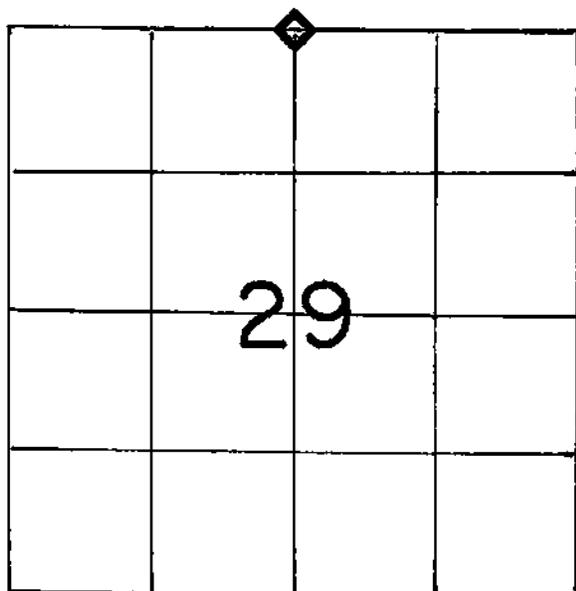

LOCATION OF LANDMARK

WISCONSIN COORDINATE SYSTEM
North
East
Theta Angle
Horiz. Order
Vert. Order
TYPE OF LANDMARK
Existing 6" square Stone.
BEARINGS ARE REFERENCED TO

Crew: WILLIAM C. JUNG

Date: 10/15/1992

Describe any record evidence, monument evidence, testimonial evidence or any other material evidence you considered and whether the monument was found or restored through acceptance of an obliterated evidence location.

I found a stone at the corner and accepted it as the best available evidence of the original government corner position.


Describe or show any material discrepancy between the location of the restored corner and that of the corner previously restored or reestablished.

None Known

RECORD OF DURABLE WITNESS MONUMENTS

NO	DESCRIPTION	BEARING	DISTANCE
1	Set P.K. Nail in NE-side 6" Oak	Northwesterly	8.97 Ft.
2	Set P.K. Nail in NE-side 10" Oak	Northwesterly	18.09 Ft.
3	Set P.K. Nail in NW-side 7" Hickory	Northeasterly	18.50 Ft.
4	Set P.K. Nail in SW-side 13" Hickory	Southeasterly	10.02 Ft.

(Note: Distance are measured to set P.K. Nails in the sides of double blazed trees.)

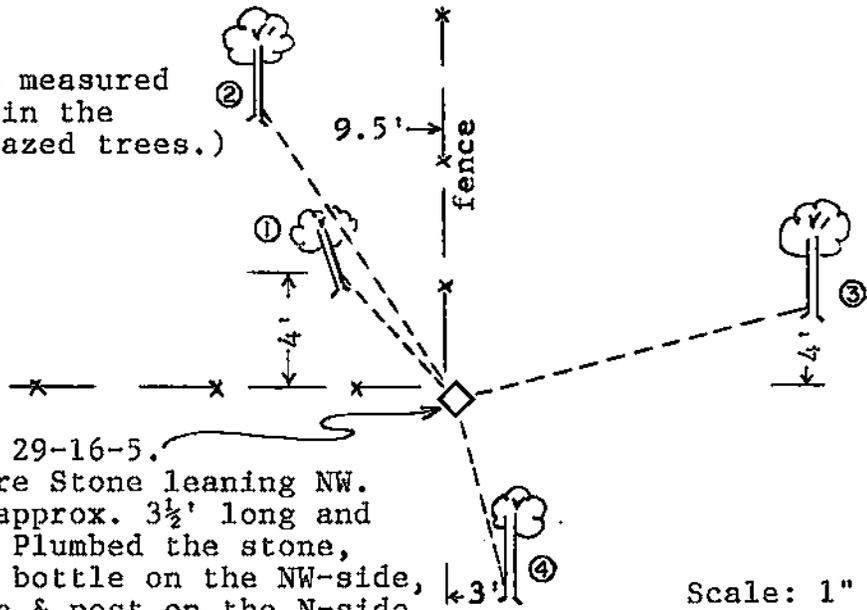

N $\frac{1}{4}$ -Cor., Sec. 29-16-5.  
 Found 6" square Stone leaning NW.  
 The stone is approx. 3 $\frac{1}{2}$ ' long and  
 up 21 inches. Plumbed the stone,  
 buried a wine bottle on the NW-side,  
 and set a sign & post on the N-side.

Scale: 1" = 10'


PLAN VIEW DRAWING OF REFERENCE TIES

MAP SHOWING DISTANCE AND DIRECTION TO OTHER PUBLIC LAND SURVEY CORNERS USED FOR REESTABLISHING THE CORNER

None made by me at this time.

I, William C. Jung, Deputy County Surveyor  
 HEREBY CERTIFY THAT THE CORNER LOCATION SHOWN ON THIS RECORD  
 WAS DETERMINED BY ME OR UNDER MY DIRECTION AND CONTROL AND  
 THAT THIS U. S. PUBLIC LAND SURVEY MONUMENT RECORD IS CORRECT  
 AND COMPLETE TO THE BEST OF MY KNOWLEDGE AND BELIEF.

William C. Jung 12/15/92  
 Signature Date

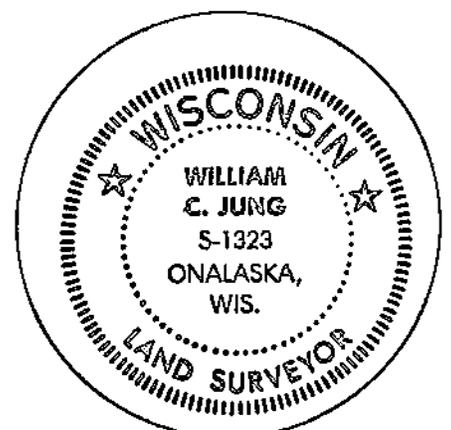

Seal