


21605210020

## U. S. PUBLIC LAND SURVEY MONUMENT RECORD

SECTION 28 T 16 N, R 5 W, TOWN OF BANGOR

LA CROSSE COUNTY

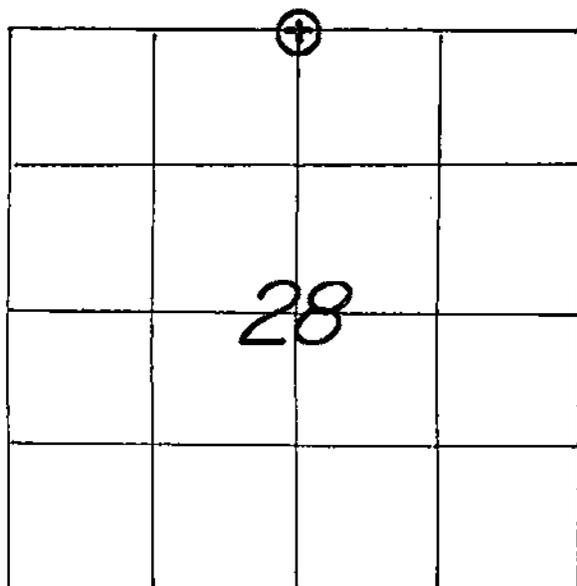

WISCONSIN COORDINATE SYSTEM	
North	672,626.422
East	1,709,839.749
Theta Angle	
Horiz. Order	
Vert. Order	
DATUM:	NAD 1983('91)
TYPE OF LANDMARK	
3/4" x 30" IRON BAR WITH AN ALUMINUM CAP.	
BEARINGS ARE REFERENCED TO	
GRID NORTH AS PER SECTION DATA.	

## LOCATION OF LANDMARK

CREW: WILLIAM C. JUNG  
 PETER F. FOLLANSBEE  
 DATE: 10/23/2003

Describe any record evidence, monument evidence, testimonial evidence or any other material evidence you considered and whether the monument was found or restored through acceptance of an obliterated evidence location.

This corner was set by single proportionate measurement. Mr. Antony's son said that this area had been bulldozed in the past. It would appear that if the Bliss stone was in, then the bulldozer would have got it. We set an iron bar and cap at the corner, down 12 inches in the field.

Describe or show any material discrepancy between the location of the restored corner and that of the corner previously restored or reestablished.

**NONE KNOWN.**

