


21605212000

## U. S. PUBLIC LAND SURVEY MONUMENT RECORD

SECTION 21 T 16 N, R 5 W, TOWN OF BANGOR

LA CROSSE COUNTY

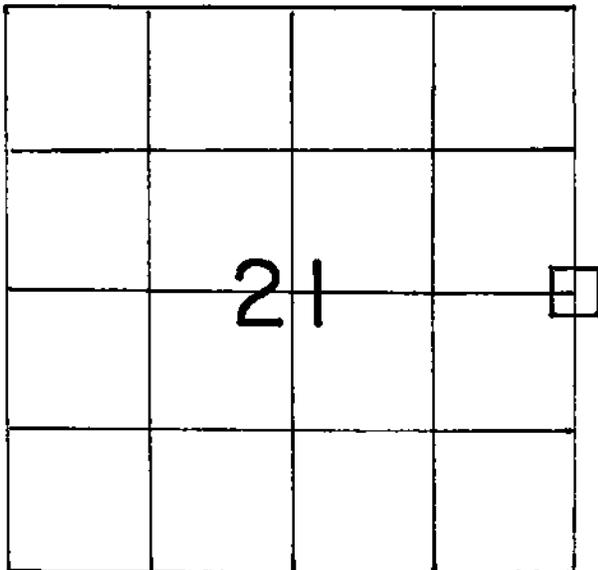

LOCATION OF LANDMARK

Crew: WILLIAM C. JUNG  
PETER F. FOLLANSBEE

Date: 11/15/1993

Describe any record evidence, monument evidence, testimonial evidence or any other material evidence you considered and whether the monument was found or restored through acceptance of an obliterated evidence location.

I've accepted the existing Stone as the best available evidence of the original government corner position.

Describe or show any material discrepancy between the location of the restored corner and that of the corner previously restored or reestablished.

None Known.

## WISCONSIN COORDINATE SYSTEM

North

East

Theta Angle

Horiz. Order

Vert. Order


## TYPE OF LANDMARK

Existing Stone scribed " 1/8 " "

BEARINGS ARE REFERENCED TO

RECORD OF DURABLE WITNESS MONUMENTS  
MAGNETIC

NO	DESCRIPTION	BEARING	DISTANCE
1	Set P.K. Nail in E.-side 5½" Oak	N 17½° W	18.23 Ft.
2	Set P.K. Nail in NW-side 20" Oak	N 45° E	19.81 Ft.
3	Set P.K. Nail in N.-side 9" White Oak	N 70° E	32.20 Ft.
4	Set P.K. Nail in NE-side 15" White Oak	S 26° E	55.03 Ft.

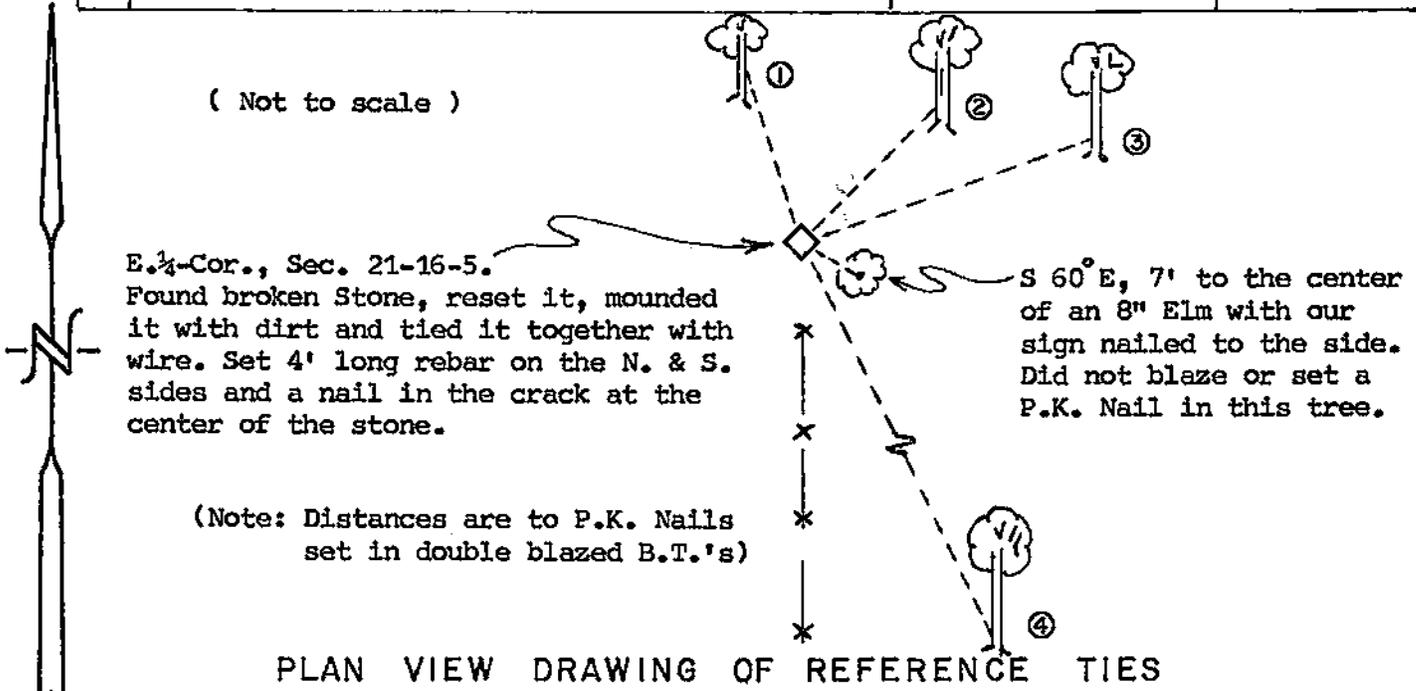


MAP SHOWING DISTANCE AND DIRECTION TO OTHER PUBLIC LAND SURVEY CORNERS USED FOR REESTABLISHING THE CORNER

No section measurements were made by me at this time.

I, William C. Jung, County Surveyor  
HEREBY CERTIFY THAT THE CORNER LOCATION SHOWN ON THIS RECORD WAS DETERMINED BY ME OR UNDER MY DIRECTION AND CONTROL AND THAT THIS U. S. PUBLIC LAND SURVEY MONUMENT RECORD IS CORRECT AND COMPLETE TO THE BEST OF MY KNOWLEDGE AND BELIEF.

William C. Jung  
Signature

12/23/93  
Date

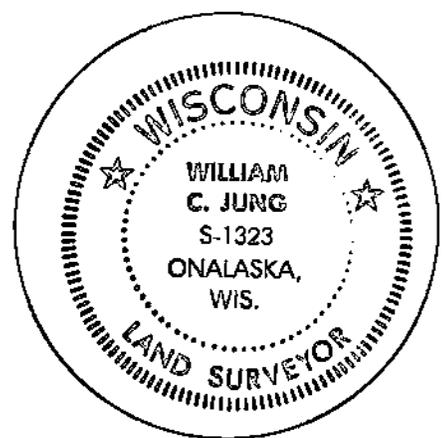

Seal