


21605220000

U. S. PUBLIC LAND SURVEY MONUMENT RECORD

SECTION 27 T 16 N, R 5 W, TOWN OF BANGOR
 LA CROSSE COUNTY

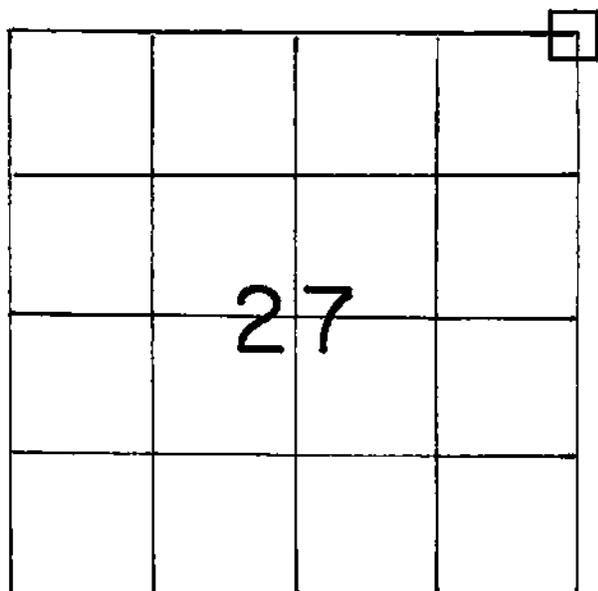

LOCATION OF LANDMARK

WISCONSIN COORDINATE SYSTEM
North
East
Theta Angle
Horiz. Order
Vert. Order
TYPE OF LANDMARK
Existing 6" square Stone.
BEARINGS ARE REFERENCED TO

Crew: WILLIAM C. JUNG
 PETER F. FOLLANSBEE

Date: 11/04/1993

Describe any record evidence, monument evidence, testimonial evidence or any other material evidence you considered and whether the monument was found or restored through acceptance of an obliterated evidence location.


I've accepted the existing Stone as the best available evidence of the original government corner location.

Describe or show any material discrepancy between the location of the restored corner and that of the corner previously restored or reestablished.

None Known.

RECORD OF DURABLE WITNESS MONUMENTS

NO	DESCRIPTION	MAGNETIC BEARING	DISTANCE
1	Set P.K. Nail in SW-side double Popple	N 02° E	13.95 Ft.
2	Set P.K. Nail in NE-side 14" Oak	S 11° E	Sl.=37.80'
3	Set P.K. Nail in NE-side 18" Oak	S 33° E	34.55 Ft.
4	Set P.K. Nail in NE-side 8" Burr Oak	S 55° E	30.65 Ft.

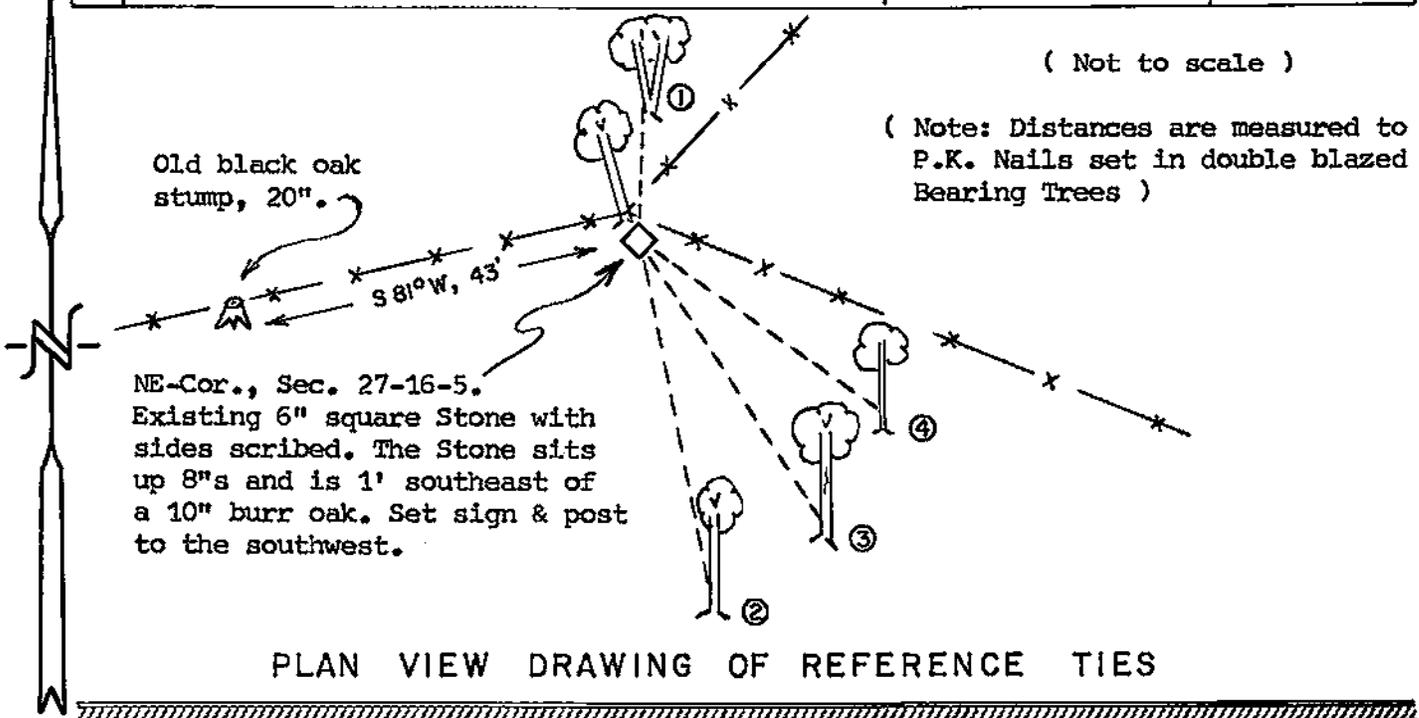


MAP SHOWING DISTANCE AND DIRECTION TO OTHER PUBLIC LAND SURVEY CORNERS USED FOR REESTABLISHING THE CORNER

No section measurements made by me at this time.

I, William C. Jung, County Surveyor
 HEREBY CERTIFY THAT THE CORNER LOCATION SHOWN ON THIS RECORD
 WAS DETERMINED BY ME OR UNDER MY DIRECTION AND CONTROL AND
 THAT THIS U. S. PUBLIC LAND SURVEY MONUMENT RECORD IS CORRECT
 AND COMPLETE TO THE BEST OF MY KNOWLEDGE AND BELIEF.

William C. Jung
 Signature

12/23/93
 Date

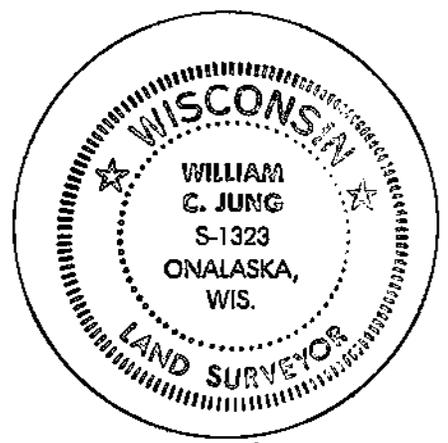

Seal