


## U. S. PUBLIC LAND SURVEY MONUMENT RECORD

SECTION 22 T 16 N, R 5 W, TOWN OF BANGOR

LA CROSSE COUNTY

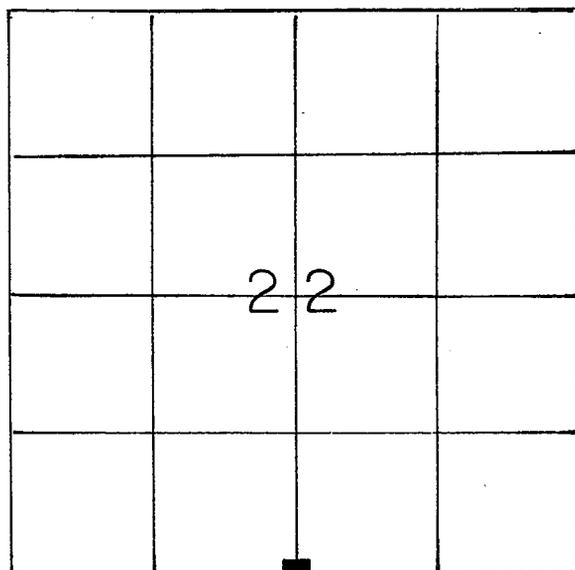

LOCATION OF LANDMARK

Crew: William Jung  
Perry Dahl  
3/21/86

WISCONSIN COORDINATE SYSTEM
North
East
Theta Angle
Horiz. Order
Vert. Order
TYPE OF LANDMARK
Stone
BEARINGS ARE REFERENCED TO

Crew: William C. Jung  
Peter F. Follansbee  
11/15/93

Describe any record evidence, monument evidence, testimonial evidence or any other material evidence you considered and whether the monument was found or restored through acceptance of an obliterated evidence location.

We found a stone at the corner which I accepted as the best available evidence of the original government corner position.



Describe or show any material discrepancy between the location of the restored corner and that of the corner previously restored or reestablished.

None known.

RECORD OF DURABLE WITNESS MONUMENTS  
MAGNETIC

NO	DESCRIPTION	BEARING	DISTANCE	
1	<del>P.K.</del> concrete nail in double blazed 13" oak	N76°W	<del>23.66</del>	slope = 25.45
2	P.K. nail in double blazed 4" hickory	N27°E	<del>6.10</del>	5.85
3	P.K. nail in double blazed 13" oak	S 7°E	35.40	slope
4	P.K. nail in double blazed 10" oak	S17°W	<del>27.38</del>	27.33

(All P.K. nails are in hacks.)

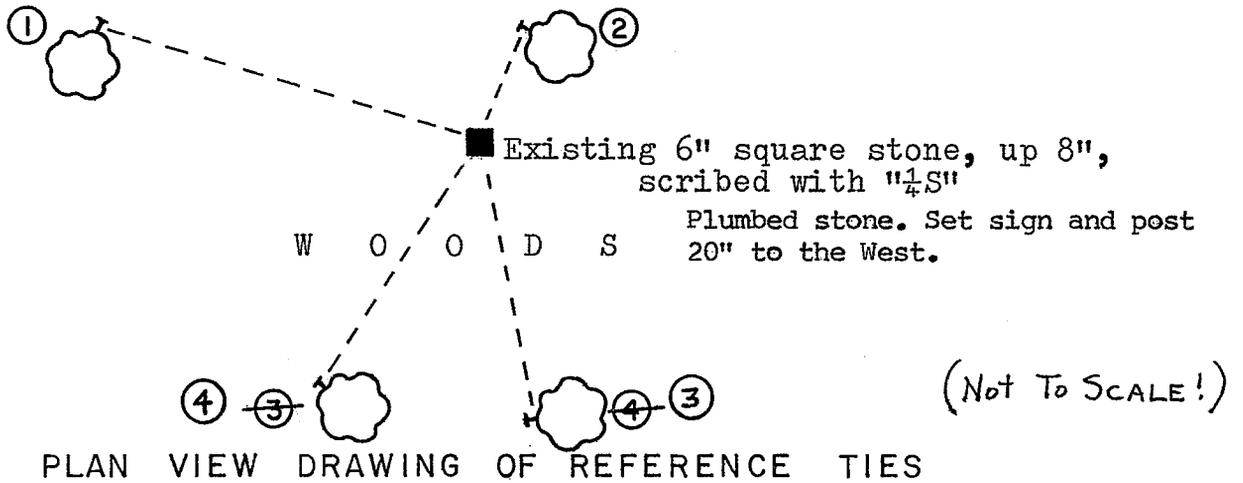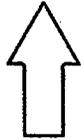

MAP SHOWING DISTANCE AND DIRECTION TO OTHER PUBLIC LAND SURVEY CORNERS USED FOR REESTABLISHING THE CORNER

No measurements made by me at this time.

I, William C. Jung, Deputy County Surveyor,  
HEREBY CERTIFY THAT THE CORNER LOCATION SHOWN ON THIS RECORD  
WAS DETERMINED BY ME OR UNDER MY DIRECTION AND CONTROL AND  
THAT THIS U. S. PUBLIC LAND SURVEY MONUMENT RECORD IS CORRECT  
AND COMPLETE TO THE BEST OF MY KNOWLEDGE AND BELIEF.

William C. Jung  
Signature

4/15/86  
Date

Revised: 12/23/93

*w.e.j.*



Seal