

21605222000


---

 U. S. PUBLIC LAND SURVEY MOUMENT RECORD
 

---

 SECTION 22, T.16N., R.5W., TOWN OF BANGOR,  
 LACROSSE COUNTY, WISCONSIN
 

---

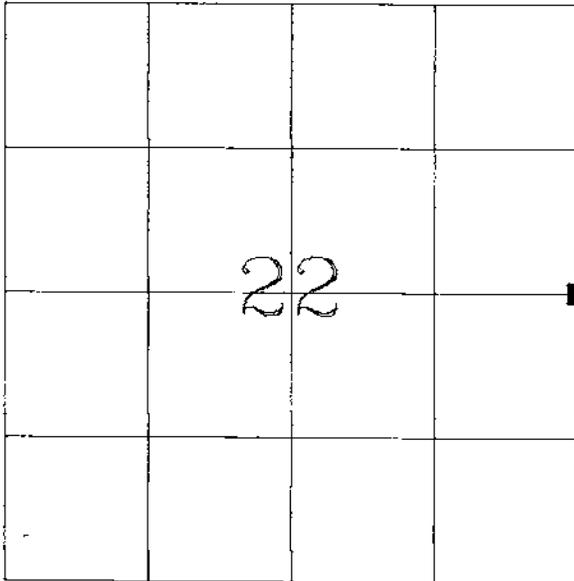

WISCONSIN COORDINATE SYSTEM	
North	N/A
East	N/A
Theta Angle	N/A
Horiz. Order	N/A
Vert. Order	N/A
TYPE OF LANDMARK: 6" X 6" Limestone with 'X' on top and 1/4S on the side.	
BEARINGS ARE REFERENCED TO:  Assumed	

## LOCATION OF LANDMARK

Crew: Rodney H. Maxwell  
 Dwayne M. Hefner  
 Laurence E. Johns III

Date: 1 August 1998

Describe any record evidence, monument evidence, testimonial evidence or any other material evidence you considered and whether the monument was found or restored through acceptance of an obliterated evidence location.

Found a 6 X 6 Limestone with an 'X' marked on top and 1/4S on side. The top 6" was split in vertical layers I put the stone together on the base(still in place) and placed a mound of stones around it from the nearby creek bed. This is the same type stone as found at the other corners in this Section. The location fit well U.S.G.S. Map location. No measurements made at this time to North & South.


Describe or show any material discrepancy between the location of the restored corner and that of the corner previously restored or reestablished.

No known record of corner being restored since original government survey. Although, this same type of stone is at all other corners in this Section.

# RECORD OF DURABLE WITNESS MONUMENTS


NO.	DESCRIPTION	BEARING	DISTANCE
1	4" Elm	N 70° W	10.0'
2	12" Elm	N 40° E	9.0'
3	3" Elm	N 85° E	3.0'
4	10" Elm	S 85° E	18.0'

\*\* All trees double blazed with  
MAG Nail in lower hack.

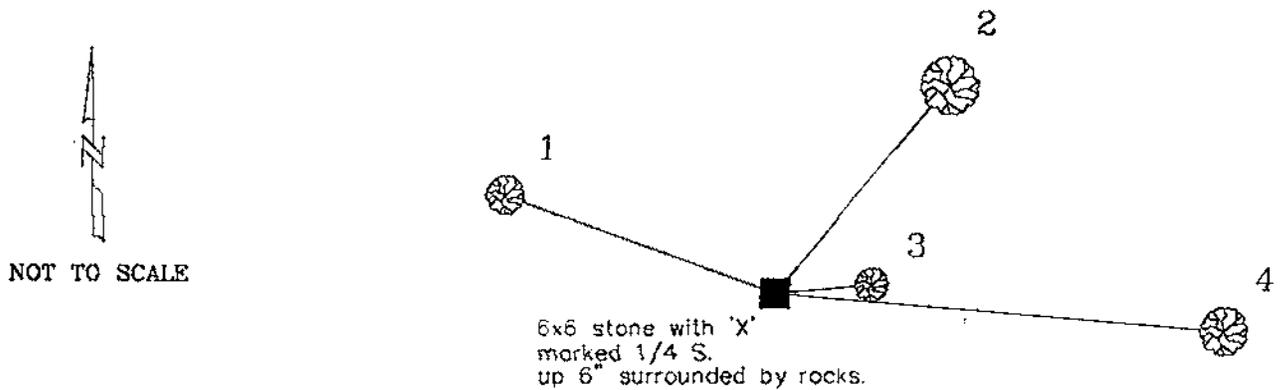

## PLAN VIEW DRAWING OF REFERENCE TIES


MAP SHOWING DISTANCE AND DIRECTION TO OTHER PUBLIC LAND SURVEY  
CORNERS USED FOR REESTABLISHING THE CORNER

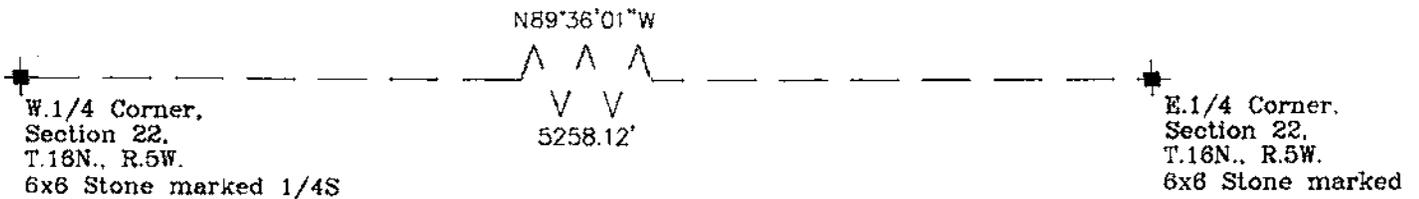

I, RODNEY H. MAXWELL, REGISTERED LAND SURVEYOR, HEREBY CERTIFY THAT THE CORNER LOCATION SHOWN ON THIS RECORD WAS DETERMINED BY ME OR UNDER MY DIRECTION AND CONTROL, AND THAT THIS U. S. PUBLIC LAND SURVEY MONUMENT RECORD IS CORRECT AND COMPLETE TO THE BEST OF MY KNOWLEDGE AND BELIEF.

*Rodney H. Maxwell*

Rodney H. Maxwell  
Maxwell Surveying  
7457 Highway 16, Suite C  
Sparta, Wisconsin  
1 September, 1998

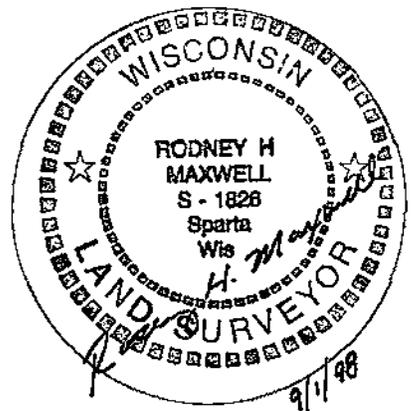

SEAL