


21605230000

U. S. PUBLIC LAND SURVEY MONUMENT RECORD

SECTION 25 T 16 N, R 5 W, TOWN OF BANGOR

LA CROSSE COUNTY

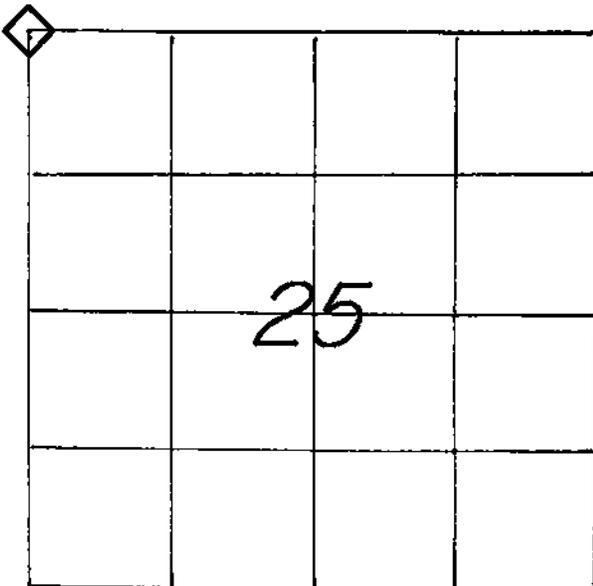

WISCONSIN COORDINATE SYSTEM

North 672,530.350

East 1,722,933.788

Theta Angle

Horiz. Order

Vert. Order

DATUM: 83 ('91)

TYPE OF LANDMARK

6" SQUARE x 33" SCRIBED STONE.

BEARINGS ARE REFERENCED TO
GRID NORTH AS PER SECTION DATA.

LOCATION OF LANDMARK

CREW: WILLIAM C. JUNG
PETER F. FOLLANSBEE

DATE: 11/10/2000

Describe any record evidence, monument evidence, testimonial evidence or any other material evidence you considered and whether the monument was found or restored through acceptance of an obliterated evidence location.


In 1867 Bliss set a stone at this corner. We found the complete stone laying on its side on the hillside. Did time, erosion, and frost bring the stone to a point where it fell over, or fell over and roll^{ed} down the hill? Or did the stone get to that point and was then knocked down the hill during logging operations? We could not tell.

There being no other evidence to assist us, I computed out the corner using double proportionate measurement. I reset the existing stone at the computed location. Describe or show any material discrepancy between the location of the restored corner and that of the corner previously restored or reestablished.

NONE KNOWN.

RECORD OF DURABLE WITNESS MONUMENTS
MAGNETIC


NO	DESCRIPTION	BEARING	DISTANCE
1	SET A NAIL IN THE E.-SIDE OF AN 11" OAK	N 20° W	18.09 FT.
2	SET A NAIL IN THE S.-SIDE OF A 12" OAK	N 85° E	33.20 FT.
3	SET A NAIL IN THE E.-SIDE OF A 13-1/2" OAK	S 11° W	20.53 FT.
4	SET A NAIL IN THE E.-SIDE OF AN 11-1/2" OAK	S 49° W	22.93 FT.

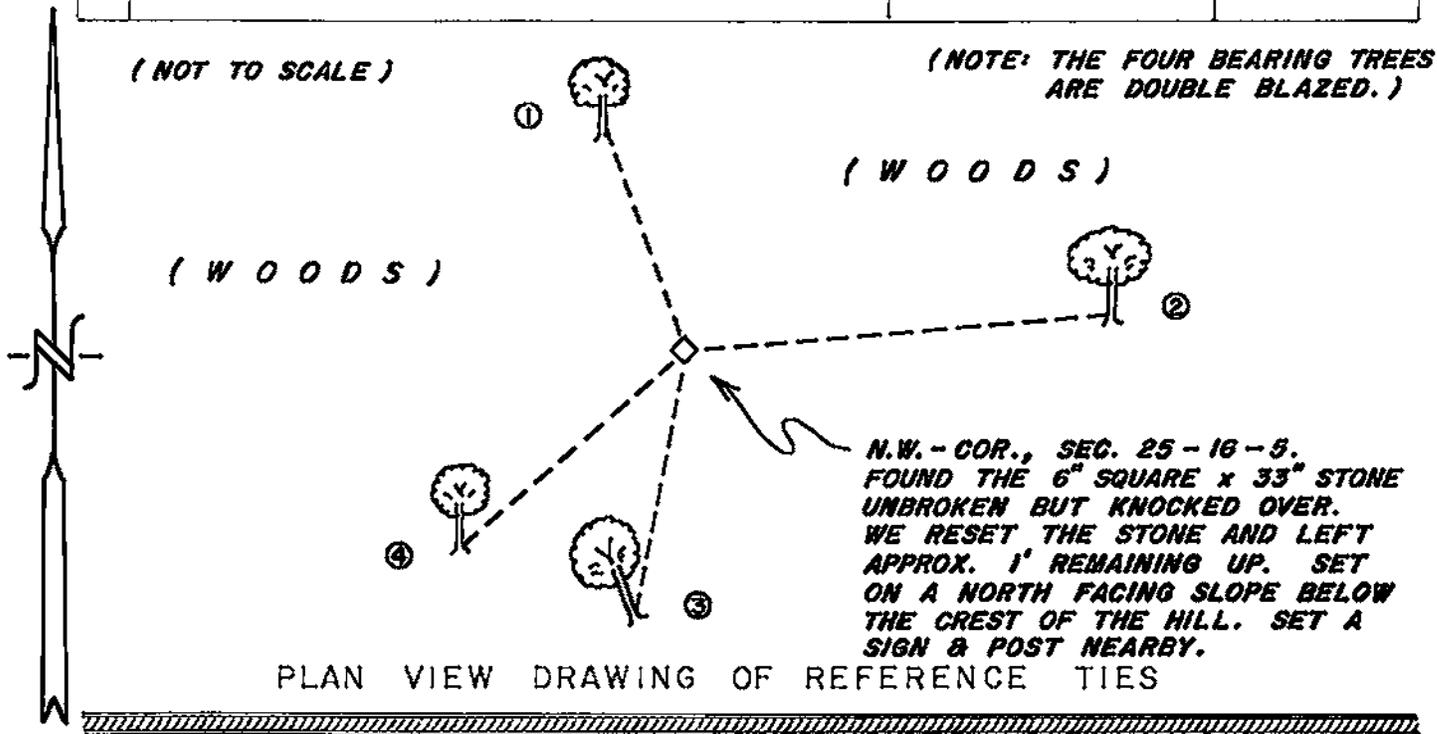

MAP SHOWING DISTANCE AND DIRECTION TO OTHER PUBLIC LAND SURVEY CORNERS USED FOR REESTABLISHING THE CORNER

(GRID BEARINGS AND DISTANCES)


(not to scale)

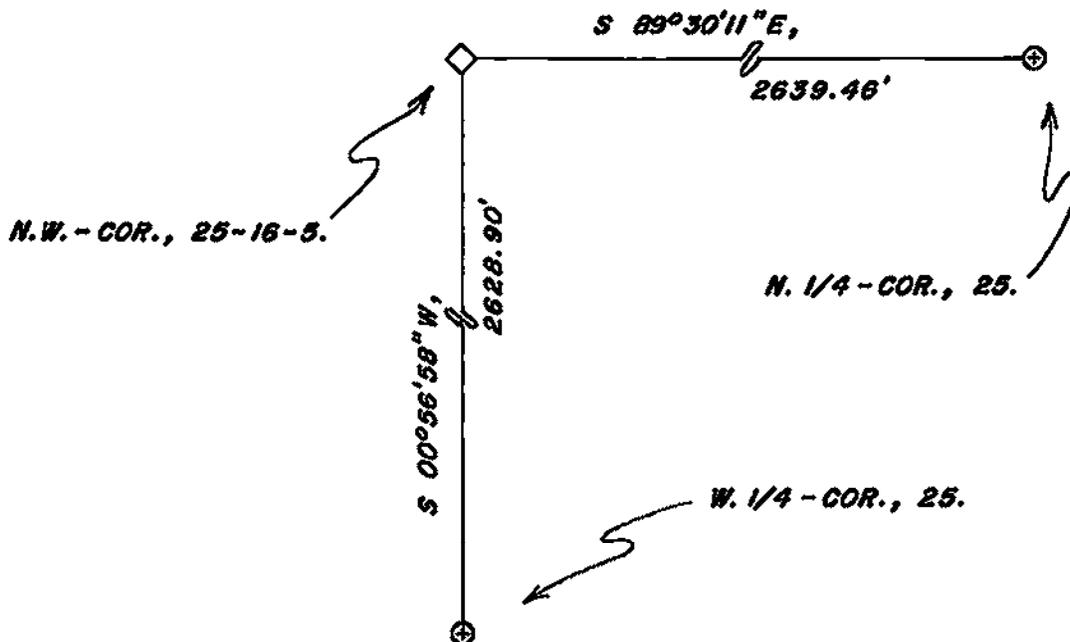

I, WILLIAM C. JUNG, COUNTY SURVEYOR
HEREBY CERTIFY THAT THE CORNER LOCATION SHOWN ON THIS RECORD WAS DETERMINED BY ME OR UNDER MY DIRECTION AND CONTROL AND THAT THIS U. S. PUBLIC LAND SURVEY MONUMENT RECORD IS CORRECT AND COMPLETE TO THE BEST OF MY KNOWLEDGE AND BELIEF.

William C. Jung
Signature

11/21/00
Date

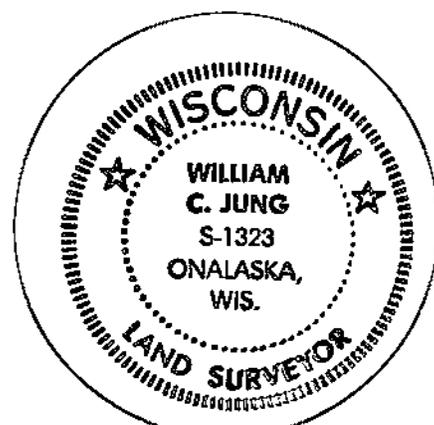

Seal