


21605240020

U. S. PUBLIC LAND SURVEY MONUMENT RECORD

SECTION 24 T 16 N, R 5 W, TOWN OF BANGOR

LA CROSSE COUNTY

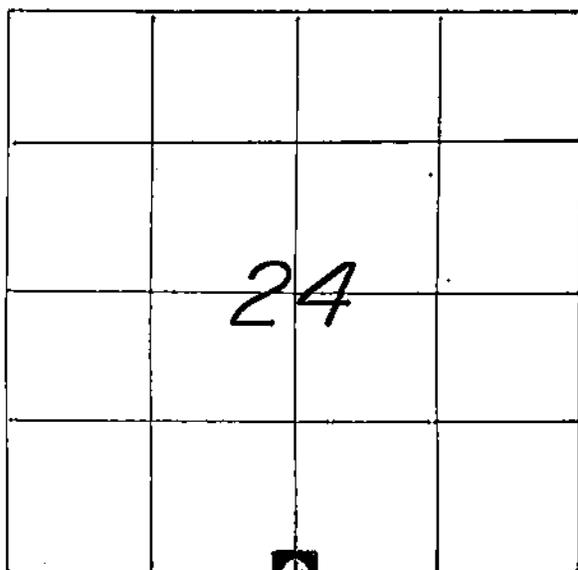

LOCATION OF LANDMARK

CREW: WILLIAM C. JUNG
 PETER F. FOLLANSBEE
 DATE: 10/16/2000

WISCONSIN COORDINATE SYSTEM	
North	672,515.456
East	1,725,573.145
Theta Angle	
Horiz. Order	
Vert. Order	
DATUM:	83 ('91)
TYPE OF LANDMARK	
3/4" x 30" IRON BAR WITH AN ALUMINUM CAP.	
BEARINGS ARE REFERENCED TO	
GRID NORTH AS PER SECTION DATA.	

Describe any record evidence, monument evidence, testimonial evidence or any other material evidence you considered and whether the monument was found or restored through acceptance of an obliterated evidence location.


I found Bliss' 1867 stone broken into pieces. I set an iron bar with cap in the middle of the old broken monument.

Describe or show any material discrepancy between the location of the restored corner and that of the corner previously restored or reestablished.

NONE KNOWN.

RECORD OF DURABLE WITNESS MONUMENTS
MAGNETIC


NO	DESCRIPTION	BEARING	DISTANCE
1	SET A NAIL IN S.-SIDE OF A 7" MAPLE	N 36° W	34.42 FT.
2	SET A NAIL IN W.-SIDE OF A 12-1/2" OAK	S 45° E	31.38 FT.
3	SET A NAIL IN W.-SIDE OF A 4-1/4" HICKORY	S 20° W	8.37 FT.
4	SET A NAIL IN W.-SIDE OF AN 8-1/2" WHITE OAK DOUBLE	S 42° W	20.06 FT.

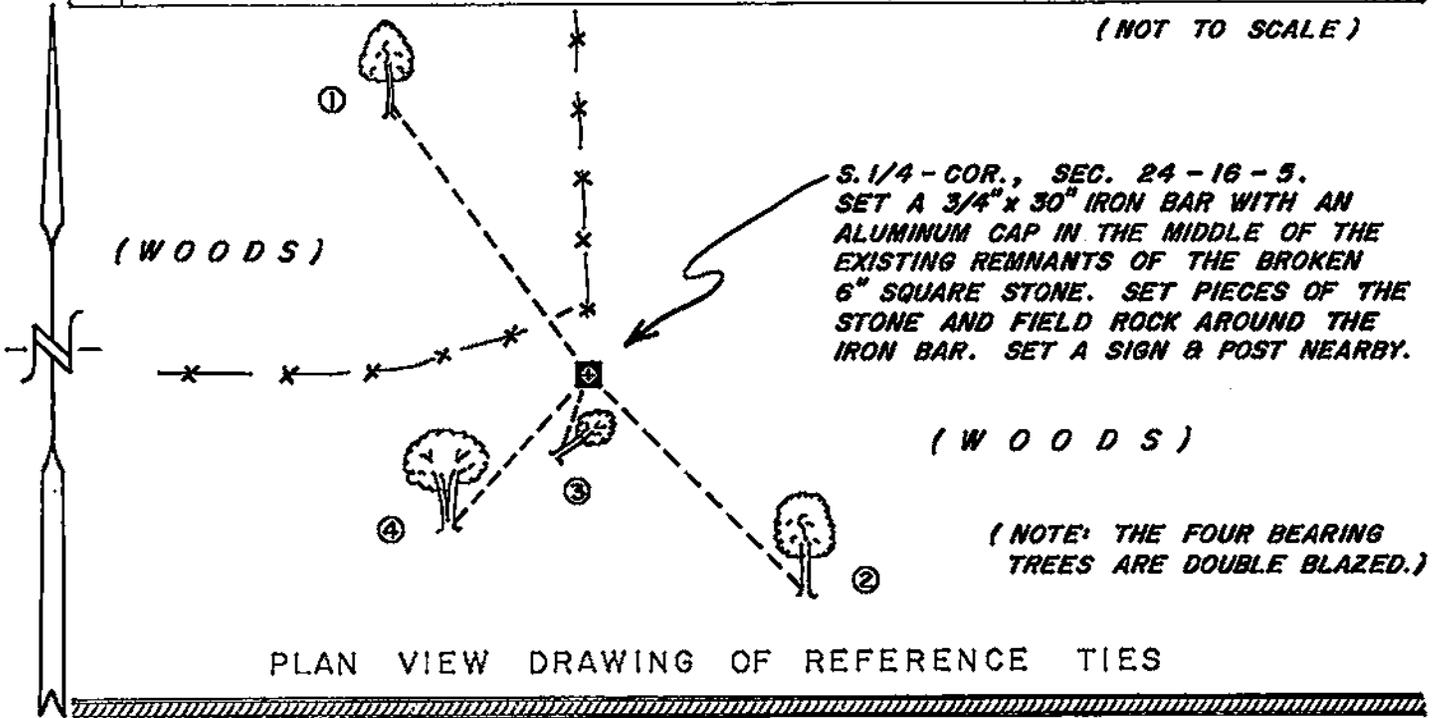

MAP SHOWING DISTANCE AND DIRECTION TO OTHER PUBLIC LAND SURVEY CORNERS USED FOR REESTABLISHING THE CORNER

(GRID BEARINGS & DISTANCES)

(not to scale)

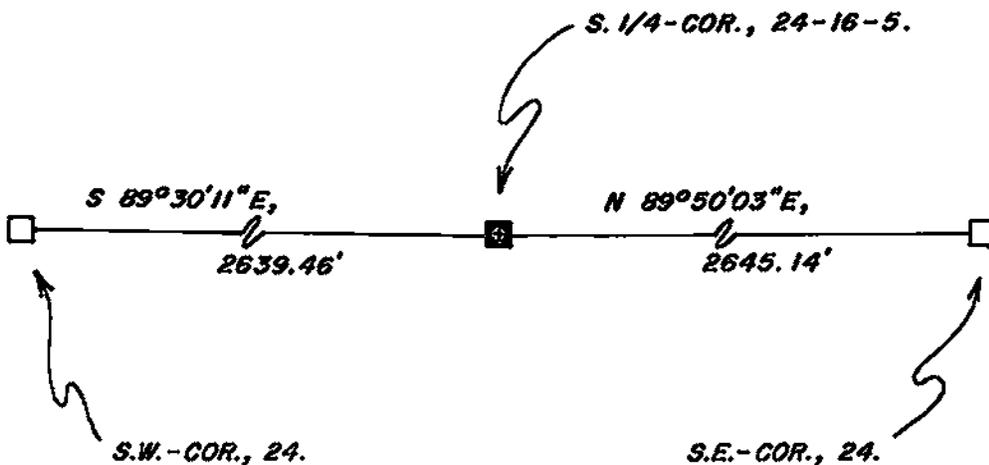

I, WILLIAM C. JUNG, COUNTY SURVEYOR
HEREBY CERTIFY THAT THE CORNER LOCATION SHOWN ON THIS RECORD WAS DETERMINED BY ME OR UNDER MY DIRECTION AND CONTROL AND THAT THIS U. S. PUBLIC LAND SURVEY MONUMENT RECORD IS CORRECT AND COMPLETE TO THE BEST OF MY KNOWLEDGE AND BELIEF.

William C. Jung 11/16/00
Signature Date



Seal