


21605260020

U. S. PUBLIC LAND SURVEY MONUMENT RECORD

SECTION 26 T 16 N, R 5 W, TOWN OF BANGOR
 LA CROSSE COUNTY

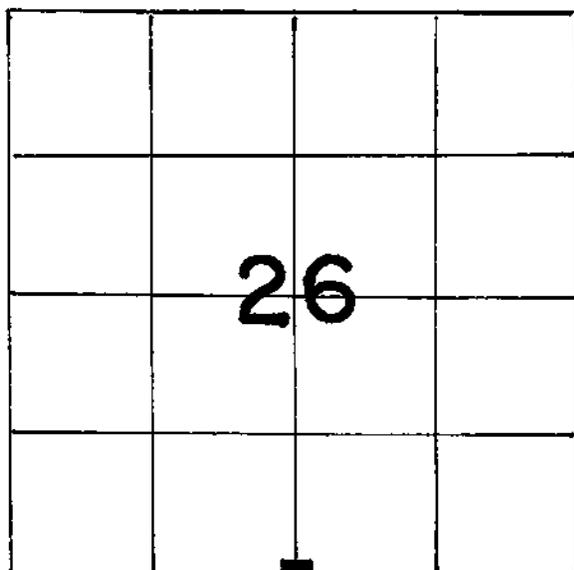

LOCATION OF LANDMARK

Crew: William Jung
 Perry Dahl
 8/26/85

Describe any record evidence, monument evidence, testimonial evidence or any other material evidence you considered and whether the monument was found or restored through acceptance of an obliterated evidence location.

George Bradish, Deputy County Surveyor, was at this corner in October of 1877. We found a stone at the occupied corner which I accepted as the best available evidence of the original government corner position.

Describe or show any material discrepancy between the location of the restored corner and that of the corner previously restored or reestablished.

None known.

WISCONSIN COORDINATE SYSTEM

North

East

Theta Angle

Horiz. Order

Vert. Order


TYPE OF LANDMARK

STONE MONUMENT (up 1.5')

BEARINGS ARE REFERENCED TO

RECORD OF DURABLE WITNESS MONUMENTS
MAGNETIC

NO	DESCRIPTION	BEARING	DISTANCE
1	P.K. NAIL IN 12" DOUBLE-BLAZED OAK TREE	S85°W	38.12'
3	P.K. NAIL IN 9" DOUBLE-BLAZED OAK TREE	S13°W	24.9'
2	P.K. NAIL IN 8" DOUBLE-BLAZED OAK TREE	S5°E	10.19'
4	P.K. NAIL IN 8" DOUBLE-BLAZED OAK TREE	S76°E	36.59'

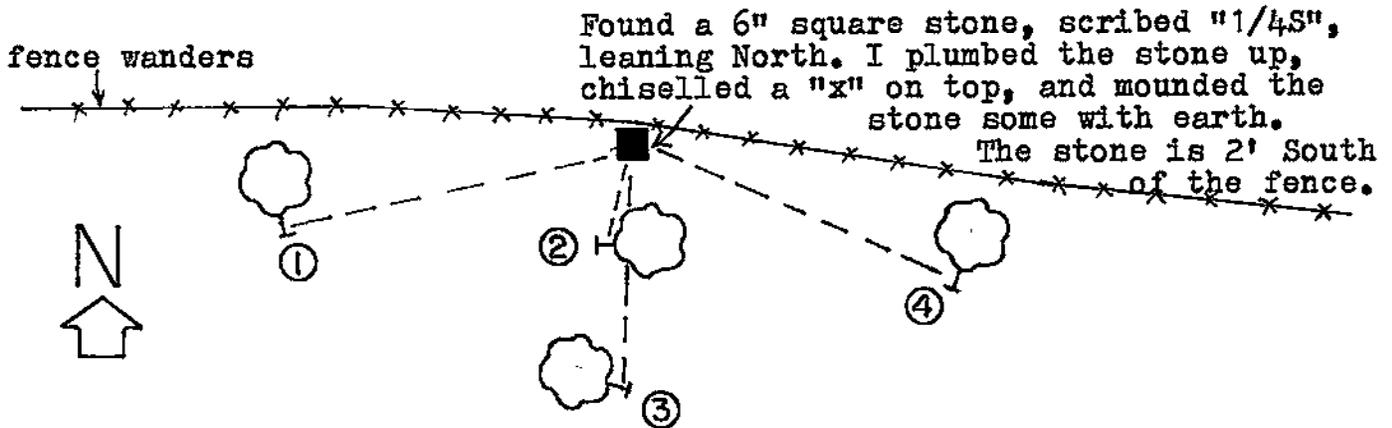

(Each distance is to a P.K. nail in a hack on the side of a tree.)

PLAN VIEW DRAWING OF REFERENCE TIES


MAP SHOWING DISTANCE AND DIRECTION TO OTHER PUBLIC LAND SURVEY CORNERS USED FOR REESTABLISHING THE CORNER

No measurements made by me at this time.

I, William C. Jung, Deputy County Surveyor,
HEREBY CERTIFY THAT THE CORNER LOCATION SHOWN ON THIS RECORD
WAS DETERMINED BY ME OR UNDER MY DIRECTION AND CONTROL AND
THAT THIS U. S. PUBLIC LAND SURVEY MONUMENT RECORD IS CORRECT
AND COMPLETE TO THE BEST OF MY KNOWLEDGE AND BELIEF.

William C. Jung
Signature

3/19/86
Date

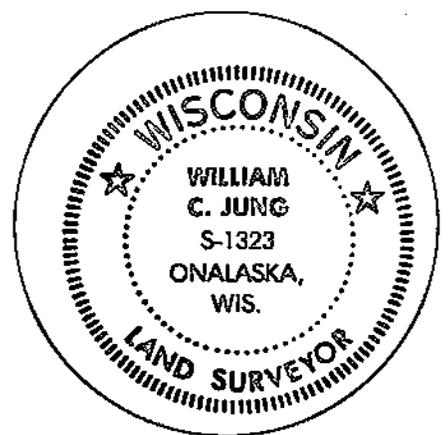

Seal