


U. S. PUBLIC LAND SURVEY MONUMENT RECORD

SECTION 26 T 16 N, R 5 W, TOWN OF BANGOR
 LA CROSSE COUNTY

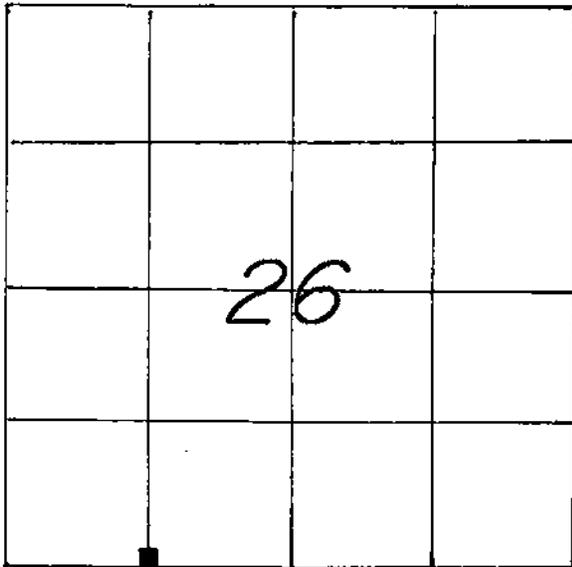

LOCATION OF LANDMARK

CREW: WILLIAM C. JUNG
 PETER F. FOLLANSBEE
 DATE: 7/31/1997

Date: 6/29/00

Describe any record evidence, monument evidence, testimonial evidence or any other material evidence you considered and whether the monument was found or restored through acceptance of an obliterated evidence location.

I found what I believe to be Bradish's stone from 1877.


Describe or show any material discrepancy between the location of the restored corner and that of the corner previously restored or reestablished.

None known.

WISCONSIN COORDINATE SYSTEM	
North	667,292.200
East	1,718,926.529
Theta Angle	
Horiz. Order	
Vert. Order	
DATUM:	83 ('91)
TYPE OF LANDMARK	
3" X 1' X 3' FIELDSTONE	
BEARINGS ARE REFERENCED TO	
Grid North	

RECORD OF DURABLE WITNESS MONUMENTS


NO	DESCRIPTION	BEARING	DISTANCE
1	SET A NAIL IN THE S.E.-SIDE 18" OAK (DOUBLE BLAZED)	S' WESTERLY ±	22.33 FT.
2	SET A NAIL IN THE S.-SIDE 10" W. OAK (UNBLAZED)	WEST ±	1.85 FT
3	SET A NAIL IN THE N.E.-SIDE 15" W. OAK (DOUBLE BLAZED)	S' EASTERLY ±	38.78 FT.
4	SET A NAIL IN THE N.W.-SIDE 4-1/2" HICKORY (DBL. BLAZED)	SOUTHERLY	16.14 FT.

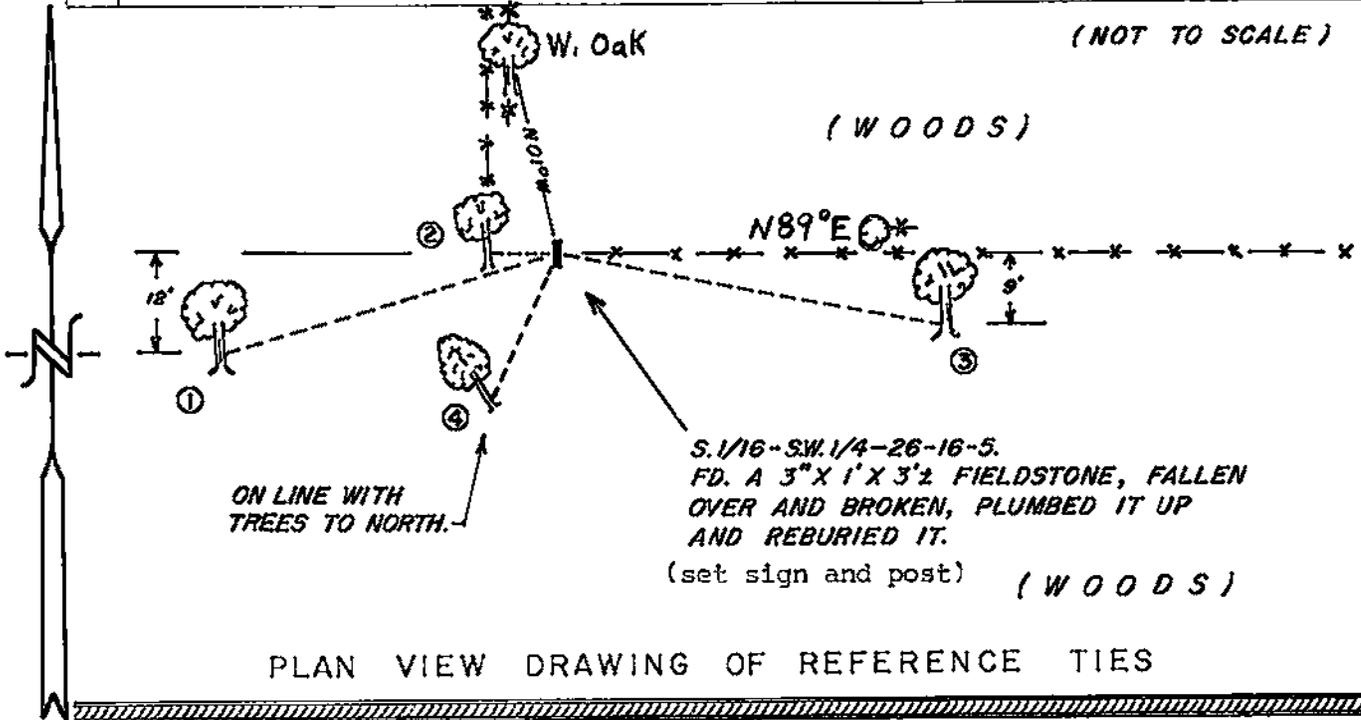

MAP SHOWING DISTANCE AND DIRECTION TO OTHER PUBLIC LAND SURVEY CORNERS USED FOR REESTABLISHING THE CORNER

(GRID BEARINGS AND GRID DISTANCES)

(not to scale)

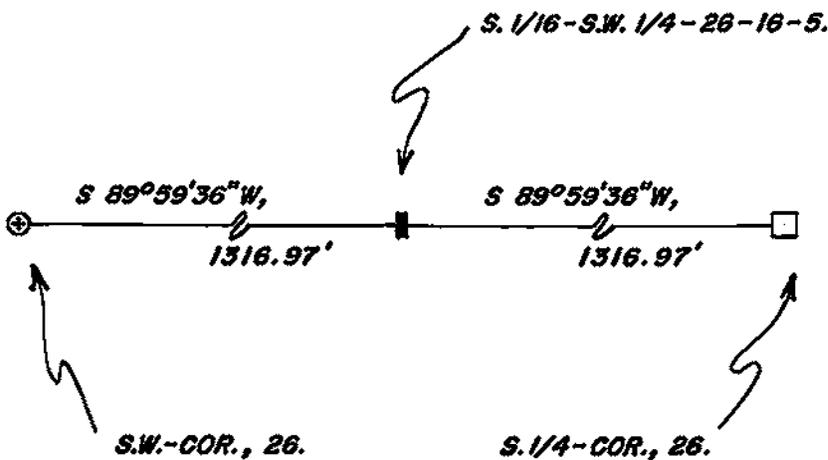

I, WILLIAM C. JUNG, COUNTY SURVEYOR
 HEREBY CERTIFY THAT THE CORNER LOCATION SHOWN ON THIS RECORD
 WAS DETERMINED BY ME OR UNDER MY DIRECTION AND CONTROL AND
 THAT THIS U. S. PUBLIC LAND SURVEY MONUMENT RECORD IS CORRECT
 AND COMPLETE TO THE BEST OF MY KNOWLEDGE AND BELIEF.

William C. Jung
 Signature

1/7/98
 Date

Revised: 11/17/00 *awj*



Seal