


21605262000

## U. S. PUBLIC LAND SURVEY MONUMENT RECORD

SECTION 26 T 16 N, R 5 W, TOWN OF BANGOR

LA CROSSE COUNTY

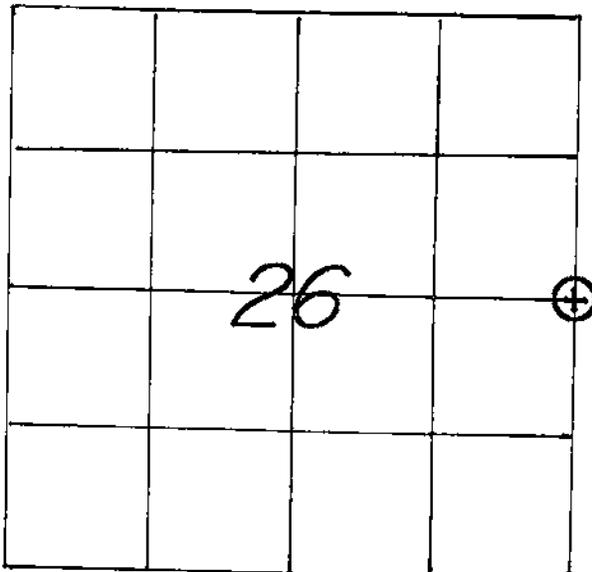

## WISCONSIN COORDINATE SYSTEM

North 669,909.807

East 1,722,890.237

Theta Angle

Horiz. Order

Vert. Order

DATUM: 83 ('91)

TYPE OF LANDMARK

3/4" x 30" IRON BAR WITH AN ALUMINUM CAP.

BEARINGS ARE REFERENCED TO  
GRID NORTH AS PER SECTION DATA.

## LOCATION OF LANDMARK

CREW: WILLIAM C. JUNG  
PETER F. FOLLANSBEE

DATE: 11/03/2000

Describe any record evidence, monument evidence, testimonial evidence or any other material evidence you considered and whether the monument was found or restored through acceptance of an obliterated evidence location.


I set this corner on line between the section corners and in the oldest of the (3) East-West fences. After analyzing the field evidence, our section data, the original government notes, and Bradish's 1877 survey, I feel that this is the best way to set this corner. We searched at great length for Bliss' 1867 stone but could not find it.

Describe or show any material discrepancy between the location of the restored corner and that of the corner previously restored or reestablished.

**NONE KNOWN.**

RECORD OF DURABLE WITNESS MONUMENTS


NO	DESCRIPTION	BEARING	DISTANCE
1	SET A NAIL IN THE N.E.-SIDE OF A 40" WHITE OAK	WEST ±	12.02 FT.
2	SET A 3/4" x 30" IRON BAR DOWN 10" NEAR THE FIELD	NORTH ±	15.01 FT.
3	SET A NAIL IN THE N.W.-SIDE OF A TRIPLE BOX ELDER	EAST ±	6.02 FT.
4	SET A 3/4" x 30" IRON BAR DOWN 10" NEAR THE FIELD	SOUTH ±	14.93 FT.

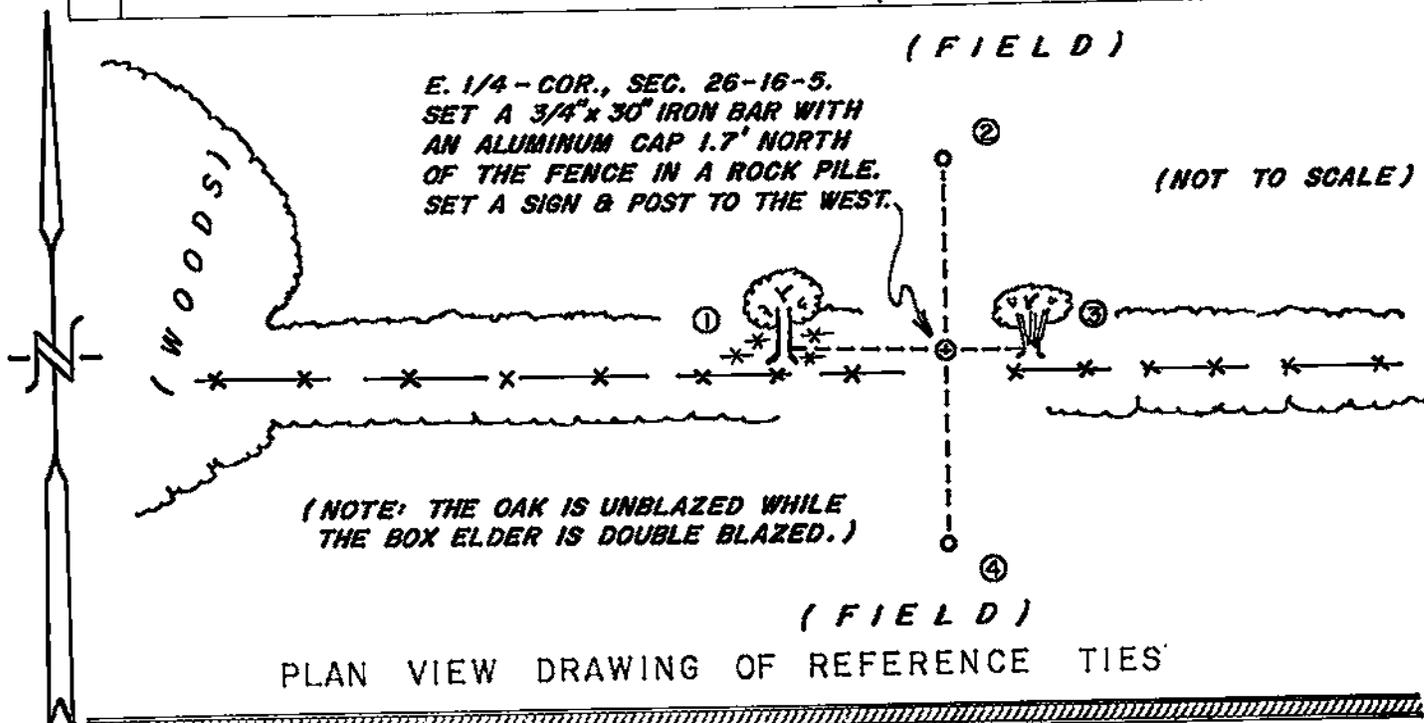

MAP SHOWING DISTANCE AND DIRECTION TO OTHER PUBLIC LAND SURVEY CORNERS USED FOR REESTABLISHING THE CORNER


(GRID BEARINGS AND GRID DISTANCES)

(not to scale)

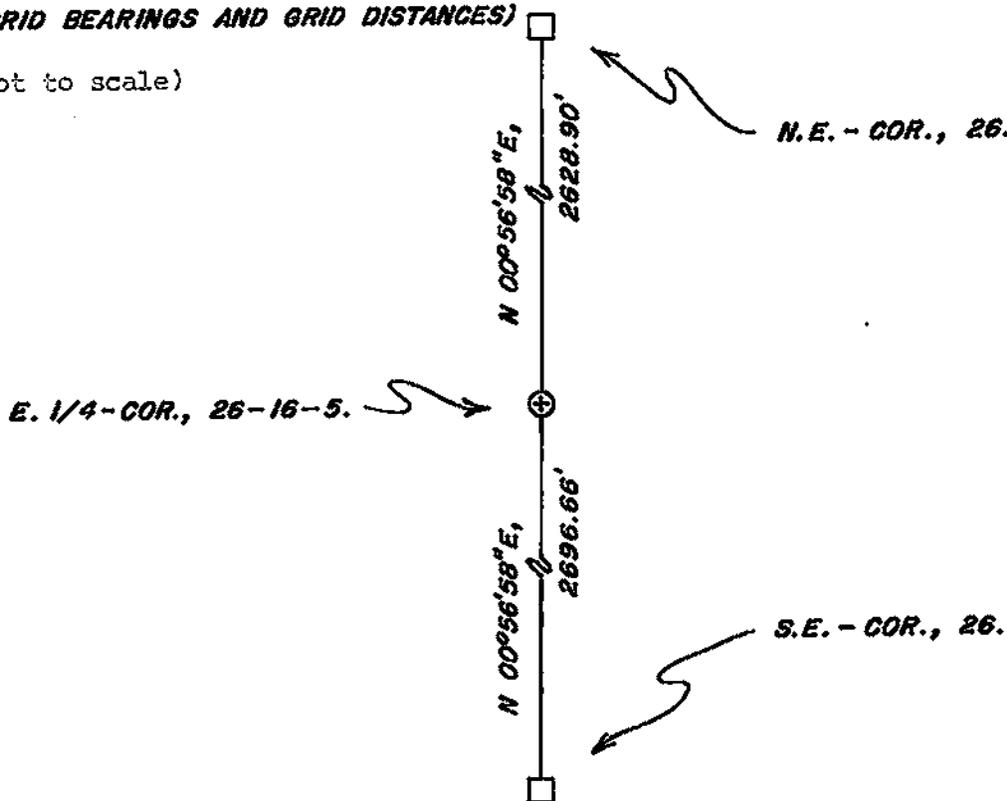

I, WILLIAM C. JUNG, COUNTY SURVEYOR  
 HEREBY CERTIFY THAT THE CORNER LOCATION SHOWN ON THIS RECORD  
 WAS DETERMINED BY ME OR UNDER MY DIRECTION AND CONTROL AND  
 THAT THIS U. S. PUBLIC LAND SURVEY MONUMENT RECORD IS CORRECT  
 AND COMPLETE TO THE BEST OF MY KNOWLEDGE AND BELIEF.

William C. Jung 11/17/00  
 Signature Date

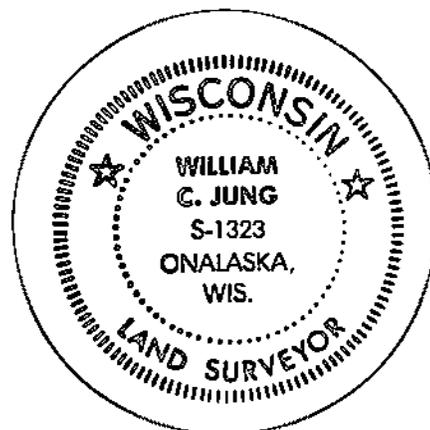

Seal