


21605262020

## U. S. PUBLIC LAND SURVEY MONUMENT RECORD

SECTION 26 T 16 N, R 5 W, TOWN OF BANGOR

LA CROSSE COUNTY

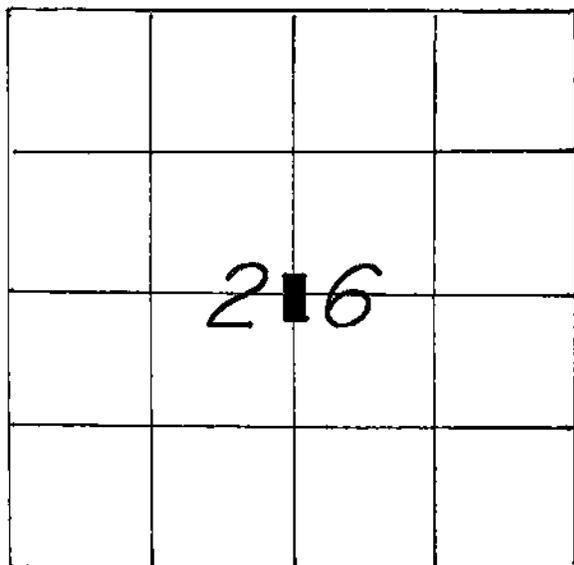

LOCATION OF LANDMARK

CREW: **WILLIAM C. JUNG**  
**PETER F. FOLLANSBEE**  
 DATE: **10/24/2000**

## WISCONSIN COORDINATE SYSTEM

North **669,937.726**East **1,720,271.141**

Theta Angle

Horiz. Order

Vert. Order

DATUM: **83('91)**

TYPE OF LANDMARK  
**4" x 10" FIELD STONE.**

BEARINGS ARE REFERENCED TO  
**GRID NORTH AS PER SECTION DATA.**

Describe any record evidence, monument evidence, testimonial evidence or any other material evidence you considered and whether the monument was found or restored through acceptance of an obliterated evidence location.

I found what I believe to be the stone set at the Center 1/4 Corner by Bradish in 1877.

Describe or show any material discrepancy between the location of the restored corner and that of the corner previously restored or reestablished.

**NONE KNOWN.**

