


21605270000

U. S. PUBLIC LAND SURVEY MONUMENT RECORD

SECTION 26 T 16 N, R 5 W, TOWN OF BANGOR

LA CROSSE COUNTY

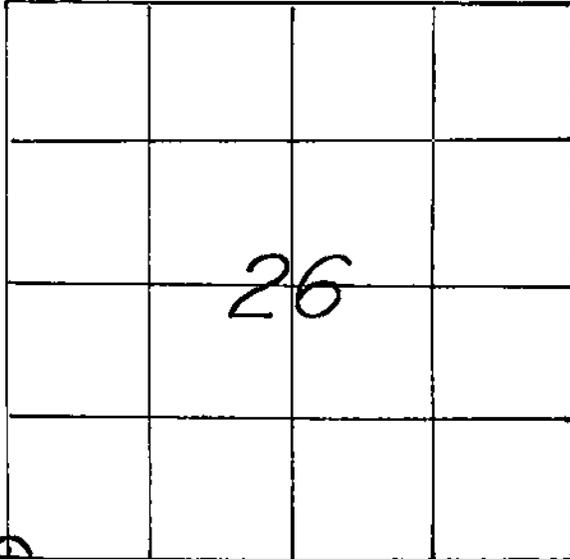

LOCATION OF LANDMARK

CREW: WILLIAM C. JUNG
 PETER F. FOLLANSBEE
 DATE: 10/17/2000

WISCONSIN COORDINATE SYSTEM

North 667,292.047

East 1,717,609.559

Theta Angle

Horiz. Order

Vert. Order

DATUM: 83('91)

TYPE OF LANDMARK

3/4" x 30" IRON BAR WITH AN ALUMINUM CAP

BEARINGS ARE REFERENCED TO
 GRID NORTH AS PER SECTION DATA.

Describe any record evidence, monument evidence, testimonial evidence or any other material evidence you considered and whether the monument was found or restored through acceptance of an obliterated evidence location.


This corner was set on line with the stones at the S1/16SW and S1/4 corners and at a distance from the S1/16SW equal to the distance between the aforementioned stones. This best fits Bradish's 1877 survey and the stones that Bliss set in 1867 to the North, South, and East. It would appear that the stone that Bliss set at this location was long ago knocked or washed out.

Describe or show any material discrepancy between the location of the restored corner and that of the corner previously restored or reestablished.


NONE KNOWN.

RECORD OF DURABLE WITNESS MONUMENTS

NO	DESCRIPTION	GRID NORTH	GROUND DIST.
		BEARING	DISTANCE
1	SET 3/4" x 30" I.B. 3' N. OF FISHERMAN'S CROSSING GATE	N 55°38'23" W	230.94 FT.
2	SET A P.K. NAIL IN N.W.-SIDE OF A 13" ELM	N 63°22'23" E	103.49 FT.
3	SET A P.K. NAIL IN N.W.-SIDE OF A 14-1/2" ELM ?	S 41°16'54" W	209.15 FT.
4	SET 3/4" x 30" I.B. 4' N. OF THE CENTER OF A POWER POLE	S 78°26'21" W	106.30 FT.

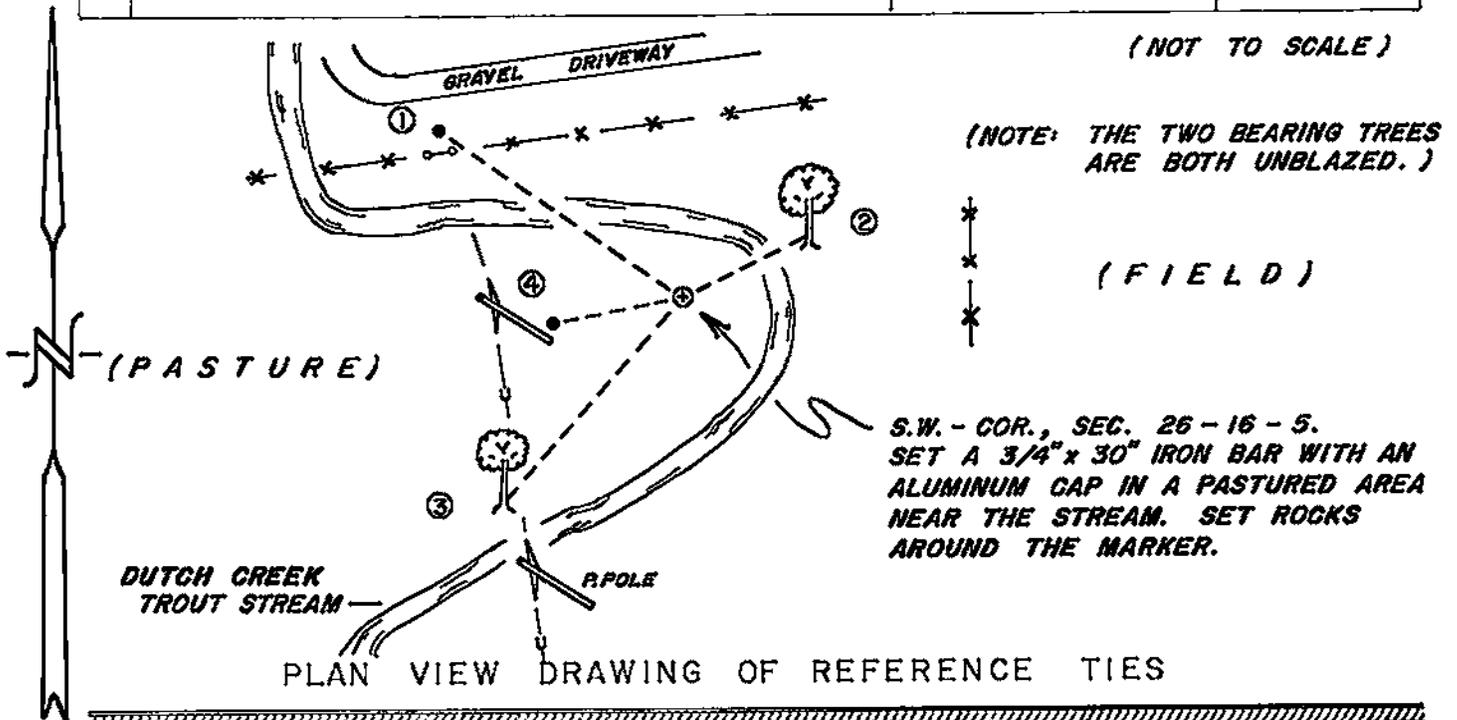


MAP SHOWING DISTANCE AND DIRECTION TO OTHER PUBLIC LAND SURVEY CORNERS USED FOR REESTABLISHING THE CORNER

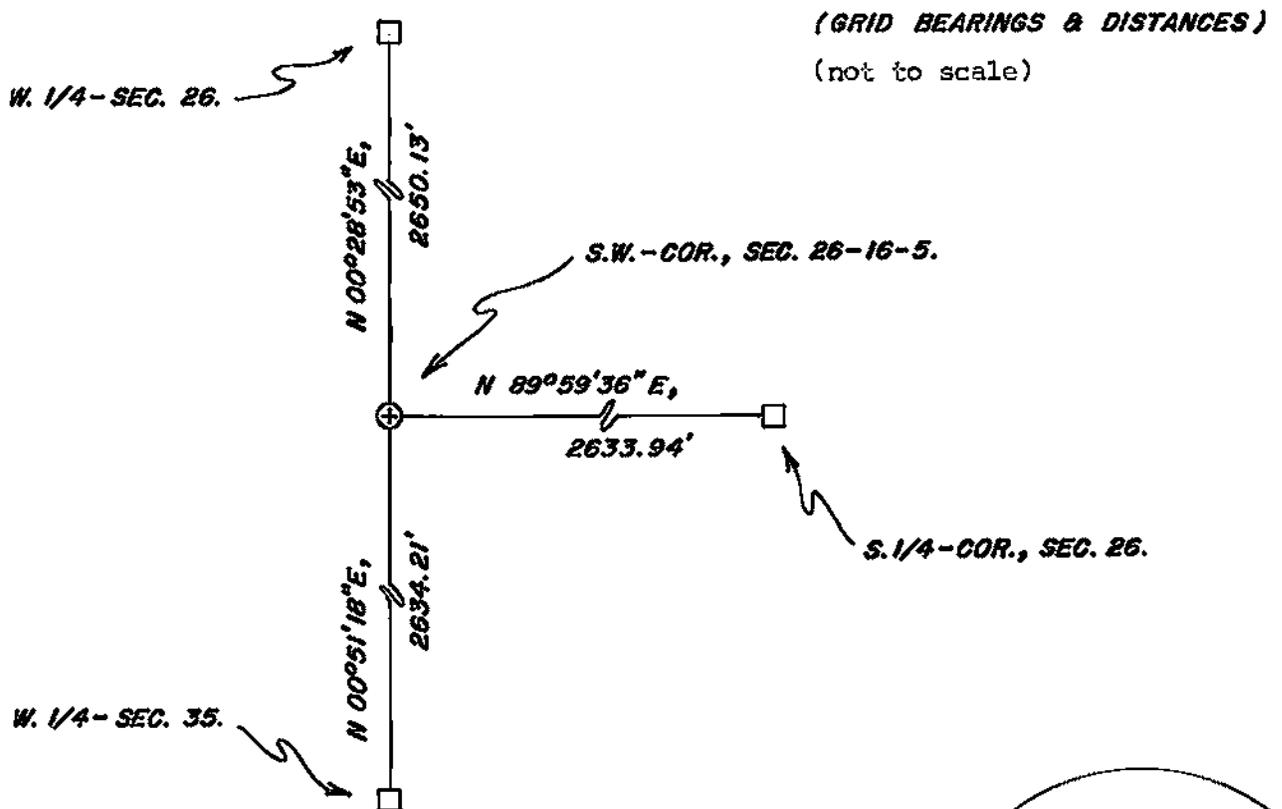

I, WILLIAM C. JUNG, COUNTY SURVEYOR
HEREBY CERTIFY THAT THE CORNER LOCATION SHOWN ON THIS RECORD WAS DETERMINED BY ME OR UNDER MY DIRECTION AND CONTROL AND THAT THIS U. S. PUBLIC LAND SURVEY MONUMENT RECORD IS CORRECT AND COMPLETE TO THE BEST OF MY KNOWLEDGE AND BELIEF.

William C. Jung 11/16/00
Signature Date

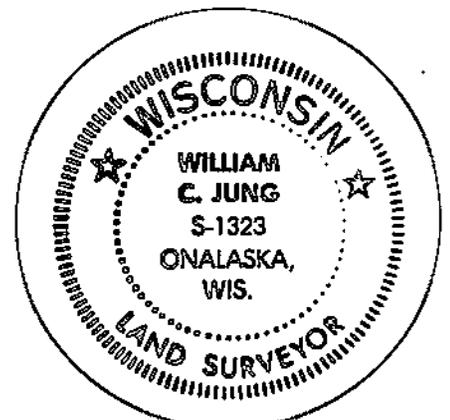

Seal