


21605270020

U. S. PUBLIC LAND SURVEY MONUMENT RECORD

SECTION 27 T 16 N, R 5 W, TOWN OF BANGOR

LA CROSSE COUNTY

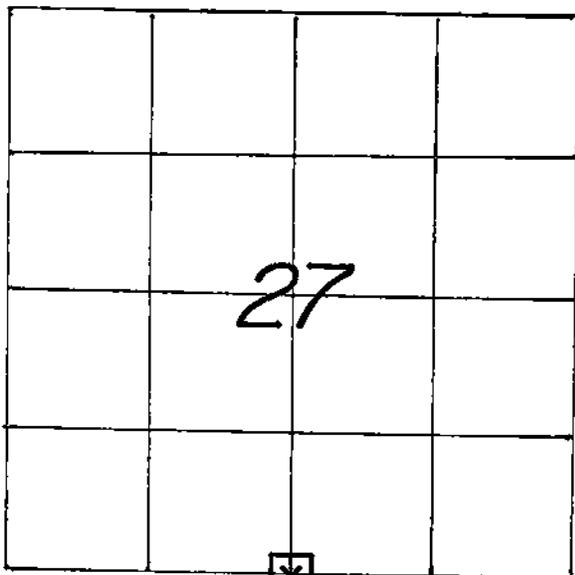

WISCONSIN COORDINATE SYSTEM
North
East
Theta Angle
Horiz. Order
Vert. Order
TYPE OF LANDMARK
6" x 6" SCRIBED STONE.
BEARINGS ARE REFERENCED TO

LOCATION OF LANDMARK

CREW: WILLIAM C. JUNG
 PETER F. FOLLANSBEE
 DATE: 12/08/2003

Describe any record evidence, monument evidence, testimonial evidence or any other material evidence you considered and whether the monument was found or restored through acceptance of an obliterated evidence location.

I found Bliss' 1867 stone and accepted it as the best available evidence of the original government corner position. The stone settled over the years and was off plumb. I reset the stone and plumbed it back up.

Describe or show any material discrepancy between the location of the restored corner and that of the corner previously restored or reestablished.


NONE KNOWN.

RECORD OF DURABLE WITNESS MONUMENTS

MAGNETIC

NO	DESCRIPTION	BEARING	DISTANCE
1	SET A NAIL IN E.-SIDE OF A 4" HICKORY	N 14° W	4.54 FT.
2	SET A NAIL IN S.W.-SIDE OF A 5-1/2" WHITE OAK	S 55° E	16.04 FT.
3	SET A NAIL IN E.-SIDE OF A 20-1/2" OAK	S 11° E	5.93 FT.
4	SET A NAIL IN S.E.-SIDE OF A 16" OAK	S 41° W	23.01 FT.

(W O O D S)

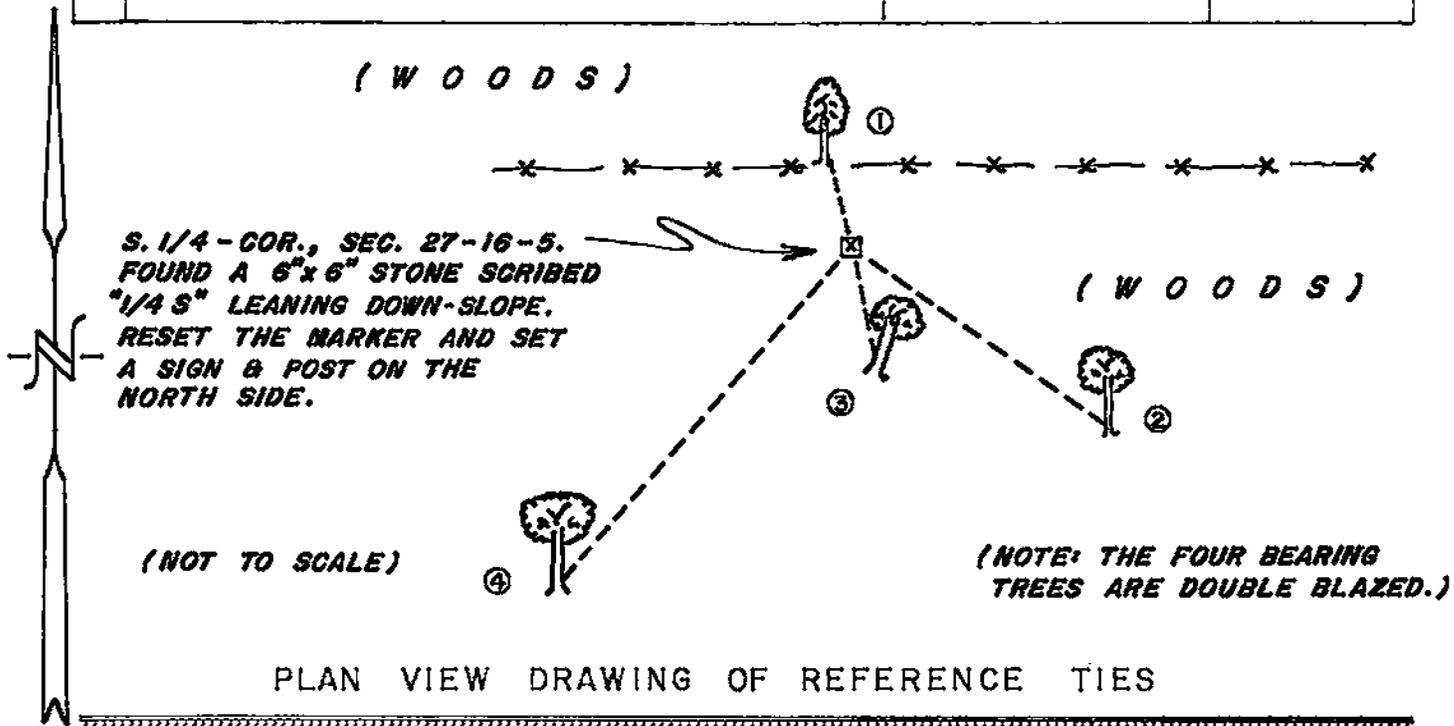


MAP SHOWING DISTANCE AND DIRECTION TO OTHER PUBLIC LAND SURVEY CORNERS USED FOR REESTABLISHING THE CORNER

No new section measurements were made by me at this time.

I, WILLIAM C. JUNG, COUNTY SURVEYOR
 HEREBY CERTIFY THAT THE CORNER LOCATION SHOWN ON THIS RECORD
 WAS DETERMINED BY ME OR UNDER MY DIRECTION AND CONTROL AND
 THAT THIS U. S. PUBLIC LAND SURVEY MONUMENT RECORD IS CORRECT
 AND COMPLETE TO THE BEST OF MY KNOWLEDGE AND BELIEF.

William C. Jung 12/16/03
 Signature Date

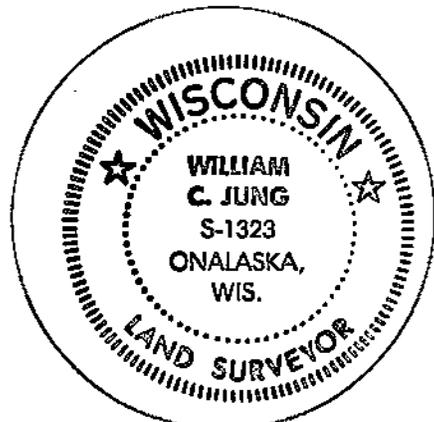

Seal