


21605280000

U. S. PUBLIC LAND SURVEY MONUMENT RECORD

SECTION 28 T 16 N, R 5 W, TOWN OF BANGOR

LA CROSSE COUNTY

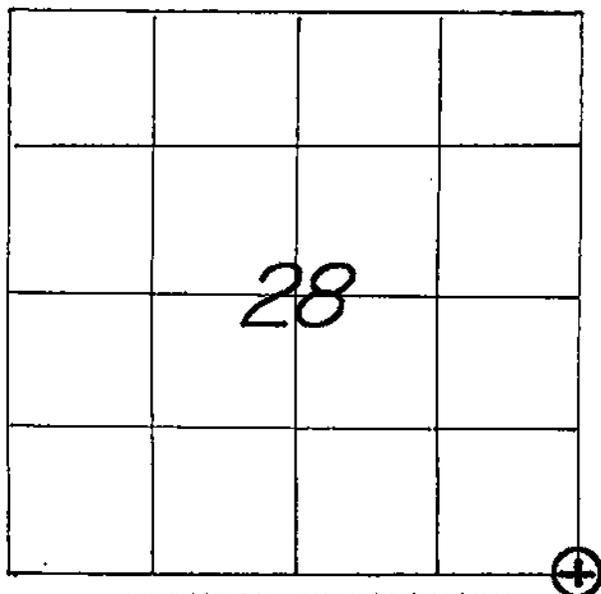

LOCATION OF LANDMARK

**CREW: WILLIAM C. JUNG
PETER F. FOLLANSBEE
DATE: 10/17/2003**

WISCONSIN COORDINATE SYSTEM

North **667,302.537**

East **1,712,416.872**

Theta Angle

Horiz. Order

Vert. Order

DATUM: **NAD 1983('91)**

TYPE OF LANDMARK

3/4" x 30" IRON BAR WITH AN ALUMINUM CAP.

BEARINGS ARE REFERENCED TO

GRID NORTH AS PER SECTION DATA.

Describe any record evidence, monument evidence, testimonial evidence or any other material evidence you considered and whether the monument was found or restored through acceptance of an obliterated evidence location.

In his field notes for the William Lemon survey, dated 11/29/69, Marcou shows that the 1867 Bliss stone was in. In March of 1996 Pete and I found the stone out. It lay on the hillside about 75 feet (slope) to the Southeast. Either time or frost action might have caused the stone to roll down the hill or it might have been vandals who did it. Mr. Lemon, now 81, said that he thought that it might have been the latter. Mr. Lemon could not remember the stone, but he did remember a post. He put in a flag where he remembered the post to be. A few inches to the E-NE of his post position I dug and found a spot that could have held a stone. With all the rock in the area, this was the only location that I found that could have held the Bliss stone. Also, to the Southwest I found a dead oak that I am convinced is

Describe or show any material discrepancy between the location of the restored corner and that of the corner previously restored or reestablished. *****


NONE KNOWN.

***** continued (which fits the call)

the remains of the original bearing tree. After examining this tree at length, I have no doubt. Also, during my section traverse, I retraced not only the original survey, but also Bradish's survey of 1877, Marcou's 1969 survey, and Berg's 1982 survey. These surveys all check and fit each other. The occupation also fits. I set an iron bar and cap in a rock pile. I am convinced that it marks the location of the old stone and thus the original government corner. The Bliss stone still is on the hillside to the Southeast. We did not move it at this time. It should also be mentioned that the SW and S1/4 corners of Section 28 also definitely mark original government corner positions. There are Bliss stones at these corners whose locations are verified by original bearing trees. The S1/4 corner is far from its theoretical corner position.


RECORD OF DURABLE WITNESS MONUMENTS
MAGNETIC

NO	DESCRIPTION	BEARING	DISTANCE
1	SET A NAIL IN N.W.-SIDE OF AN 18" OAK	S 76° W	44.95 FT.
2	SET A NAIL IN S.E.-SIDE OF A 25" WHITE OAK	S 84° W	79.92 FT.
3	SET A NAIL IN S.W.-SIDE OF A LARGE DOUBLE OAK	N 40° W	26.50 FT.
4	SET A NAIL IN W.-SIDE OF A 7-1/2" WHITE OAK	N 01° W	32.14 FT.

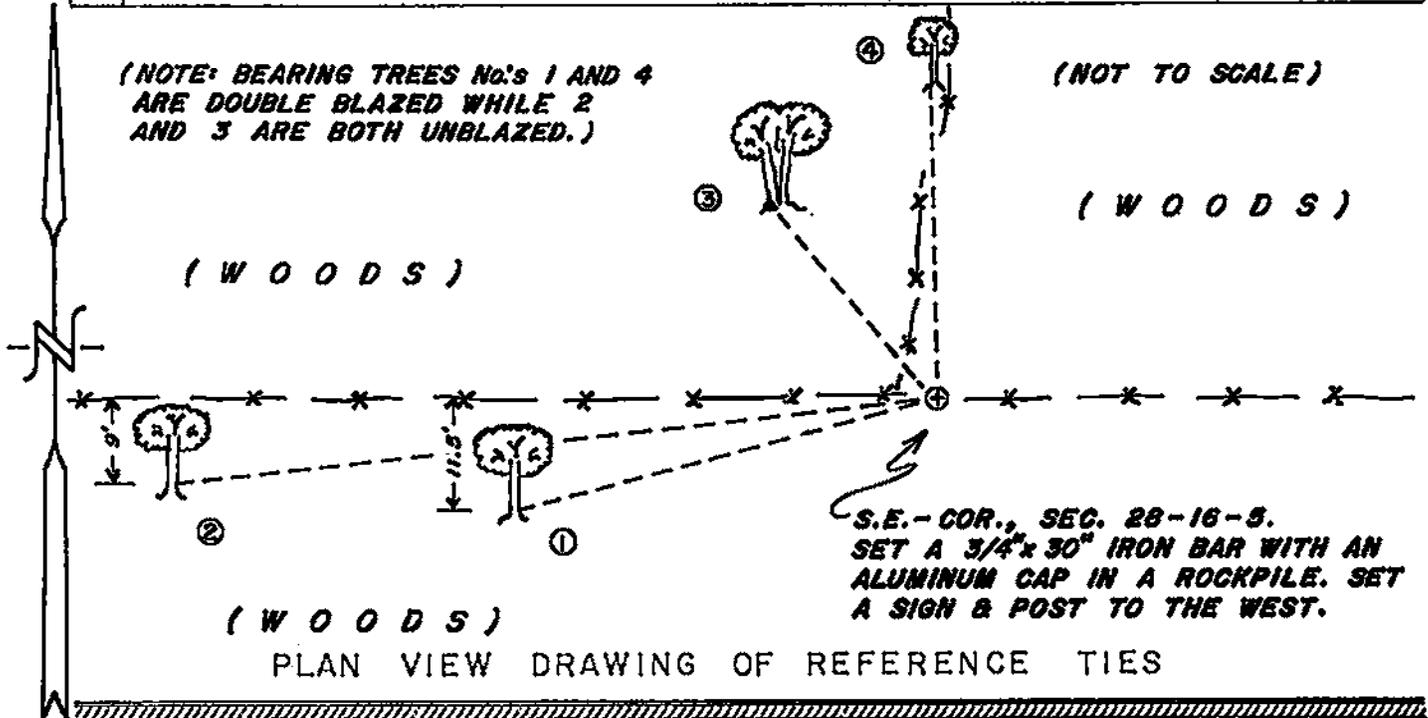

MAP SHOWING DISTANCE AND DIRECTION TO OTHER PUBLIC LAND SURVEY CORNERS USED FOR REESTABLISHING THE CORNER


(GRID BEARINGS & DISTANCES)
(GRID FACTOR: 0.999912)
(NOT TO SCALE)

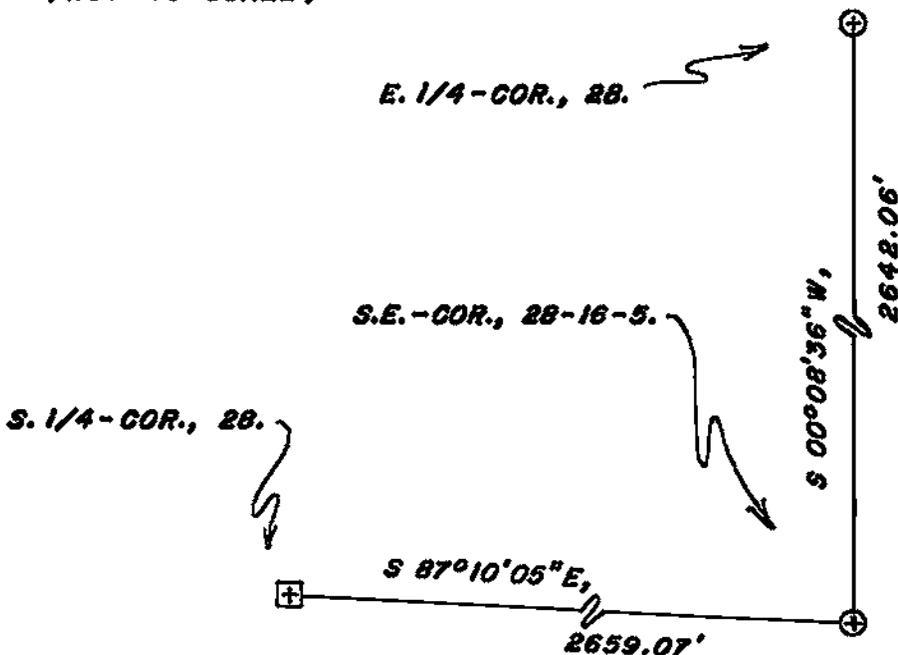

I, WILLIAM C. JUNG, COUNTY SURVEYOR
HEREBY CERTIFY THAT THE CORNER LOCATION SHOWN ON THIS RECORD WAS DETERMINED BY ME OR UNDER MY DIRECTION AND CONTROL AND THAT THIS U. S. PUBLIC LAND SURVEY MONUMENT RECORD IS CORRECT AND COMPLETE TO THE BEST OF MY KNOWLEDGE AND BELIEF.

William C. Jung
Signature

11/4/03
Date

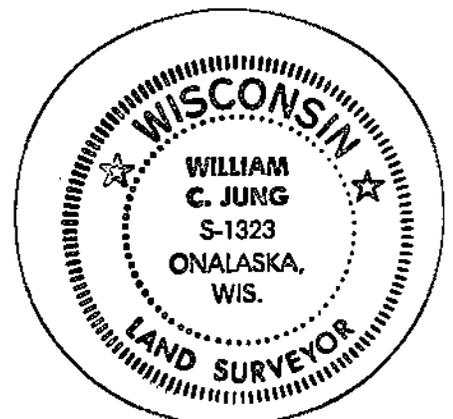

Seal