


21605282000

U. S. PUBLIC LAND SURVEY MONUMENT RECORD

SECTION 28 T 16 N, R 5 W, TOWN OF BANGOR

LA CROSSE COUNTY

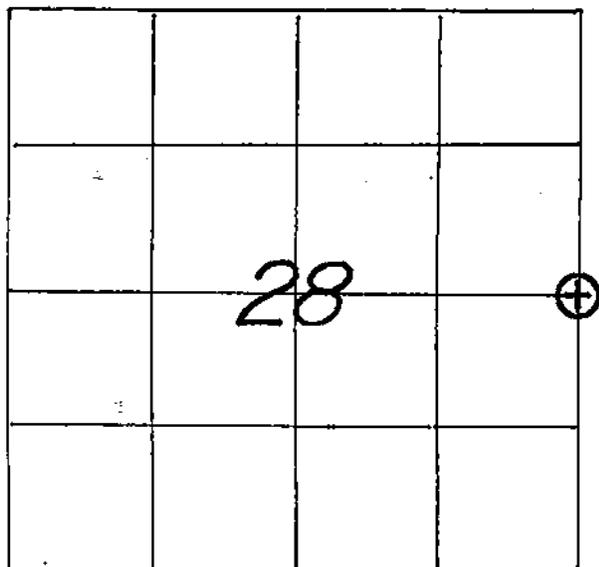

WISCONSIN COORDINATE SYSTEM

North **669,944.589**

East **1,712,423.485**

Theta Angle

Horiz. Order

Vert. Order

DATUM: NAD 1983('91)

TYPE OF LANDMARK

3/4" x 30" IRON BAR WITH AN ALUMINUM CAP.

BEARINGS ARE REFERENCED TO

GRID NORTH AS PER SECTION DATA.

LOCATION OF LANDMARK

**CREW: WILLIAM C. JUNG
PETER F. FOLLANSBEE
DATE: 11/06/2003**

Describe any record evidence, monument evidence, testimonial evidence or any other material evidence you considered and whether the monument was found or restored through acceptance of an obliterated evidence location.


As we did over seven years ago, we searched at great length for the Bliss stone but with no success. This corner was set by single proportionate measurement. We set an iron bar and cap at the corner in a rock pile. The fence to the West is considerably off, about 50 feet or so.

Describe or show any material discrepancy between the location of the restored corner and that of the corner previously restored or reestablished.


NONE KNOWN.

RECORD OF DURABLE WITNESS MONUMENTS

| NO | DESCRIPTION | BEARING | DISTANCE |
|----|---|---------------------|--------------|
| 1 | SET A 3/4" x 30" IRON BAR WITH ALUMINUM CAP | S 55°34'35"W (GRID) | 60.45 FT. |
| 2 | SET A NAIL IN S.W.-SIDE OF A 7-VL" HICKORY | N 43° W (MAG.) | 6.86 FT. |
| 3 | SET A NAIL IN S.W.-SIDE OF A 15" OAK | N 24° W (MAG.) | 30.64 FT. |
| 4 | SET A NAIL IN N.W.-SIDE OF A 6-VL" HICKORY | N 29° E (MAG.) | SLOPE=39.65' |

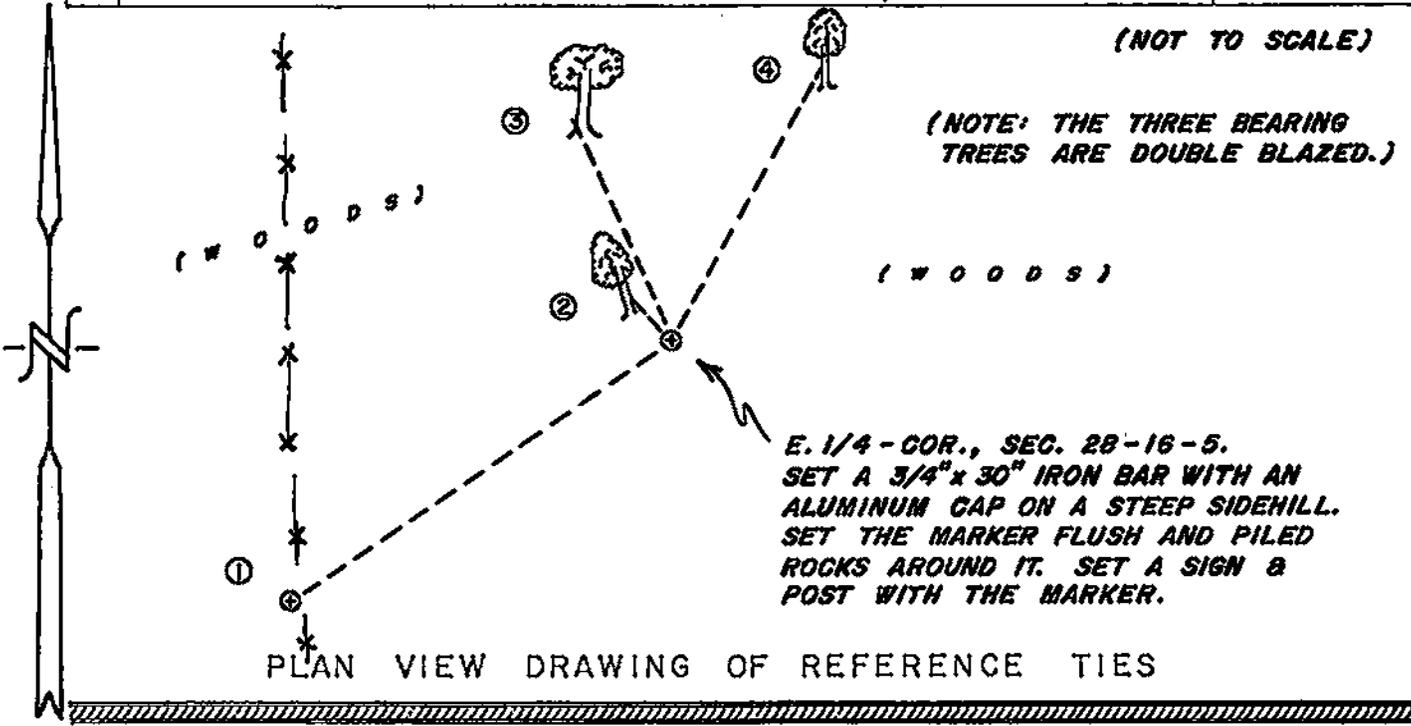


MAP SHOWING DISTANCE AND DIRECTION TO OTHER PUBLIC LAND SURVEY CORNERS USED FOR REESTABLISHING THE CORNER

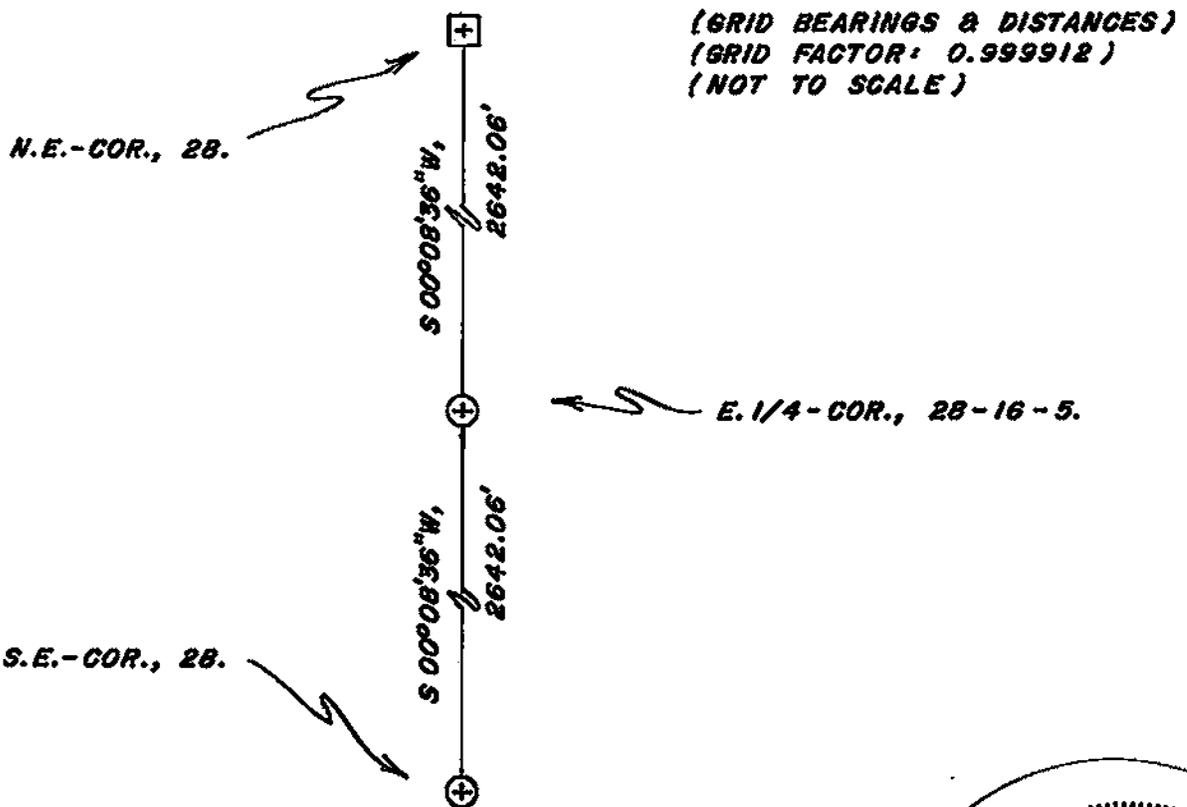

I, WILLIAM C. JUNG, COUNTY SURVEYOR
 HEREBY CERTIFY THAT THE CORNER LOCATION SHOWN ON THIS RECORD
 WAS DETERMINED BY ME OR UNDER MY DIRECTION AND CONTROL AND
 THAT THIS U. S. PUBLIC LAND SURVEY MONUMENT RECORD IS CORRECT
 AND COMPLETE TO THE BEST OF MY KNOWLEDGE AND BELIEF.

William C. Jung 11/18/03
 Signature Date

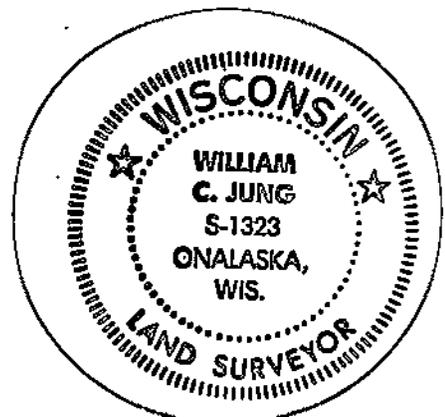

Seal