


21605290000

U. S. PUBLIC LAND SURVEY MONUMENT RECORD

SECTION 29 T 16 N, R 5 W, TOWN OF BANGOR
LA CROSSE COUNTY

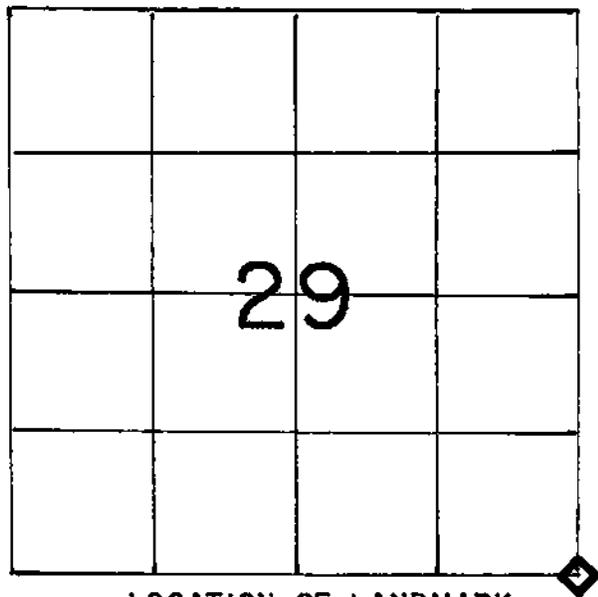

LOCATION OF LANDMARK

WISCONSIN COORDINATE SYSTEM
North
East
Theta Angle
Horiz. Order
Vert. Order
TYPE OF LANDMARK
Existing 6" square Stone
BEARINGS ARE REFERENCED TO

Crew: WILLIAM C. JUNG

Date: 10/20/1992

Describe any record evidence, monument evidence, testimonial evidence or any other material evidence you considered and whether the monument was found or restored through acceptance of an obliterated evidence location.

I found a stone at the corner and accepted it as the best available evidence of the original government corner position.


Note: Both original bearing tree stumps are in.

Describe or show any material discrepancy between the location of the restored corner and that of the corner previously restored or reestablished.

None Known

RECORD OF DURABLE WITNESS MONUMENTS

NO	DESCRIPTION	BEARING	DISTANCE
1	Set P.K. Nail in NE-side 4" Hickory	Northwesterly	Sl.=20.75'
2	Set P.K. Nail in NE-side 5" Burr Oak	Northwesterly	Sl.= 9.67'
3	Set P.K. Nail in NW-side 5" Hickory	Northeasterly	19.71 Ft.
4	Set P.K. Nail in SE-side 9" Aspen	Southwesterly	Sl.= 9.96'

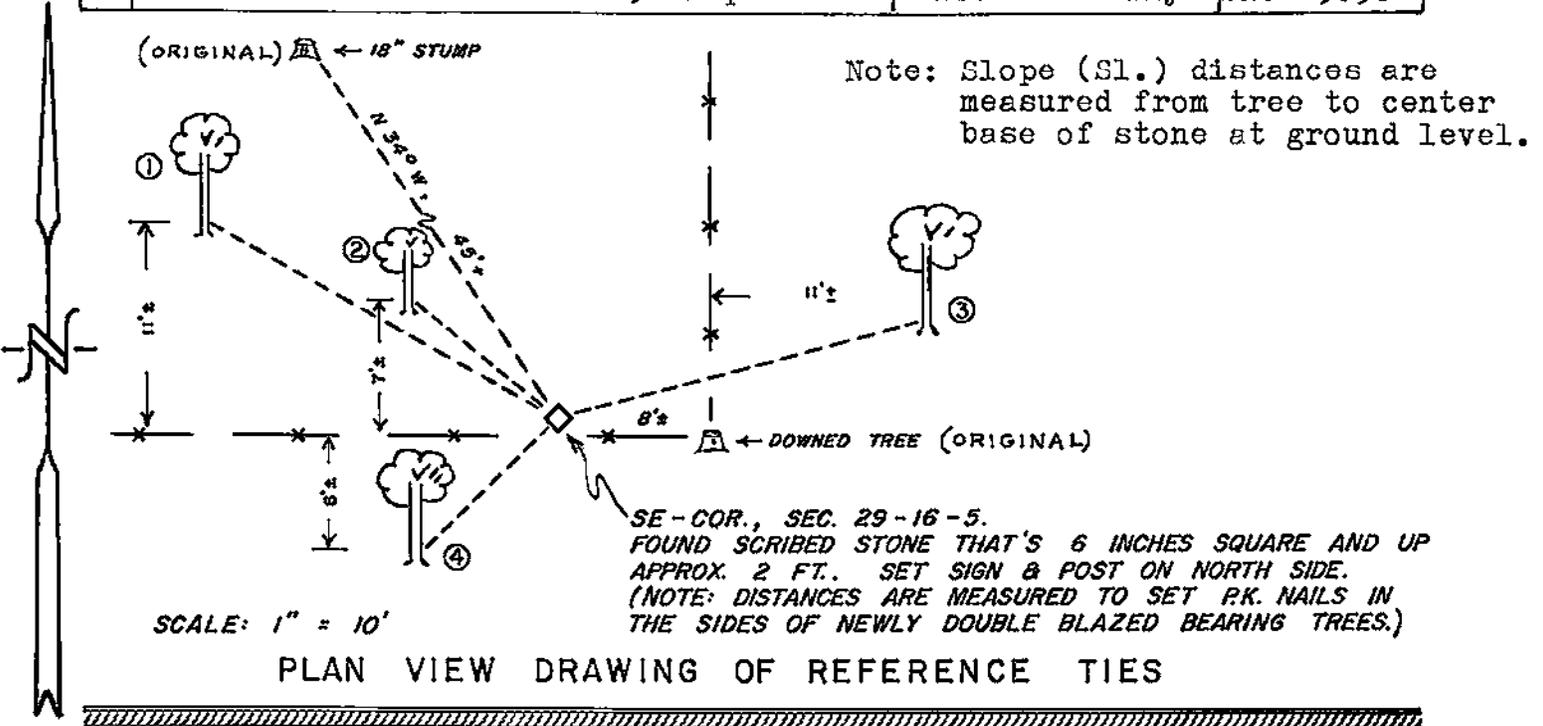


MAP SHOWING DISTANCE AND DIRECTION TO OTHER PUBLIC LAND SURVEY CORNERS USED FOR REESTABLISHING THE CORNER

No section measurements made by me at this time.

I, William C. Jung, Deputy County Surveyor
 HEREBY CERTIFY THAT THE CORNER LOCATION SHOWN ON THIS RECORD
 WAS DETERMINED BY ME OR UNDER MY DIRECTION AND CONTROL AND
 THAT THIS U. S. PUBLIC LAND SURVEY MONUMENT RECORD IS CORRECT
 AND COMPLETE TO THE BEST OF MY KNOWLEDGE AND BELIEF.


William C. Jung 12/15/92
 Signature Date

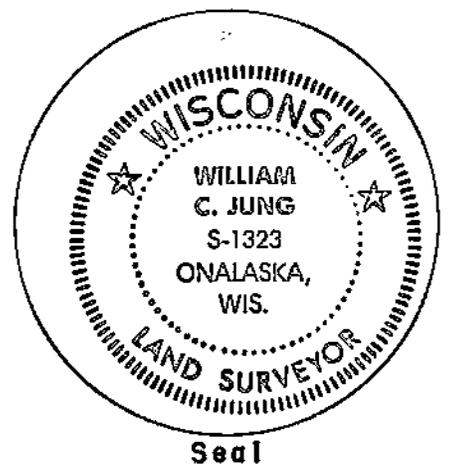

Seal

U. S. PUBLIC LAND SURVEY MONUMENT RECORD

SECTION 28 T 16 N, R 5 W, TOWN OF BANGOR
 LA CROSSE COUNTY

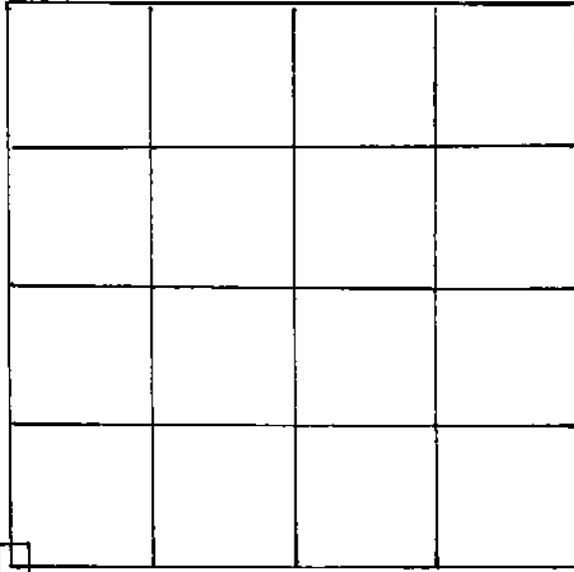

LOCATION OF LANDMARK

WISCONSIN COORDINATE SYSTEM
North
East
Theta Angle
Horiz. Order
Vert. Order
TYPE OF LANDMARK
STONE
BEARINGS ARE REFERENCED TO


Describe any record evidence, monument evidence, testimonial evidence or any other material evidence you considered and whether the monument was found or restored through acceptance of an obliterated evidence location.

Found stone tipped northerly & 9' west of fence intersection.
 Straightened & tied

Describe or show any material discrepancy between the location of the restored corner and that of the corner previously restored or reestablished.

RECORD OF DURABLE WITNESS MONUMENTS

NO	DESCRIPTION	BEARING	DISTANCE
1	PK NAIL SET DEAD WHITE OAK	SE	8.53'
2	PK NAIL SET 8" ASPEN	SW	9.75'
3	PK NAIL SET 10" ASPEN	NW	13.72'
4	PK NAIL SET 10" BIRCH	NW	21.48'

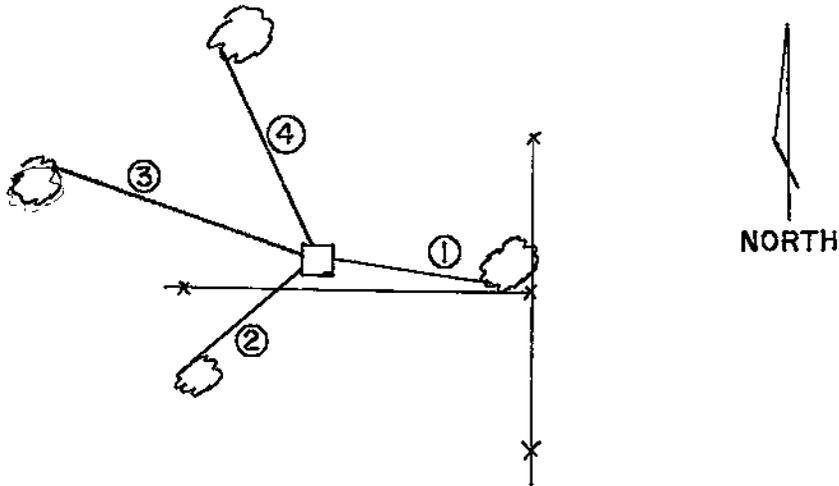

NOT TO SCALE

PLAN VIEW DRAWING OF REFERENCE TIES

MAP SHOWING DISTANCE AND DIRECTION TO OTHER PUBLIC LAND SURVEY CORNERS USED FOR REESTABLISHING THE CORNER

I, GARY A. WATTS
 HEREBY CERTIFY THAT THE CORNER LOCATION SHOWN ON THIS RECORD
 WAS DETERMINED BY ME OR UNDER MY DIRECTION AND CONTROL AND
 THAT THIS U. S. PUBLIC LAND SURVEY MONUMENT RECORD IS CORRECT
 AND COMPLETE TO THE BEST OF MY KNOWLEDGE AND BELIEF.

Gary A. Watts Signature July 8, 1985 Date



Seal