


21605290020

U. S. PUBLIC LAND SURVEY MONUMENT RECORD

SECTION 29 T 16 N, R 5 W, TOWN OF Bangor

LA CROSSE COUNTY

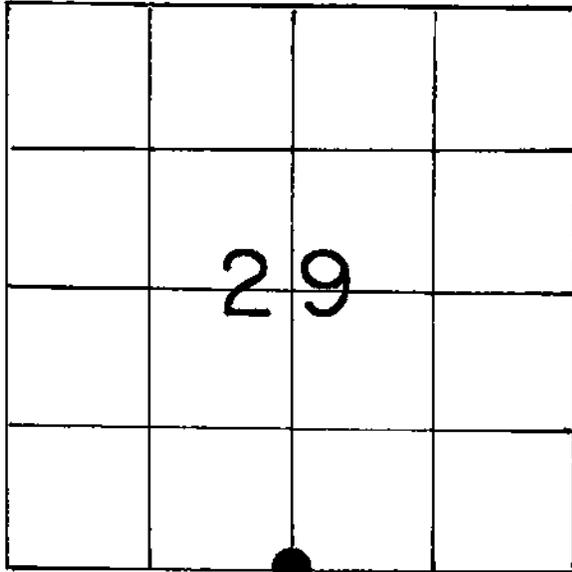

LOCATION OF LANDMARK

Crew: William C. Jung

Date: 6/15/1993

WISCONSIN COORDINATE SYSTEM

North
East
Theta Angle
Horiz. Order
Vert. Order

TYPE OF LANDMARK
Set brass cap Lunde marker.

BEARINGS ARE REFERENCED TO
True

Crew: Peter Follansbee

Michael Weibel

4/7/96

Describe any record evidence, monument evidence, testimonial evidence or any other material evidence you considered and whether the monument was found or restored through acceptance of an obliterated evidence location.

I set this corner by single proportionate measurement and monumented it with ~~an~~ **"Lunde"** ~~iron pipe~~. The fence to the South is obviously off and meanders all over. The fence to the West is straight and appears to be close. The fence at the corner was probably moved South so that the knoll could be cleared and plowed. This would probably account for what happened to the old stone that was probably here once. It was more than likely knocked out.


Describe or show any material discrepancy between the location of the restored corner and that of the corner previously restored or reestablished.

None known.

RECORD OF DURABLE WITNESS MONUMENTS

MAGNETIC


NO	DESCRIPTION	BEARING	DISTANCE
1	Set P.K. Nail in E.-side of S.-trunk dbl. Hickory (8")	S 14° W	SL.=37.34 Ft.
2	Set P.K. Nail in NE-side 8" Oak	S 03° E	SL.=42.25 Ft.
3	Set P.K. Nail in NE-side 6" Hickory	S 03° E	SL.=63.09 Ft.
4	Set P.K. Nail in NE-side 6" Hickory	S 10° E	SL.=49.57 Ft.

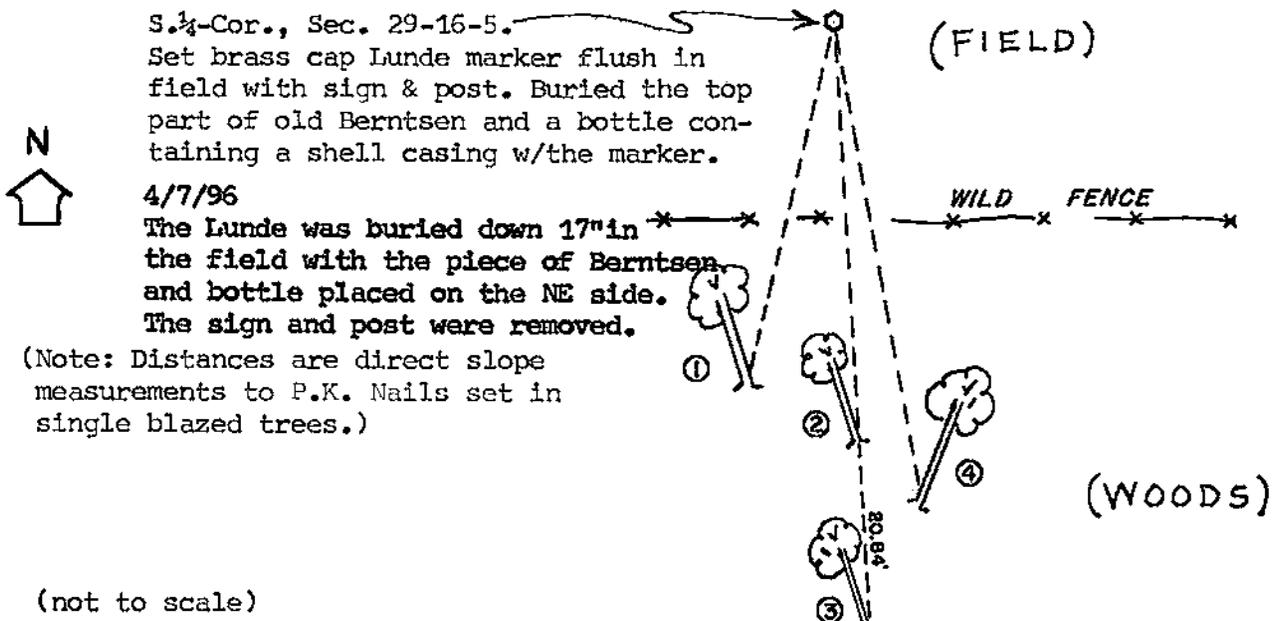

(not to scale)

MAP SHOWING DISTANCE AND DIRECTION TO OTHER PUBLIC LAND SURVEY CORNERS USED FOR REESTABLISHING THE CORNER

(not to scale)

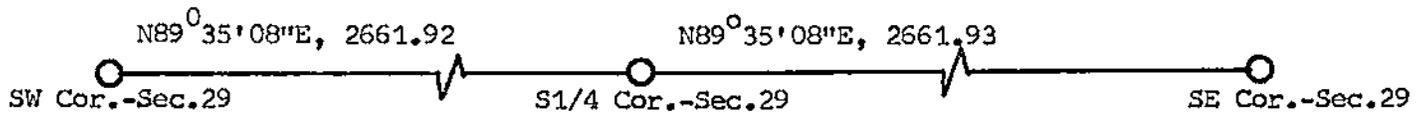


I, William C. Jung, County Surveyor,
 HEREBY CERTIFY THAT THE CORNER LOCATION SHOWN ON THIS RECORD
 WAS DETERMINED BY ME OR UNDER MY DIRECTION AND CONTROL AND
 THAT THIS U. S. PUBLIC LAND SURVEY MONUMENT RECORD IS CORRECT
 AND COMPLETE TO THE BEST OF MY KNOWLEDGE AND BELIEF.

William C. Jung
 Signature

1/17/94
 Date

Revised; 12/3/96 *wey*

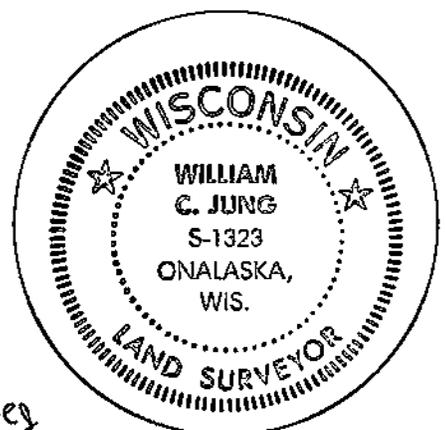

Seal