


21605292000

U. S. PUBLIC LAND SURVEY MONUMENT RECORD

SECTION 28 T 16 N, R 5 W, TOWN OF BANGOR

LA CROSSE COUNTY

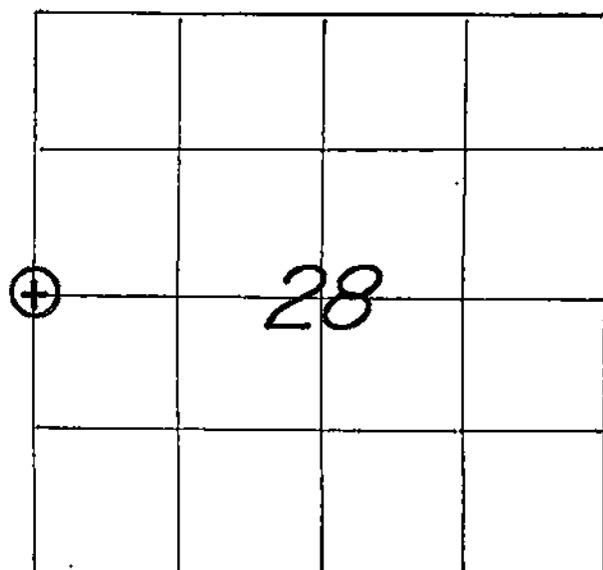

LOCATION OF LANDMARK

CREW: **WILLIAM C. JUNG**
PETER F. FOLLANSBEE
 DATE: **9/03/2003**

WISCONSIN COORDINATE SYSTEM

North **670,025.886**East **1,707,200.557**

Theta Angle

Horiz. Order

Vert. Order

DATUM: **NAD 1983('91)**

TYPE OF LANDMARK

3/4" x 30" IRON BAR WITH AN ALUMINUM CAP.

BEARINGS ARE REFERENCED TO

GRID NORTH AS PER SECTION DATA.

Describe any record evidence, monument evidence, testimonial evidence or any other material evidence you considered and whether the monument was found or restored through acceptance of an obliterated evidence location.


The area around the corner is now an overgrown pasture. Eleven years ago it was a normal pasture. At that time I searched the pasture at great length for the Bliss stone but with no success. I also made a pile of stones for a survey point but was not able to find the pile in the current undergrowth. We set an iron bar and cap at the corner, flush. The corner was set at the single proportionate position.

Maxwell and Harding have used this computed position in previous surveys. Describe or show any material discrepancy between the location of the restored corner and that of the corner previously restored or reestablished.

NONE KNOWN.


RECORD OF DURABLE WITNESS MONUMENTS

NO	DESCRIPTION	GRID BEARINGS	GROUND DIST.'s
		BEARING	DISTANCE
1	SET A 3/4" x 30" IRON BAR WITH RED PLASTIC CAP	N 70°23'14" E	136.21 FT.
2	SET A 3/4" x 30" IRON BAR WITH RED PLASTIC CAP	S 82°49'27" E	124.41 FT.
3	SET A 3/4" x 30" IRON BAR WITH RED PLASTIC CAP	S 52°24'57" E	145.43 FT.
4	SET A 3/4" x 30" IRON BAR WITH RED PLASTIC CAP	N 74°58'29" W	75.67 FT.

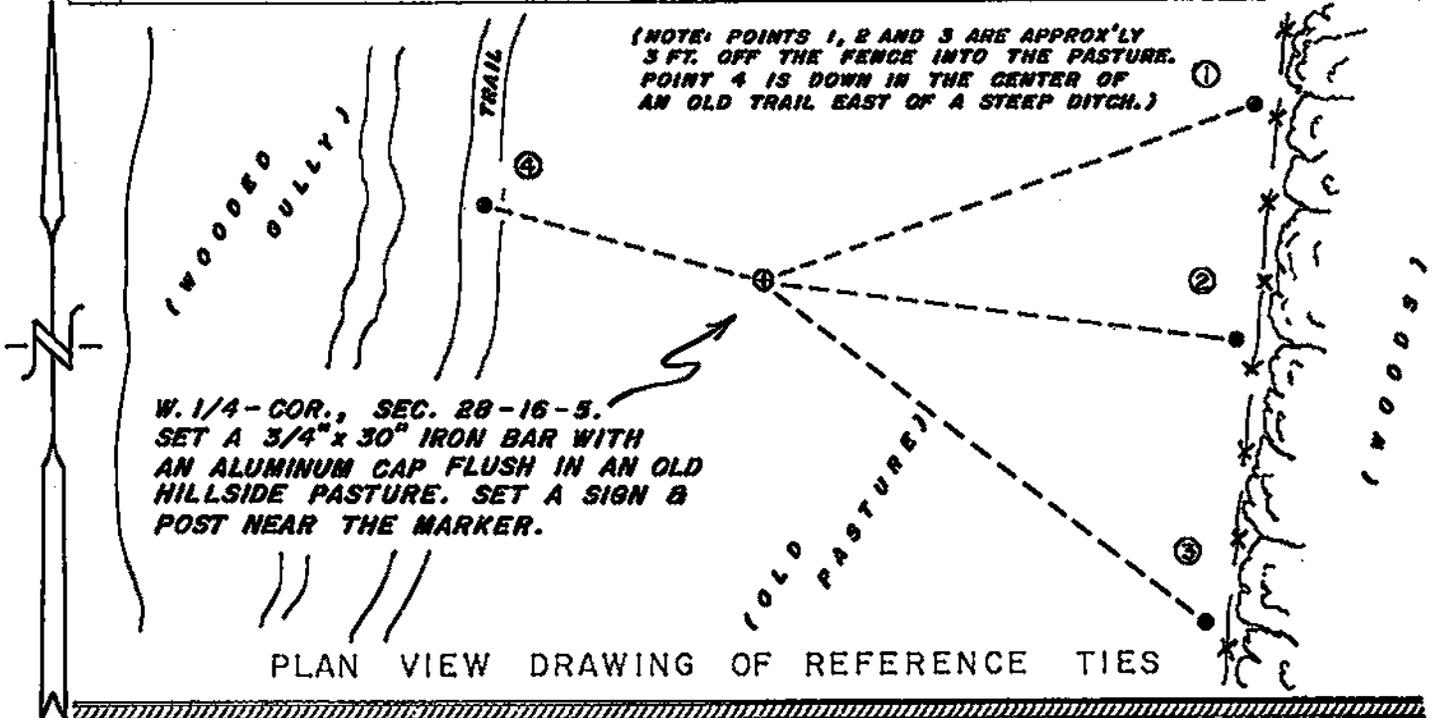


MAP SHOWING DISTANCE AND DIRECTION TO OTHER PUBLIC LAND SURVEY CORNERS USED FOR REESTABLISHING THE CORNER

(GRID BEARINGS & DISTANCES)
 (GRID FACTOR: 0.999912)
 (NOT TO SCALE)

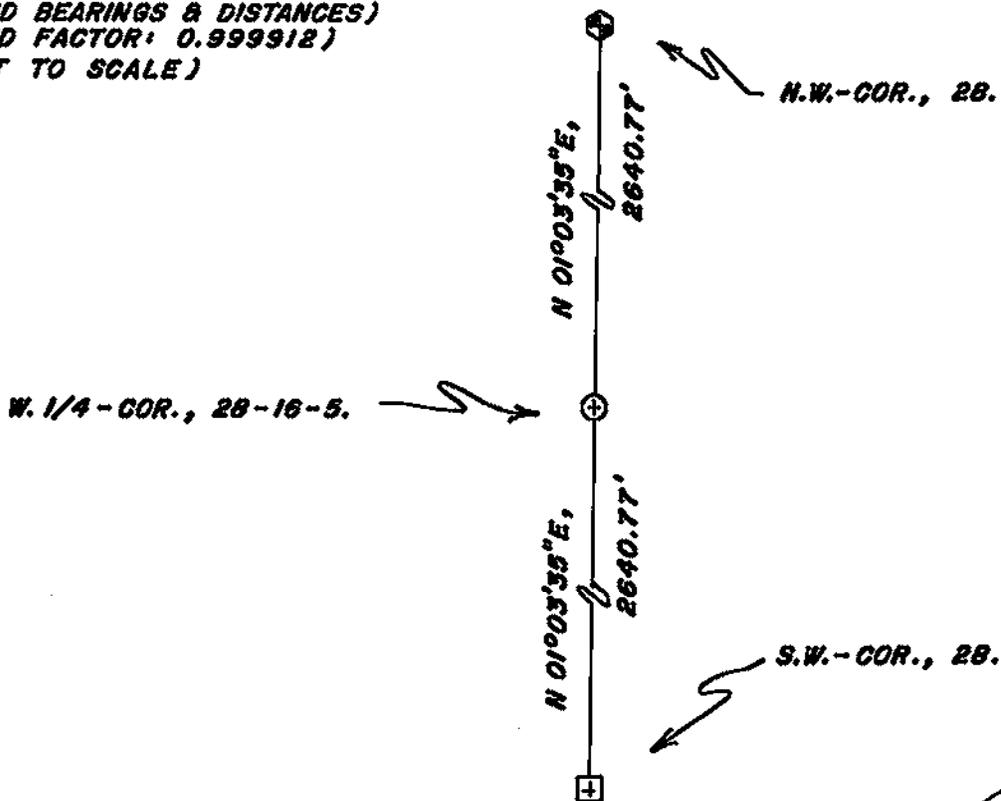

I, WILLIAM C. JUNG, COUNTY SURVEYOR
 HEREBY CERTIFY THAT THE CORNER LOCATION SHOWN ON THIS RECORD
 WAS DETERMINED BY ME OR UNDER MY DIRECTION AND CONTROL AND
 THAT THIS U. S. PUBLIC LAND SURVEY MONUMENT RECORD IS CORRECT
 AND COMPLETE TO THE BEST OF MY KNOWLEDGE AND BELIEF.

William C. Jung 11/7/03
 Signature Date

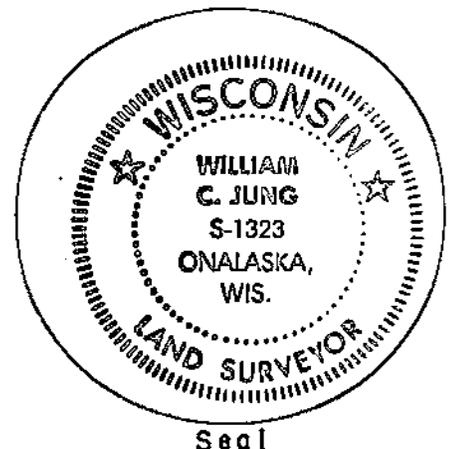

Seal