


21605300000

U. S. PUBLIC LAND SURVEY MONUMENT RECORD

SECTION 31 T 16 N, R 5 W, TOWN OF Bangor

LA CROSSE COUNTY

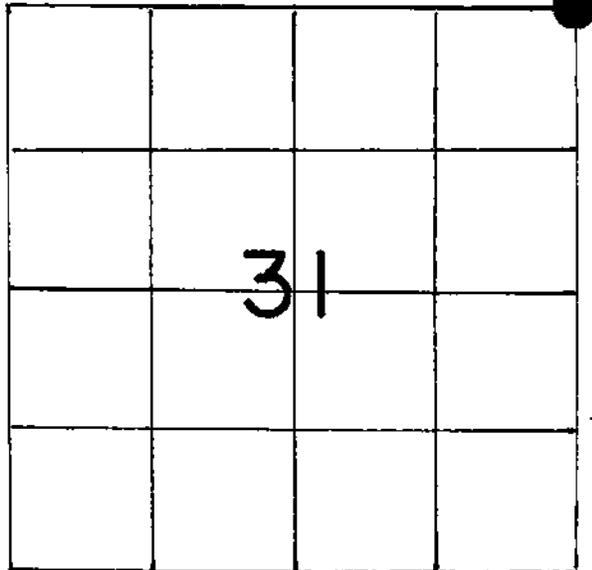

LOCATION OF LANDMARK

Crew: William C. Jung

Date: 6/15/1993

Describe any record evidence, monument evidence, testimonial evidence or any other material evidence you considered and whether the monument was found or restored through acceptance of an obliterated evidence location.

I set this corner by double proportionate measurement. After analyzing the field evidence and conditions, I came to the conclusion that DPM was the only way to reset this corner. I could not find anyone who knew of what might have happened to the stone that was probably here once. It may have been washed out.

Describe or show any material discrepancy between the location of the restored corner and that of the corner previously restored or reestablished.

None known.

WISCONSIN COORDINATE SYSTEM

North

East

Theta Angle

Horiz. Order

Vert. Order

TYPE OF LANDMARK


Set 1 1/4" x 29" Iron Pipe.

BEARINGS ARE REFERENCED TO

True

RECORD OF DURABLE WITNESS MONUMENTS

NO	DESCRIPTION	BEARING	DISTANCE
1	Exist. 1 1/4" x 30" rebar on North bank of creek	N 89° 31' 21" W	12.24 Ft.
2	Set 8" nail in NE-side of a very large Cottonwood	S 25° E (Mag.)	32.97 Ft.
3	Set 8" nail in SW-side 49" Cottonwood	S 76° E (Mag.)	60.52 Ft.
4	Distance to center of 8" Nut Tree	N 70° E (Mag.)	91.5 Ft.

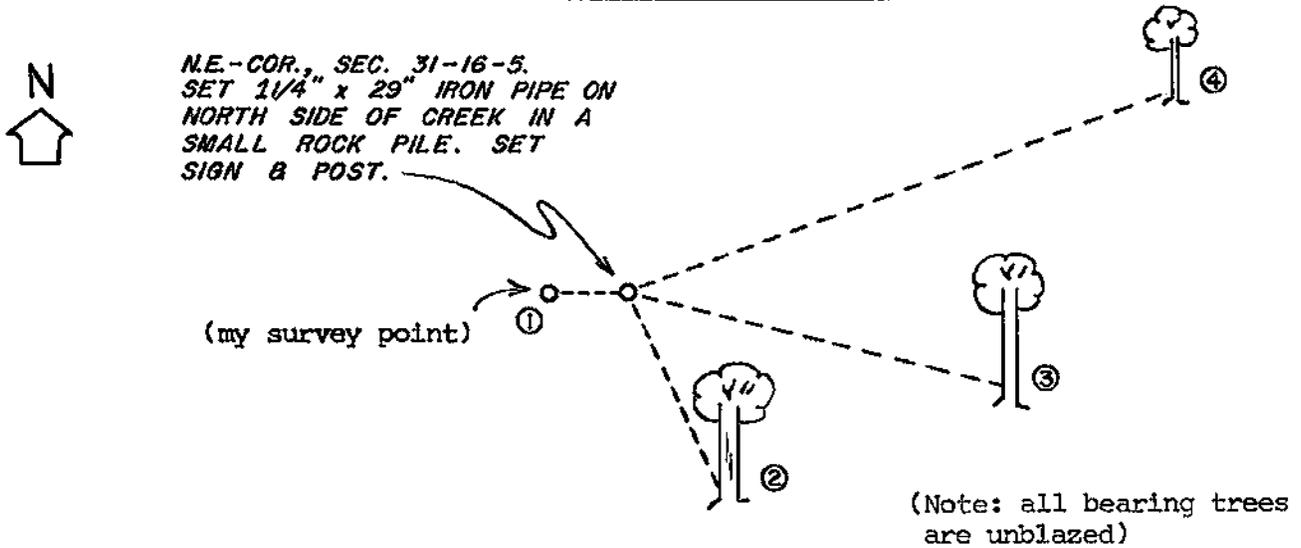


(not to scale)

PLAN VIEW DRAWING OF REFERENCE TIES


MAP SHOWING DISTANCE AND DIRECTION TO OTHER PUBLIC LAND SURVEY CORNERS USED FOR REESTABLISHING THE CORNER

(not to scale)

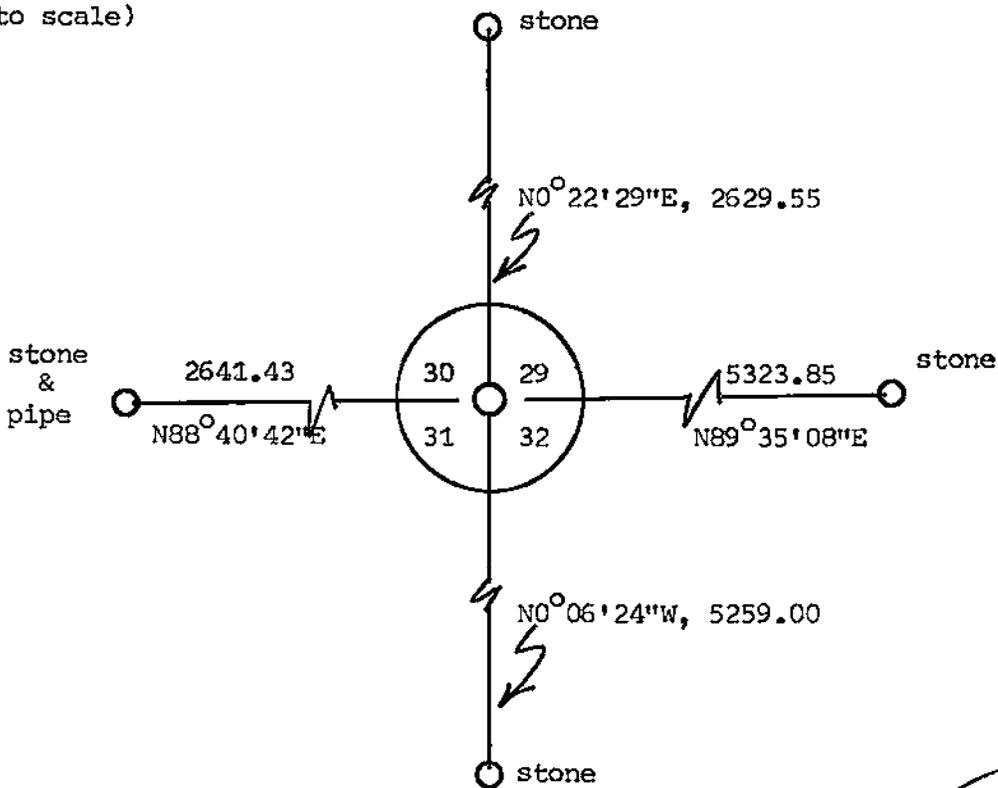

I, William C. Jung, County Surveyor,
HEREBY CERTIFY THAT THE CORNER LOCATION SHOWN ON THIS RECORD
WAS DETERMINED BY ME OR UNDER MY DIRECTION AND CONTROL AND
THAT THIS U. S. PUBLIC LAND SURVEY MONUMENT RECORD IS CORRECT
AND COMPLETE TO THE BEST OF MY KNOWLEDGE AND BELIEF.

William C. Jung 1/17/94
Signature Date

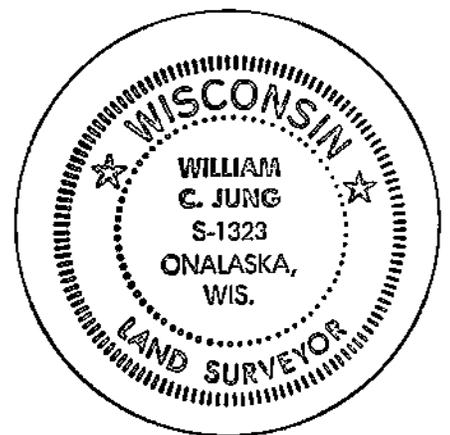

Seal