


21605300020

U. S. PUBLIC LAND SURVEY MONUMENT RECORD

SECTION 31 T 16 N, R 5 W, TOWN OF BANGOR

LA CROSSE COUNTY

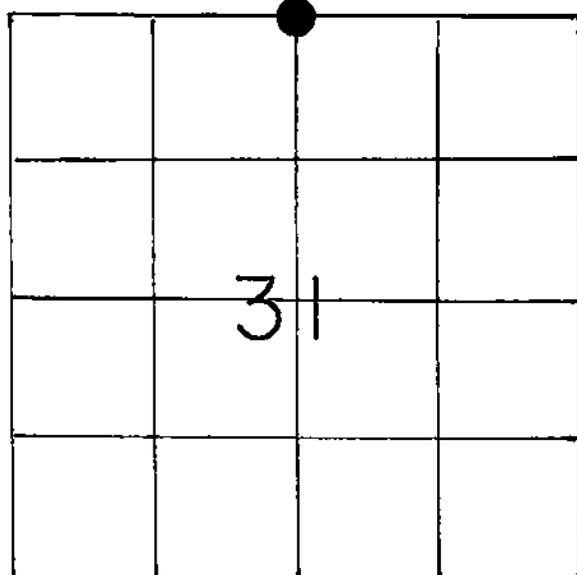

LOCATION OF LANDMARK

Crew: William Jung

7/11/84

WISCONSIN COORDINATE SYSTEM

North

East

Theta Angle

Horiz. Order

Vert. Order

TYPE OF LANDMARK

1" IRON PIPE

BEARINGS ARE REFERENCED TO

Describe any record evidence, monument evidence, testimonial evidence or any other material evidence you considered and whether the monument was found or restored through acceptance of an obliterated evidence location.


Ken Carlson found a stone at this corner in May of 1978. Clayton Solberg used this stone in November of 1980. I accepted the old stone at the corner as the best available evidence of the position of the original government corner. I found the stone, loose, and broken into thirds. I removed the broken stone and replaced it with an iron pipe. I then set (2) pieces of stone West of the pipe and (1) piece East of the pipe. The stone was stenciled 1/4S.

Describe or show any material discrepancy between the location of the restored corner and that of the corner previously restored or reestablished.

None known.

RECORD OF DURABLE WITNESS MONUMENTS

NO	DESCRIPTION	BEARING	DISTANCE
1	NAIL IN 13" OAK TREE, DOUBLE-BLAZED	N73° W =Mag.	58.87'
2	NAIL IN 20" OAK TREE, UNBLAZED	SOUTH ±	1.58'
3	NAIL IN 9" WHITE OAK, DOUBLE-BLAZED	-----	17.58'
4	NAIL IN TRIPLE HICKORY, DOUBLE-BLAZED	N7° E = Mag.	23.46'

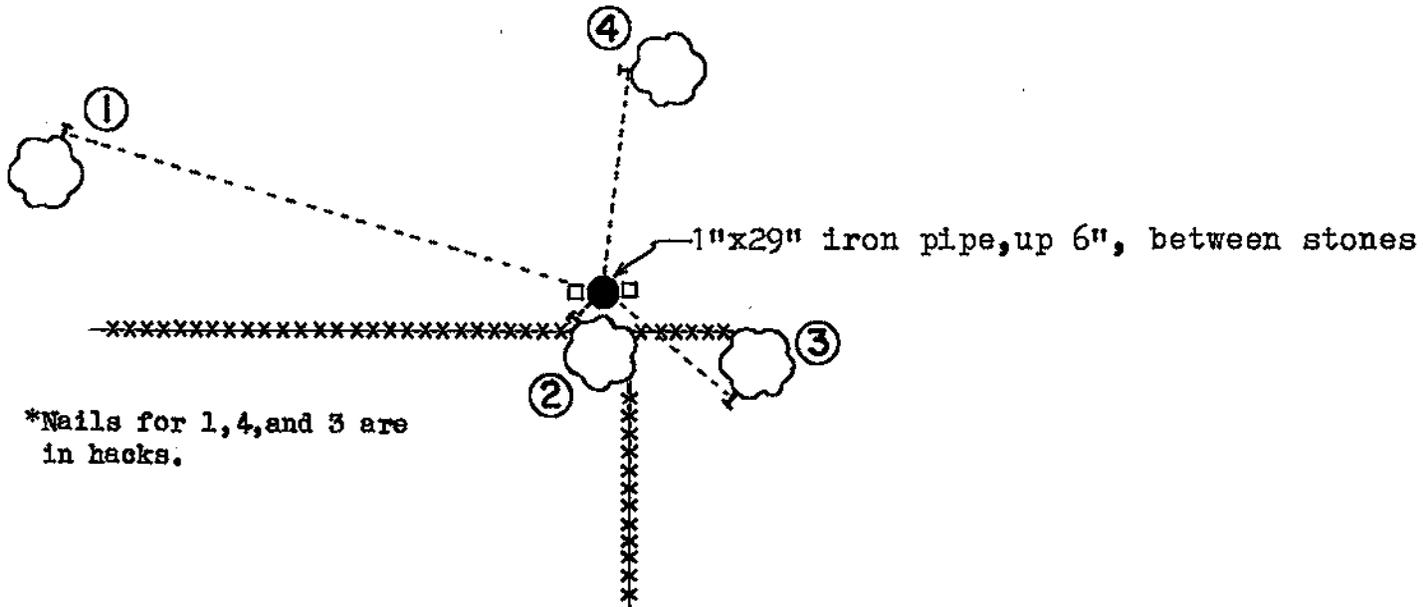

PLAN VIEW DRAWING OF REFERENCE TIES

MAP SHOWING DISTANCE AND DIRECTION TO OTHER PUBLIC LAND SURVEY CORNERS USED FOR REESTABLISHING THE CORNER

See Carlson's section summary of Section 30, dated 5/15/78.

I, William C. Jung, Deputy County Surveyor,
 HEREBY CERTIFY THAT THE CORNER LOCATION SHOWN ON THIS RECORD
 WAS DETERMINED BY ME OR UNDER MY DIRECTION AND CONTROL AND
 THAT THIS U. S. PUBLIC LAND SURVEY MONUMENT RECORD IS CORRECT
 AND COMPLETE TO THE BEST OF MY KNOWLEDGE AND BELIEF.

William C. Jung
 Signature

2/11/86
 Date

