


21605310000

U. S. PUBLIC LAND SURVEY MONUMENT RECORD

SECTION 31 T 16 N, R 5 W, TOWN OF BANGOR & WASHINGTON
 LA CROSSE COUNTY Town Line

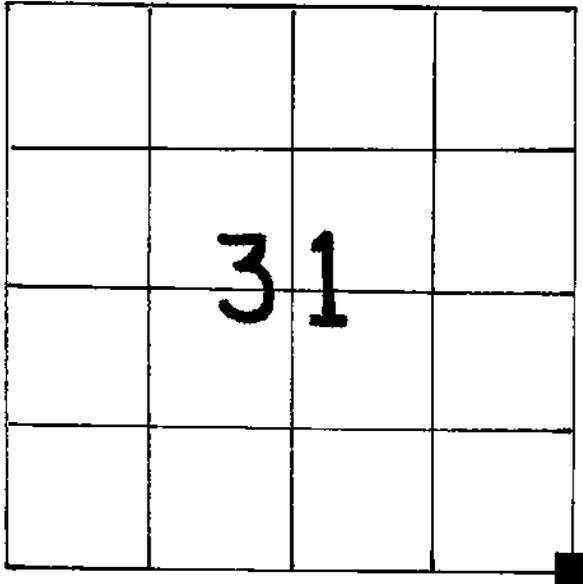

LOCATION OF LANDMARK

Crew: WILLIAM C. JUNG
 PETER F. FOLLANSBEE

Date: 5/13/1991

Describe any record evidence, monument evidence, testimonial evidence or any other material evidence you considered and whether the monument was found or restored through acceptance of an obliterated evidence location.

I accepted this stone as the best available evidence of the original government corner position.

Describe or show any material discrepancy between the location of the restored corner and that of the corner previously restored or reestablished.

None known

WISCONSIN COORDINATE SYSTEM

North

East

Theta Angle

Horiz. Order

Vert. Order

TYPE OF LANDMARK

Found 6" square Stone

BEARINGS ARE REFERENCED TO

