


21605312000

U. S. PUBLIC LAND SURVEY MONUMENT RECORD

SECTION 31 T 16 N, R 5 W, TOWN OF Bangor
 LA CROSSE COUNTY

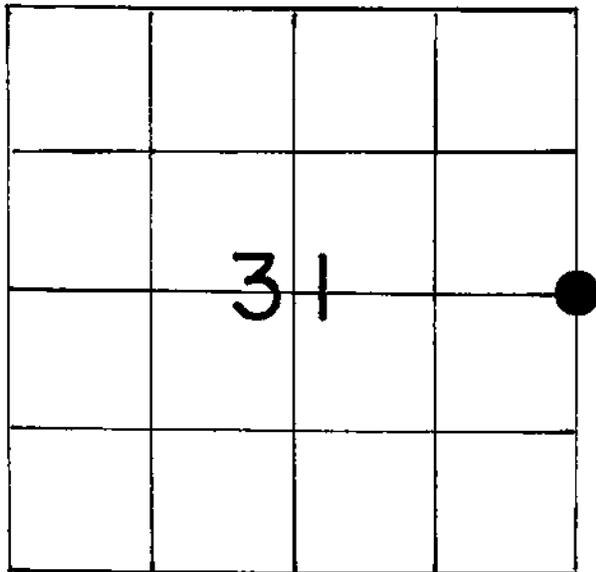

LOCATION OF LANDMARK

Crew; William C. Jung

Date: 4/30/1993

Describe any record evidence, monument evidence, testimonial evidence or any other material evidence you considered and whether the monument was found or restored through acceptance of an obliterated evidence location.

I set this corner by single proportionate measurement. There was a stone here, but Elmer Schomburg told me that back in the 1920's when he was about 13, his older brother, much to his father's dismay, removed the old stone and deposited it down by the creek.

Describe or show any material discrepancy between the location of the restored corner and that of the corner previously restored or reestablished.

None known.

WISCONSIN COORDINATE SYSTEM

North

East

Theta Angle

Horiz. Order

Vert. Order

TYPE OF LANDMARK

1/4" iron pipe buried in a field

BEARINGS ARE REFERENCED TO


True

RECORD OF DURABLE WITNESS MONUMENTS

NO	DESCRIPTION	BEARING	DISTANCE
1	Geodetic survey marker South of C.T.H. "I"	N89°50'46"W	2524.06 ft.
2			
3			
4			



E. 1/4-Cor., Sec. 31-16-5.
 Buried a 1 1/4" x 29" Iron Pipe
 down 17" in the field and 150'±
 North of the creek centerline.
No other ties nearby.

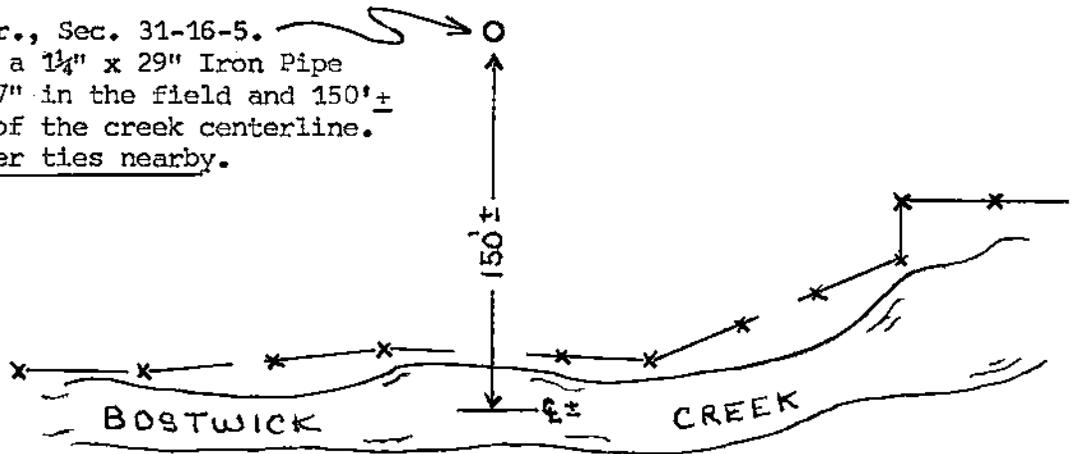


(not to scale)

PLAN VIEW DRAWING OF REFERENCE TIES

MAP SHOWING DISTANCE AND DIRECTION TO OTHER PUBLIC LAND SURVEY CORNERS USED FOR REESTABLISHING THE CORNER

(not to scale)

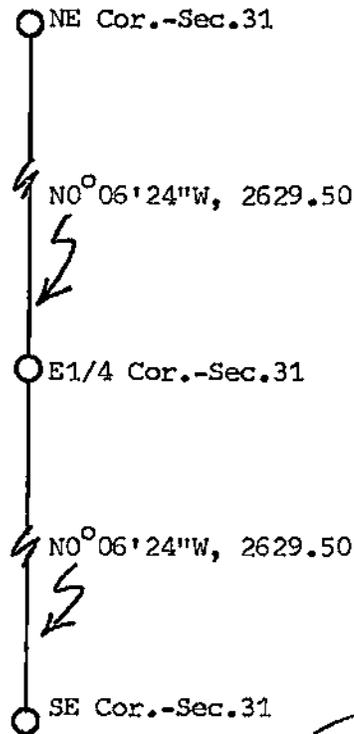

I, William C. Jung, County Surveyor,
 HEREBY CERTIFY THAT THE CORNER LOCATION SHOWN ON THIS RECORD
 WAS DETERMINED BY ME OR UNDER MY DIRECTION AND CONTROL AND
 THAT THIS U. S. PUBLIC LAND SURVEY MONUMENT RECORD IS CORRECT
 AND COMPLETE TO THE BEST OF MY KNOWLEDGE AND BELIEF.

William C. Jung
 Signature


1/17/94
 Date



Seal

 U. S. PUBLIC LAND SURVEY MONUMENT RECORD

 SECTION 32, T.16N., R.5W., TOWN OF BANGOR,
 LACROSSE COUNTY, WISCONSIN

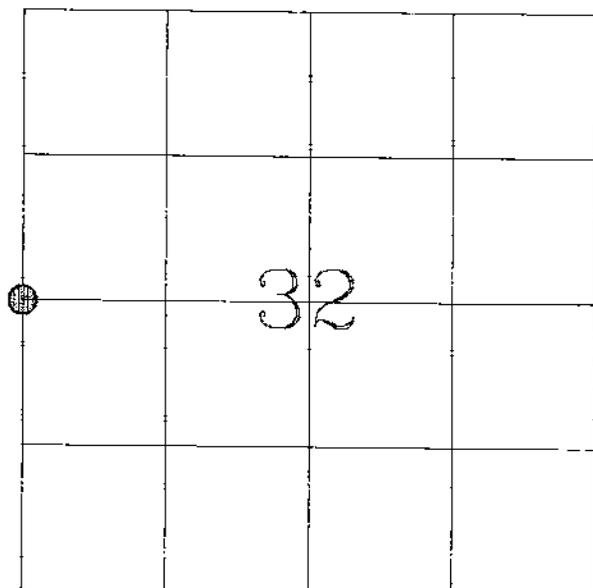

LOCATION OF LANDMARK

 Crew: Rooney H. Maxwell
 Laurence E. Johns III

Date: 12 December 2000

WISCONSIN COORDINATE SYSTEM	
North	
East	
Theta Angle	
Horiz. Order	
Vert. Order	
TYPE OF LANDMARK:	
Found 1 1/4" Iron Pipe	
BEARINGS ARE REFERENCED TO:	
Assumed	

 Describe any record evidence, monument evidence, testimonial evidence or any other material evidence you considered and whether the monument was found or restored through acceptance of an obliterated evidence location.


Recovered the 1 1/4" Iron Pipe set by W. Jung in 1994 as referenced on the tie sheet on file in the County Surveyor's files. Established new ties to the corner.

 Describe or show any material discrepancy between the location of the restored corner and that of the corner previously restored or reestablished.

None.

RECORD OF DURABLE WITNESS MONUMENTS

NO.	DESCRIPTION	BEARING	DISTANCE
1	3/8" x 12" Iron Rod at Base of Large Oak Tree	N 37°41'44" E	812.5'
2	3/8" x 12" Iron Rod	S 84°26'01" E	313.0'
3	3/8" x 12" Iron Rod	S 09°37'29" W	96.5'
4	3/8" x 12" Iron Rod	S 72°18'56" W	220.8'

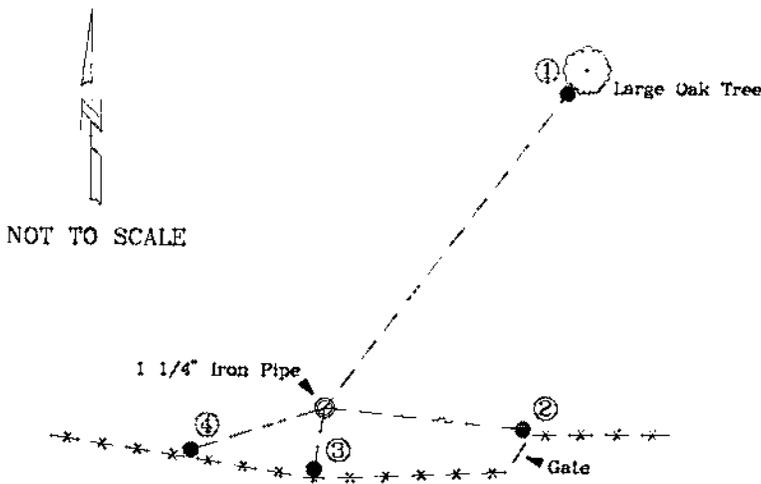


Note. Points 2, 3, & 4 are set next to wooden fence posts

The 1 1/4" iron pipe was found approx. 16' below the surface in a cornfield.

PLAN VIEW DRAWING OF REFERENCE TIES

MAP SHOWING DISTANCE AND DIRECTION TO OTHER PUBLIC LAND SURVEY CORNERS USED FOR REESTABLISHING THE CORNER

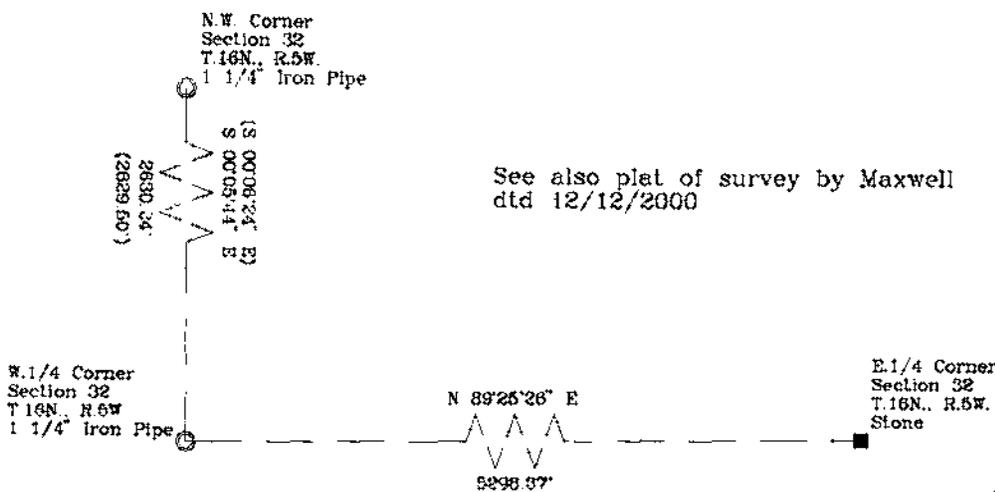

I, RODNEY H. MAXWELL, REGISTERED LAND SURVEYOR, HEREBY CERTIFY THAT THE CORNER LOCATION SHOWN ON THIS RECORD WAS DETERMINED BY ME OR UNDER MY DIRECTION AND CONTROL, AND THAT THIS U. S. PUBLIC LAND SURVEY MONUMENT RECORD IS CORRECT AND COMPLETE TO THE BEST OF MY KNOWLEDGE AND BELIEF.

Rodney H. Maxwell
 Rodney H. Maxwell
 Maxwell Surveying
 7457 Highway 16, Suite C
 Sparta, Wisconsin
 12 December 2000

