


21605320000

U. S. PUBLIC LAND SURVEY MONUMENT RECORD

SECTION 32 T 16 N, R 5 W, TOWN OF BANGOR

LA CROSSE COUNTY

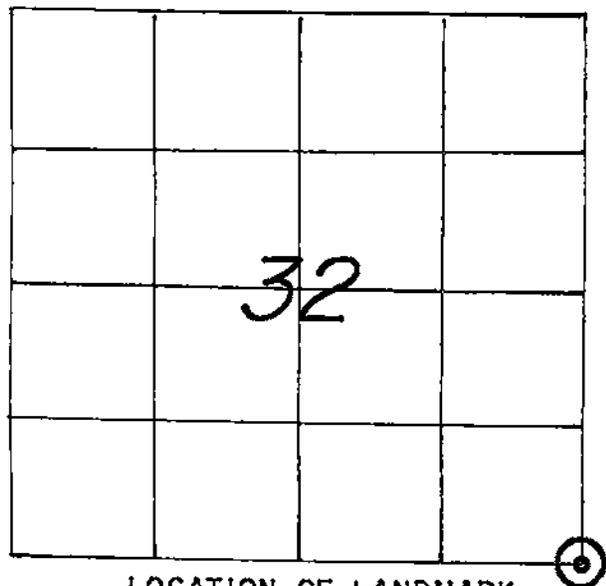

LOCATION OF LANDMARK

CREW: WILLIAM C. JUNG
 PETER F. FOLLANSBEE
 DATE: 10/03/2006

WISCONSIN COORDINATE SYSTEM

North 662,142.558

East 1,707,017.583

Theta Angle

Horiz. Order

Vert. Order

DATUM: 1983 ('91)

TYPE OF LANDMARK

3/4"x30" IRON BAR WITH A RED PLASTIC CAP.

BEARINGS ARE REFERENCED TO

GRID NORTH AS PER SECTION DATA.

Describe any record evidence, monument evidence, testimonial evidence or any other material evidence you considered and whether the monument was found or restored through acceptance of an obliterated evidence location.


Bliss set a stone at this corner in 1867. We searched at great length for this stone back in 2000. Rodney Maxwell looked for this stone too as did Chris Fechner. I believe that the stone was either washed, bulldozed, or plowed out. Paul Fairchild set an iron bar at the single proportionate position. We replaced his iron bar with ours and buried it in the field, down a foot or so. Given the field evidence, I believe that setting this corner "by law" was the best solution.

Describe or show any material discrepancy between the location of the restored corner and that of the corner previously restored or reestablished.

NONE KNOWN.


RECORD OF DURABLE WITNESS MONUMENTS

NO	DESCRIPTION	MAGNETIC	
		BEARING	DISTANCE
1	SET A NAIL IN N.E.-SIDE OF A 21" WALNUT	N 75° W	120.75 FT.
2	EX. IRON BAR IN THE N.-SIDE OF A FIELD STONE BERM	N 16° E	20.10 FT.
3	SET A NAIL IN N.W.-SIDE OF A 55" COTTONWOOD	N 36° E	47.00 FT.
4	SET A NAIL IN N.-SIDE OF A 9" WALNUT	N 82° E	35.77 FT.

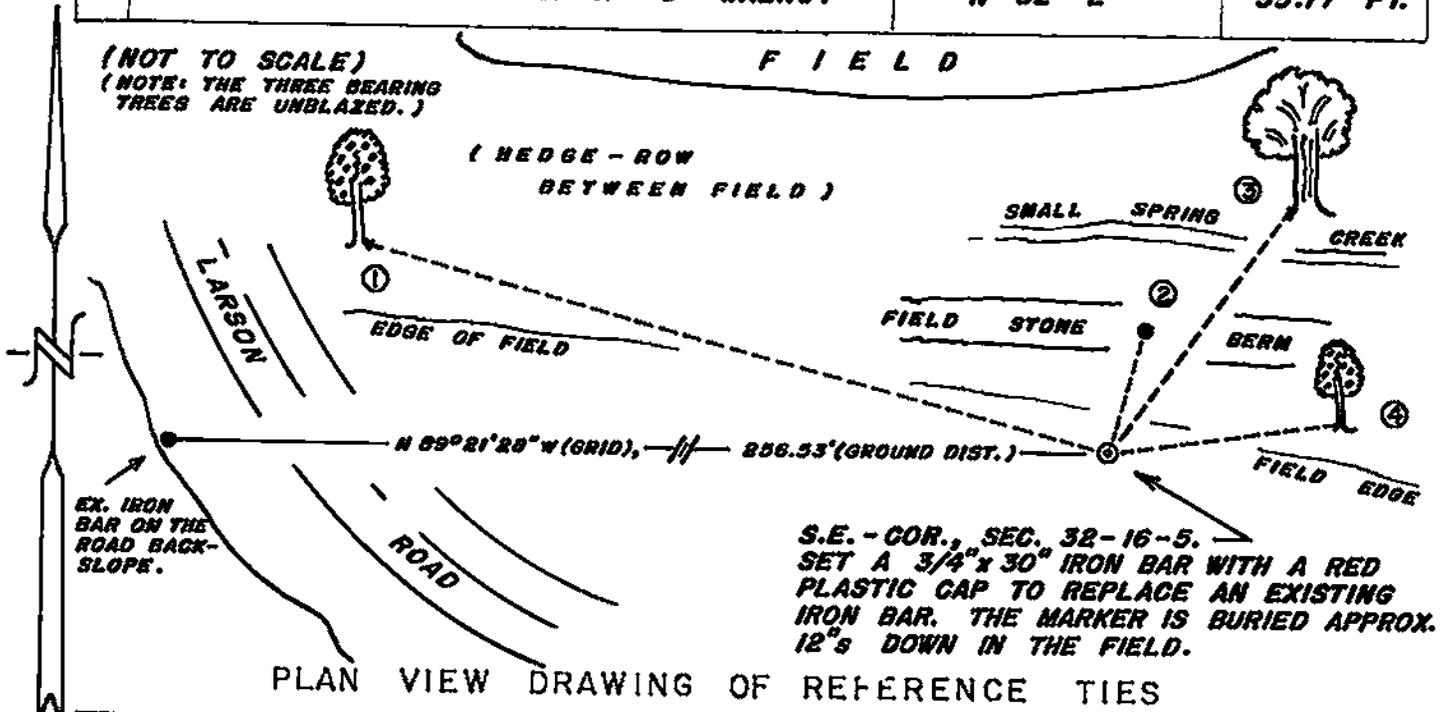

MAP SHOWING DISTANCE AND DIRECTION TO OTHER PUBLIC LAND SURVEY CORNERS USED FOR REESTABLISHING THE CORNER

(GRID BEARINGS AND DISTANCES)
(GRID FACTOR: 0.999898)
(NOT TO SCALE)

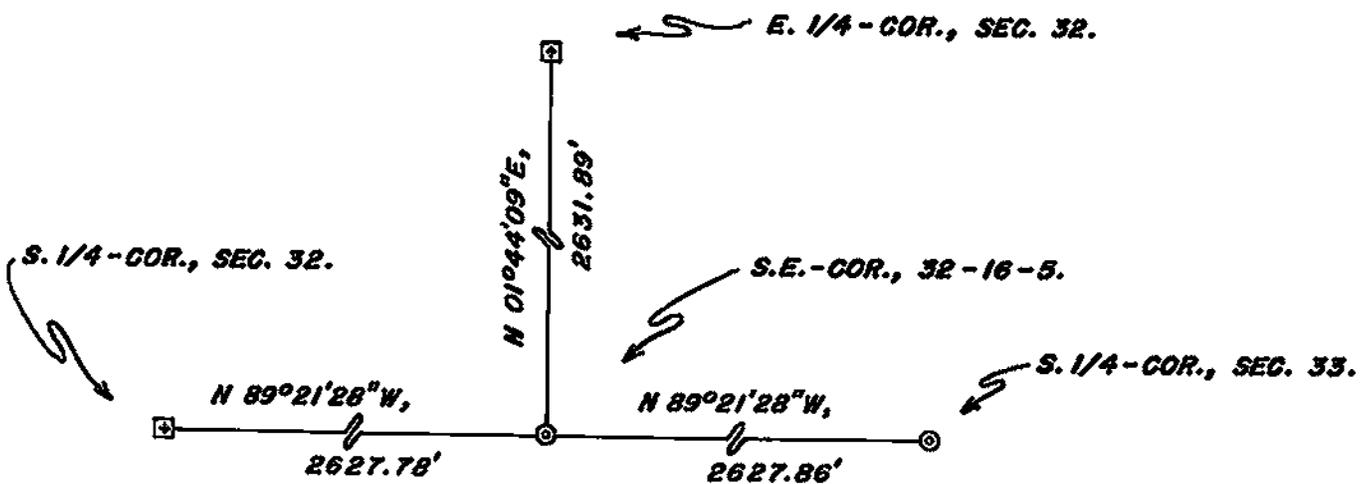

I, WILLIAM C. JUNG, COUNTY SURVEYOR
HEREBY CERTIFY THAT THE CORNER LOCATION SHOWN ON THIS RECORD
WAS DETERMINED BY ME OR UNDER MY DIRECTION AND CONTROL AND
THAT THIS U. S. PUBLIC LAND SURVEY MONUMENT RECORD IS CORRECT
AND COMPLETE TO THE BEST OF MY KNOWLEDGE AND BELIEF.

William C. Jung 1/9/07
Signature Date



Seal