


21605320020

U. S. PUBLIC LAND SURVEY MONUMENT RECORD

SECTION 32 T 16 N, R 5 W, TOWN OF BANGOR & WASHINGTON
 LA CROSSE COUNTY Town Line

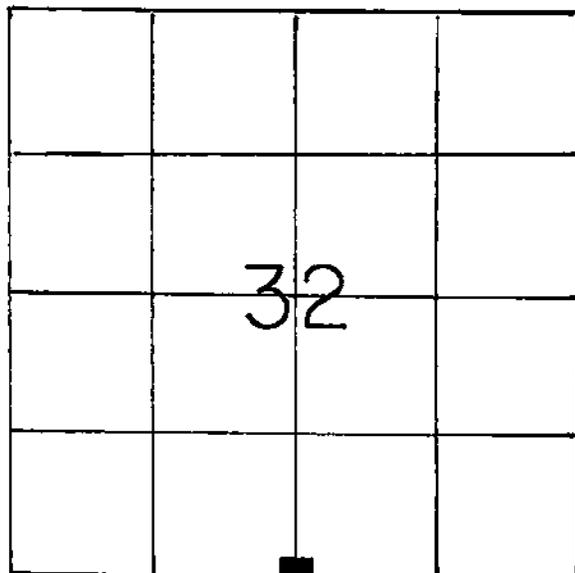

LOCATION OF LANDMARK

Crew: WILLIAM C. JUNG
 PETER F. FOLLANSBEE

Date: 5/14/1991

Describe any record evidence, monument evidence, testimonial evidence or any other material evidence you considered and whether the monument was found or restored through acceptance of an obliterated evidence location.

I accepted this corner (stone) as the best available evidence of the original government corner position.

Describe or show any material discrepancy between the location of the restored corner and that of the corner previously restored or reestablished.

None known

WISCONSIN COORDINATE SYSTEM
North
East
Theta Angle
Horiz. Order
Vert. Order
TYPE OF LANDMARK
Found 6" square stone
BEARINGS ARE REFERENCED TO

