


21605330020

U. S. PUBLIC LAND SURVEY MONUMENT RECORD

SECTION 33 T 16 N, R 5 W, TOWN OF BANGOR
 LA CROSSE COUNTY

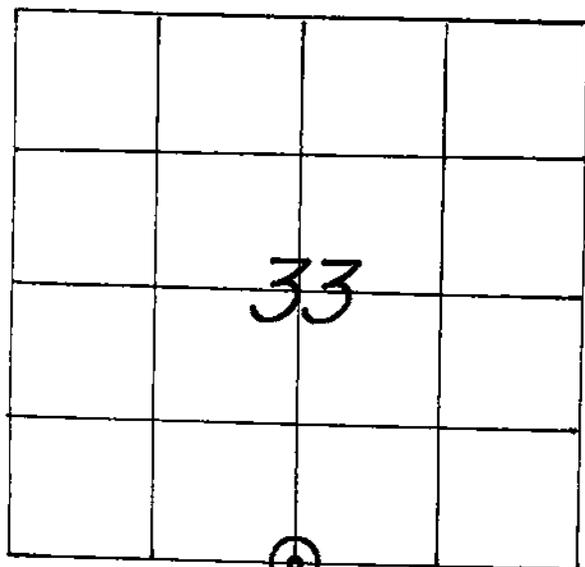

LOCATION OF LANDMARK

CREW: WILLIAM C. JUNG
 PETER F. FOLLANSBEE
 DATE: 9/23/2005

WISCONSIN COORDINATE SYSTEM	
North	662,113.099
East	1,709,645.282
Theta Angle	
Horiz. Order	
Vert. Order	
DATUM:	1983('91)
TYPE OF LANDMARK	
3/4" x 30" IRON BAR WITH A RED PLASTIC CAP.	
BEARINGS ARE REFERENCED TO	
GRID NORTH AS PER SECTION DATA.	

Describe any record evidence, monument evidence, testimonial evidence or any other material evidence you considered and whether the monument was found or restored through acceptance of an obliterated evidence location.

I found an old downed tree on the slope to the Northeast back in April of 2000. I believe that this tree is the original bearing tree. The corner was set off of this tree using the original government survey call. I dug and probed in the field searching for the Bliss stone but could not find it. The East-West fence to the North fits the 1931 distance as called for in Volume 164, Page 321. I set an iron bar with a cap at the corner, down 11"

Describe or show any material discrepancy between the location of the restored corner and that of the corner previously restored or reestablished.

The iron bar found N76°E, 9.1 feet from my corner was set by Rodney Maxwell. If it was intended to be the corner, I do not agree with it.

