


21605332000

U. S. PUBLIC LAND SURVEY MONUMENT RECORD

SECTION 34 T 16 N, R 5 W, TOWN OF BANGOR

LA CROSSE COUNTY

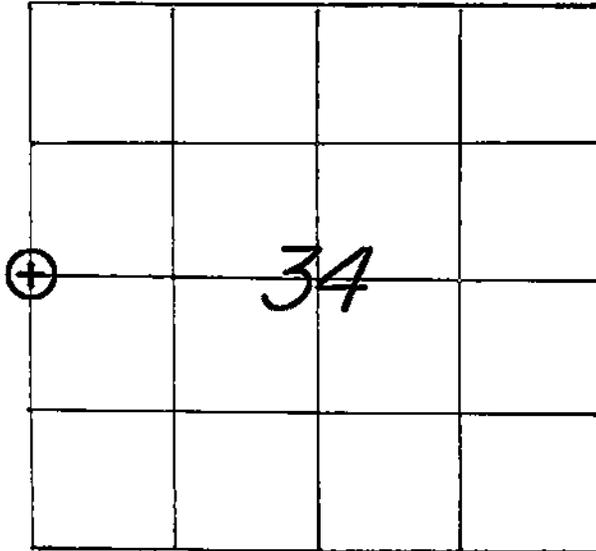

LOCATION OF LANDMARK

CREW: WILLIAM G. JUNG
 PETER F. FOLLANSBEE
 DATE: 10/20/2005

WISCONSIN COORDINATE SYSTEM	
North	664,694.970
East	1,712,351.077
Theta Angle	
Horiz. Order	
Vert. Order	
DATUM:	1983('91)
TYPE OF LANDMARK	
3/4" x 30" IRON BAR WITH AN ALUMINUM CAP.	
BEARINGS ARE REFERENCED TO	
GRID NORTH AS PER SECTION DATA.	


Describe any record evidence, monument evidence, testimonial evidence or any other material evidence you considered and whether the monument was found or restored through acceptance of an obliterated evidence location.

Mr. Bouska, the nearby landowner who has owned and farmed around this corner for many years, recalled the stone from 1867. He said eventually after hitting the stone repeatedly over the years with his plow, the top of the stone broke off. He took the top out of the field and discarded it. Digging and probing, I searched at length for the stone but was unsuccessful. I set the iron bar down 15" in the old field. The corner was set by single proportionate measurement. The rest of the stone may also have been plowed or dragged out.


NONE KNOWN.

RECORD OF DURABLE WITNESS MONUMENTS

NO	DESCRIPTION	GRID BEARINGS	GRID DISTANCES
		BEARING	DISTANCE
1	SET A 3/4"x30" IRON BAR WITH AN ALUMINUM CAP	N 04°31'38" W	212.32 FT.
2	SET A 3/4"x30" IRON BAR WITH A RED PLASTIC CAP	N 25°25'54" E	201.46 FT.
3	SET A 3/4"x30" IRON BAR WITH A RED PLASTIC CAP	N 54°14'03" E	201.00 FT.
4	SET A 3/4"x30" IRON BAR WITH A RED PLASTIC CAP	N 77°28'15" E	245.51 FT.

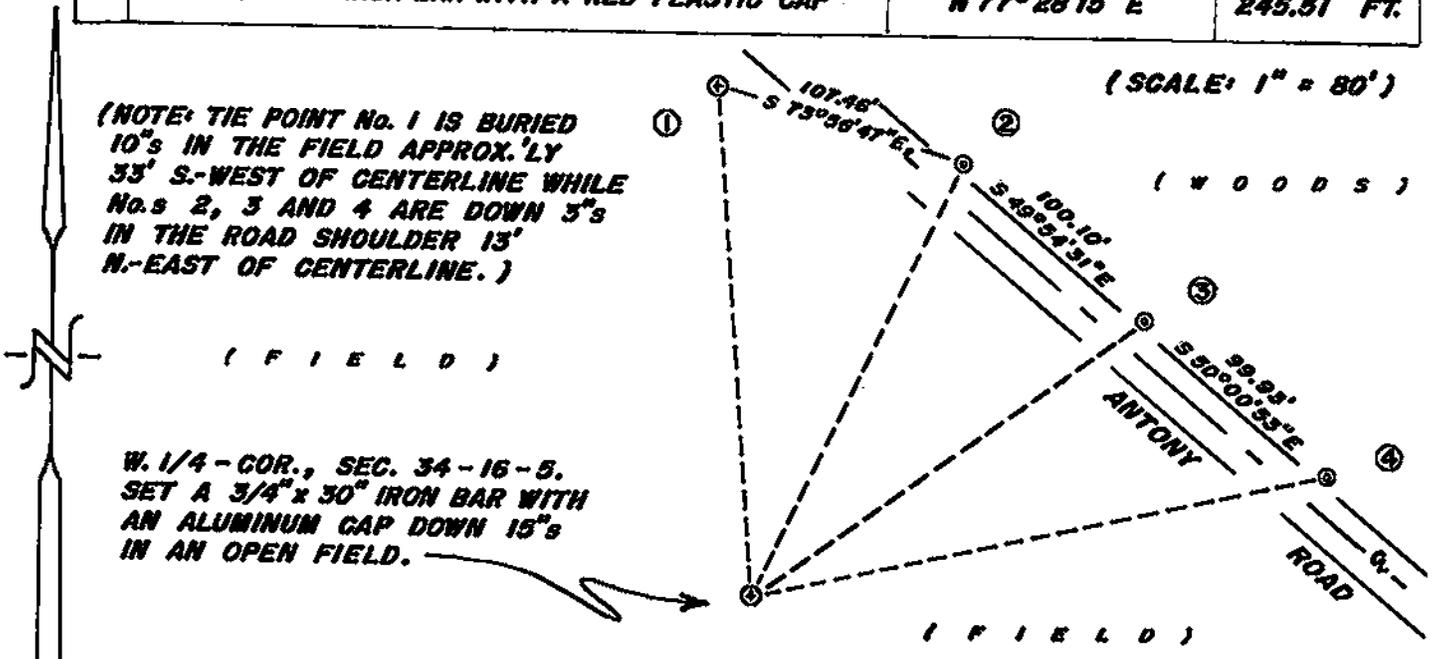

MAP SHOWING DISTANCE AND DIRECTION TO OTHER PUBLIC LAND SURVEY CORNERS USED FOR REESTABLISHING THE CORNER

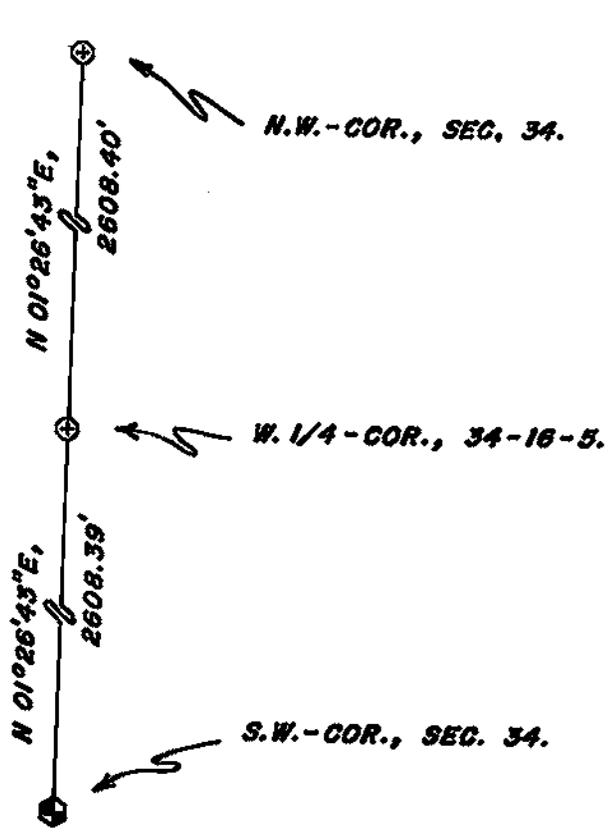

I, WILLIAM C. JUNG, COUNTY SURVEYOR
HEREBY CERTIFY THAT THE CORNER LOCATION SHOWN ON THIS RECORD WAS DETERMINED BY ME OR UNDER MY DIRECTION AND CONTROL AND THAT THIS U. S. PUBLIC LAND SURVEY MONUMENT RECORD IS CORRECT AND COMPLETE TO THE BEST OF MY KNOWLEDGE AND BELIEF.

William C. Jung 11/17/05
Signature Date



Seal