


21605352000

U. S. PUBLIC LAND SURVEY MONUMENT RECORD

SECTION 35 T 16 N, R 5 W, TOWN OF BANGOR
 LA CROSSE COUNTY

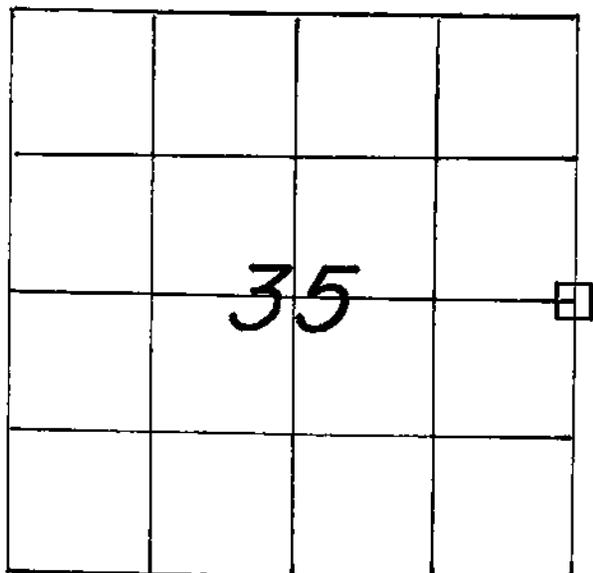

LOCATION OF LANDMARK

WISCONSIN COORDINATE SYSTEM

North

East

Theta Angle

Horiz. Order

Vert. Order

TYPE OF LANDMARK

Existing 6" square Stone.

BEARINGS ARE REFERENCED TO

Crew: WILLIAM C. JUNG
 PETER F. FOLLANSBEE
 Date: 4/04/1996

Describe any record evidence, monument evidence, testimonial evidence or any other material evidence you considered and whether the monument was found or restored through acceptance of an obliterated evidence location.

I found a stone at the corner and accepted it as the best available evidence of the original government corner position.


Describe or show any material discrepancy between the location of the restored corner and that of the corner previously restored or reestablished.

None Known.

RECORD OF DURABLE WITNESS MONUMENTS

MAGNETIC

NO	DESCRIPTION	BEARING	DISTANCE
1	Set P.K. Nail in NE-side 13" Bl. Oak	N 55°W	16.49 Ft.
2	Set P.K. Nail in NW-side 10" Wh. Oak	N 43°E	35.24 Ft.
3	Set P.K. Nail in NW-side 13" Wh. Oak	N 56°E	40.50 Ft.
4	Set P.K. Nail in NW-side 13" Wh. Oak	N 81°E	32.92 Ft.

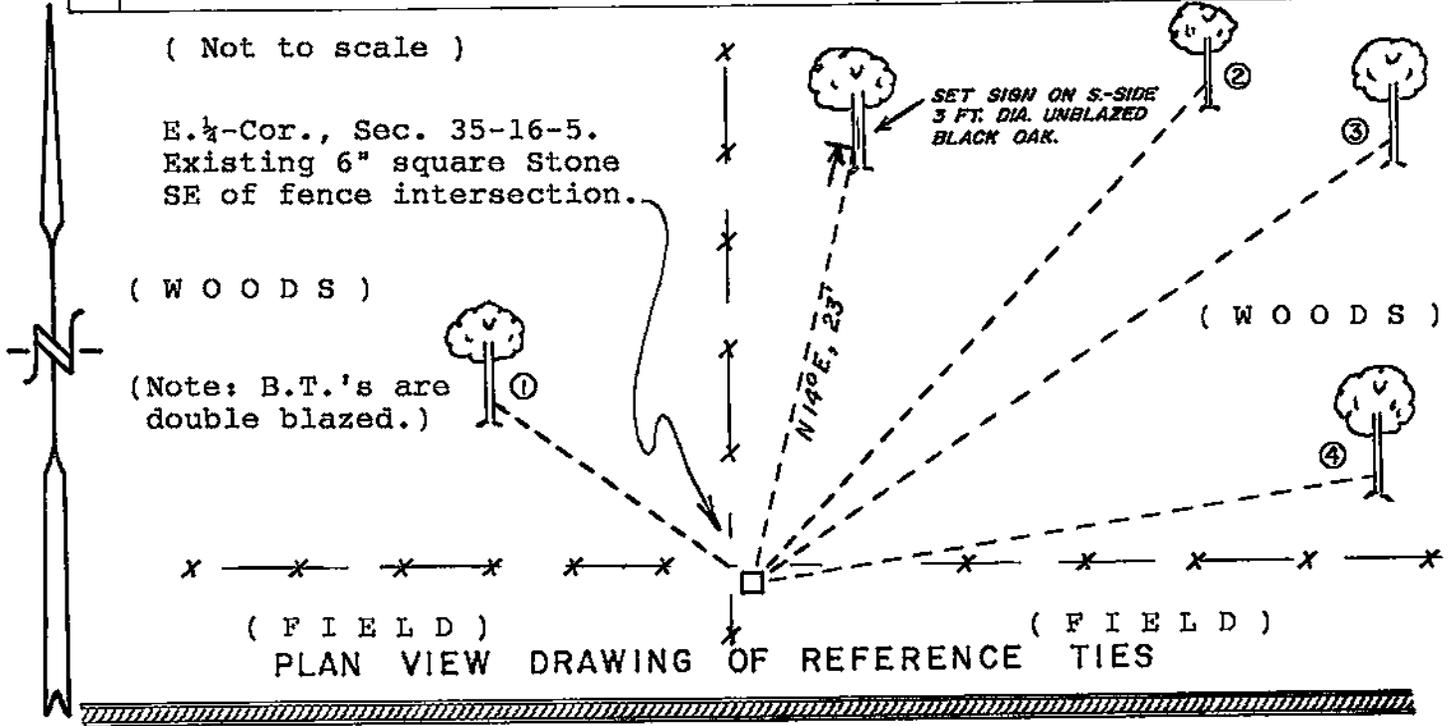


MAP SHOWING DISTANCE AND DIRECTION TO OTHER PUBLIC LAND SURVEY CORNERS USED FOR REESTABLISHING THE CORNER

No section measurements were made by me at this time.

I, William C. Jung, County Surveyor
HEREBY CERTIFY THAT THE CORNER LOCATION SHOWN ON THIS RECORD
WAS DETERMINED BY ME OR UNDER MY DIRECTION AND CONTROL AND
THAT THIS U. S. PUBLIC LAND SURVEY MONUMENT RECORD IS CORRECT
AND COMPLETE TO THE BEST OF MY KNOWLEDGE AND BELIEF.

William C. Jung
Signature

6/6/96
Date

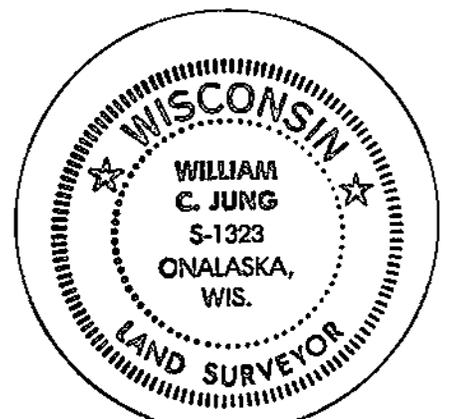

Seal