


U. S. PUBLIC LAND SURVEY MONUMENT RECORD

SECTION 7 T 16 N, R 5 W, TOWN OF Bangor

LA CROSSE COUNTY

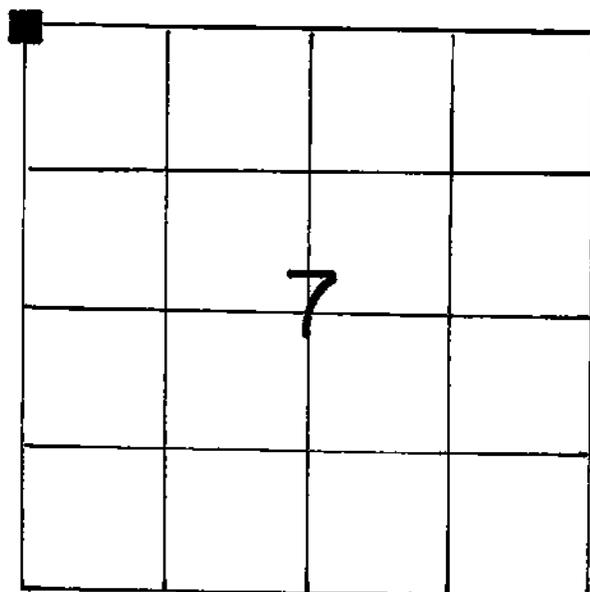

LOCATION OF LANDMARK

WISCONSIN COORDINATE SYSTEM
North
East
Theta Angle
Horiz. Order
Vert. Order
TYPE OF LANDMARK
Stone
BEARINGS ARE REFERENCED TO

Crew: William C. Jung  
Peter Follansbee

Date: 1/11/89

Witness: Willard Kolterman

Describe any record evidence, monument evidence, testimonial evidence or any other material evidence you considered and whether the monument was found or restored through acceptance of an obliterated evidence location.


I found a 6" square stone at the corner and accepted it as the best available evidence of the original government corner position. Mr. Kolterman said that the stone had always been there and had never been disturbed. Due to erosion and time however, the stone was off plumb, so we plumbd it up. The stone is scribed with the section numbers and is 2' South of the fence.

Describe or show any material discrepancy between the location of the restored corner and that of the corner previously restored or reestablished.

None known.

RECORD OF DURABLE WITNESS MONUMENTS

NO	DESCRIPTION	BEARING	DISTANCE
1	P.K. nail in unblazed 30" white oak	N67°E ±	slope=232'
2	P.K. nail in unblazed 32" white oak	East ±	slope=226.7'
3			
4			

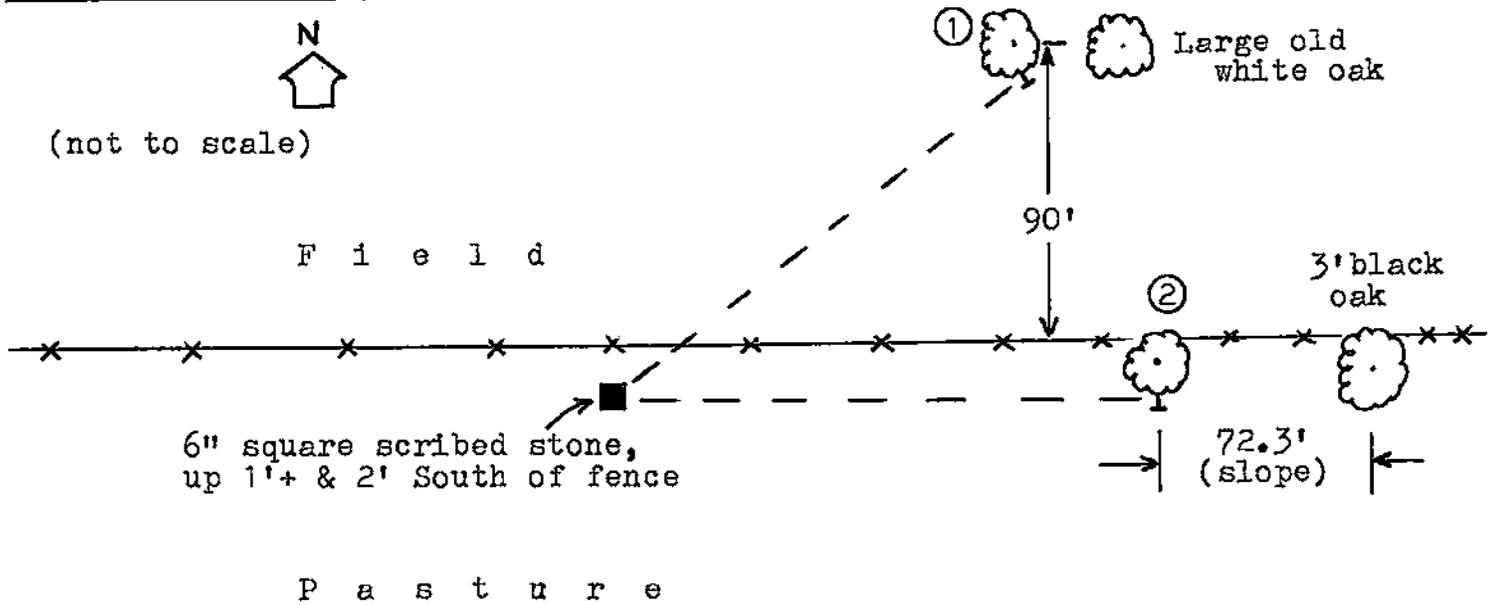

PLAN VIEW DRAWING OF REFERENCE TIES

MAP SHOWING DISTANCE AND DIRECTION TO OTHER PUBLIC LAND SURVEY CORNERS USED FOR REESTABLISHING THE CORNER

(no measurements made by me at this time)

I, William C. Jung, Deputy County Surveyor,  
 HEREBY CERTIFY THAT THE CORNER LOCATION SHOWN ON THIS RECORD  
 WAS DETERMINED BY ME OR UNDER MY DIRECTION AND CONTROL AND  
 THAT THIS U. S. PUBLIC LAND SURVEY MONUMENT RECORD IS CORRECT  
 AND COMPLETE TO THE BEST OF MY KNOWLEDGE AND BELIEF.

William C. Jung  
 Signature

1/12/89  
 Date

