


21606012000

U. S. PUBLIC LAND SURVEY MONUMENT RECORD

SECTION 6 T 16 N, R 5 W, TOWN OF BANGOR

LA CROSSE COUNTY

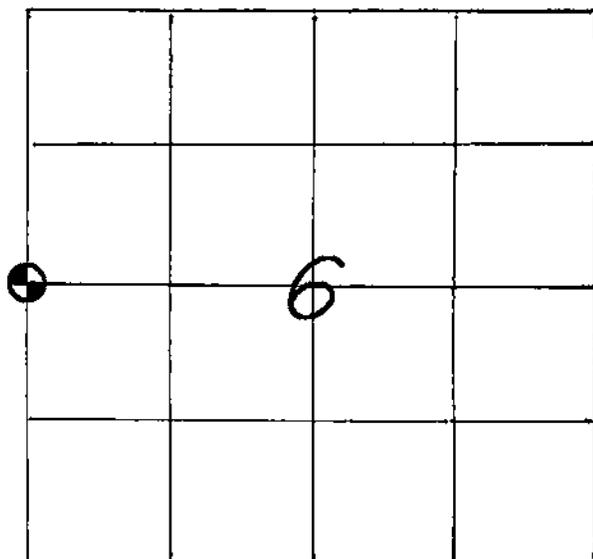

LOCATION OF LANDMARK

CREW: WILLIAM C. JUNG
 PETER F. FOLLANSBEE
 DATE: 9/09/1997

Crew: William C. Jung
 Peter F. Follansbee
 Date: 9/27/07

WISCONSIN COORDINATE SYSTEM

North

East

Theta Angle

Horiz. Order

Vert. Order

TYPE OF LANDMARK

BRASS CAP LUNDE MARKER.

BEARINGS ARE REFERENCED TO

TRUE NORTH ($\pm 02'$)

Describe any record evidence, monument evidence, testimonial evidence or any other material evidence you considered and whether the monument was found or restored through acceptance of an obliterated evidence location.

I found an iron pipe at the corner that had been used in previous survey work. I accepted this pipe as the best available evidence of the original government corner position, removed it, and replaced it with a brass capped Lunde marker.

***** 9/27/07


The Lunde marker had been knocked off-plumb by a piece of machinery. We found all four ties in and used them to reset the marker.

Describe or show any material discrepancy between the location of the restored corner and that of the corner previously restored or reestablished.


NONE KNOWN.

RECORD OF DURABLE WITNESS MONUMENTS

NO	DESCRIPTION	BEARING	DISTANCE
1	SET A 3/4" x 30" ROUND IRON BAR	WEST ±	20.00 FT.
2	SET A 3/4" x 30" ROUND IRON BAR	NORTH ±	20.13 FT.
3	SET A 3/4" x 30" ROUND IRON BAR	EAST ±	20.07 FT.
4	SET A 3/4" x 30" ROUND IRON BAR	SOUTH ±	19.88 FT.

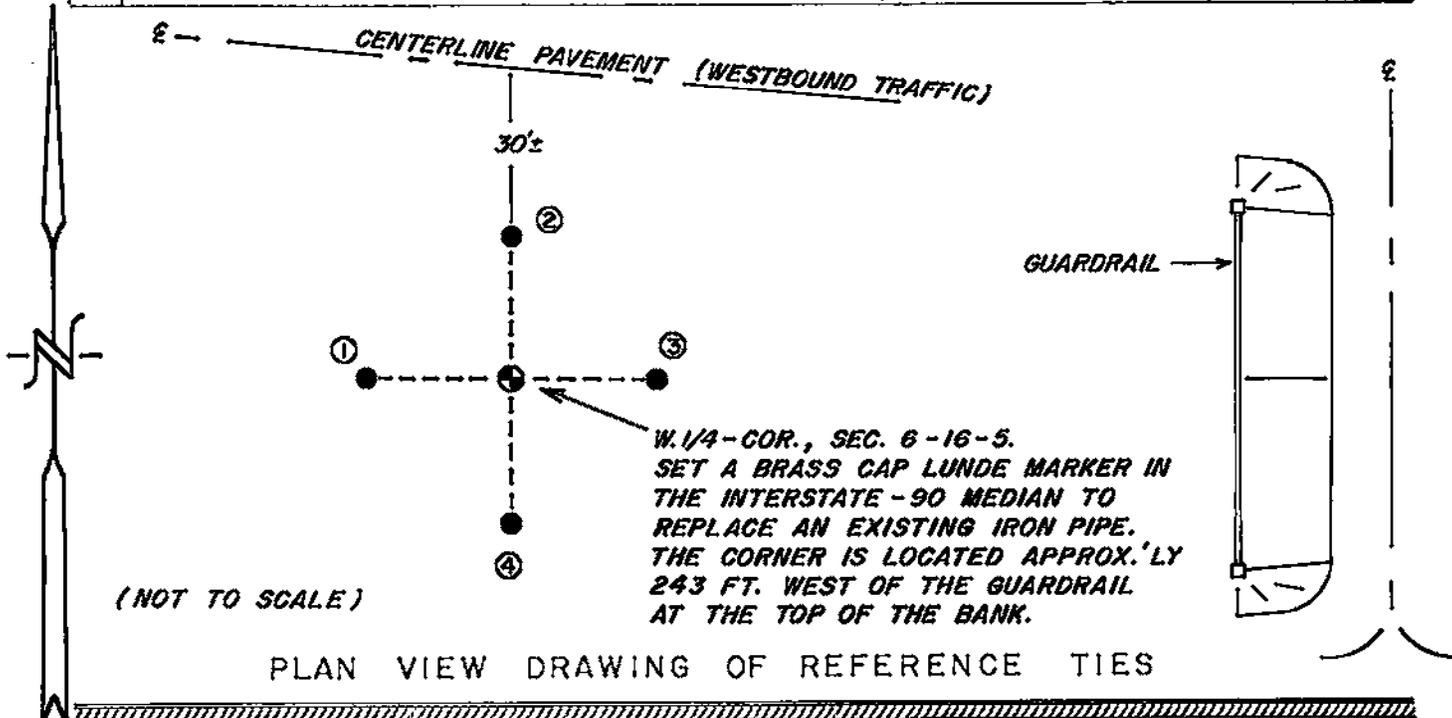

MAP SHOWING DISTANCE AND DIRECTION TO OTHER PUBLIC LAND SURVEY CORNERS USED FOR REESTABLISHING THE CORNER

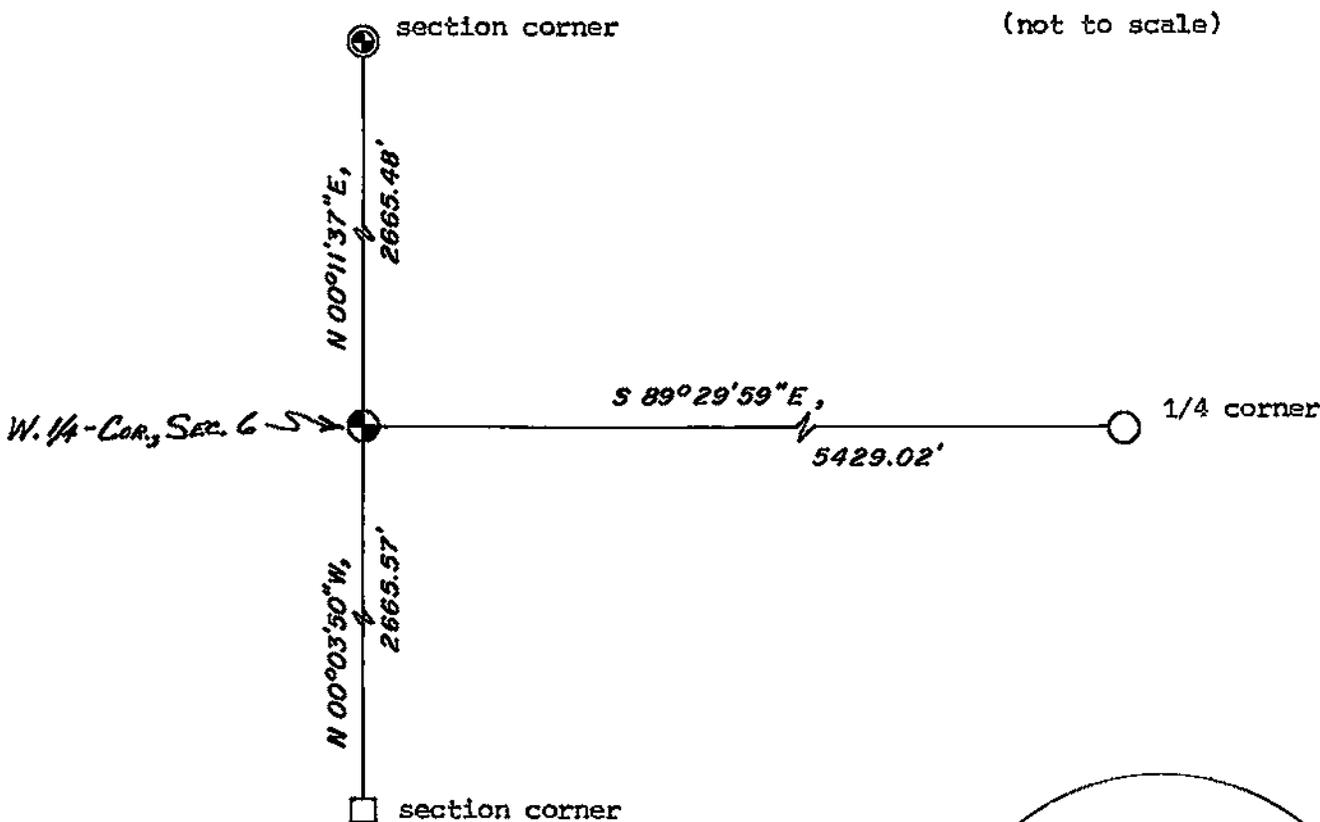

I, WILLIAM C. JUNG, COUNTY SURVEYOR
 HEREBY CERTIFY THAT THE CORNER LOCATION SHOWN ON THIS RECORD WAS DETERMINED BY ME OR UNDER MY DIRECTION AND CONTROL AND THAT THIS U. S. PUBLIC LAND SURVEY MONUMENT RECORD IS CORRECT AND COMPLETE TO THE BEST OF MY KNOWLEDGE AND BELIEF.

Signature William C. Jung

Date March 5, 1998

Revised: 9/27/07 wscj

