


## U. S. PUBLIC LAND SURVEY MONUMENT RECORD

SECTION 7 T 16 N, R 5 W, TOWN OF BANGOR

LA CROSSE COUNTY

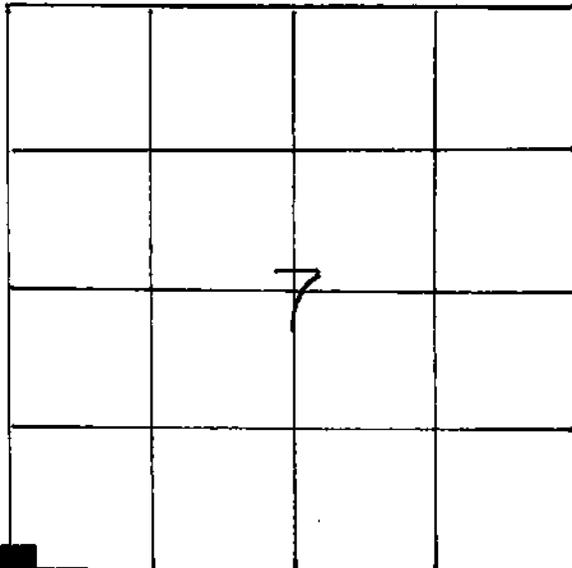

LOCATION OF LANDMARK

Crew: William Jung

Witness: Jared Kotek (age 13)

8/15/84

Describe any record evidence, monument evidence, testimonial evidence or any other material evidence you considered and whether the monument was found or restored through acceptance of an obliterated evidence location.

O. Bergman found a stone at this corner in April of 1953. Fred Kraft found this stone again in 1975. I found the stone at the section corner and accepted it as the best available evidence of the original government corner position. Bergman also found a sandstone South of the 6" square stone. The square stone has the section numbers scribed on it.

Describe or show any material discrepancy between the location of the restored corner and that of the corner previously restored or reestablished.

None known.

WISCONSIN COORDINATE SYSTEM

North

East

Theta Angle

Horiz. Order

Vert. Order


TYPE OF LANDMARK  
STONE

BEARINGS ARE REFERENCED TO

RECORD OF DURABLE WITNESS MONUMENTS

NO	DESCRIPTION	MAGNETIC BEARING	DISTANCE
1	CENTER OF BASE OF 6" UNBLAZED CHERRY TREE	N71°W	24.8'
2	NAIL IN 9" HICKORY, SINGLE-BLAZED	S41°W	59.18'
3	NAIL IN 18" HICKORY, SINGLE-BLAZED	S65°E	12.04'
4	NAIL IN 6" ASPEN, SINGLE-BLAZED	N36°E	39.43'

(Each distance is to a nail in a hack on the side of the tree.)

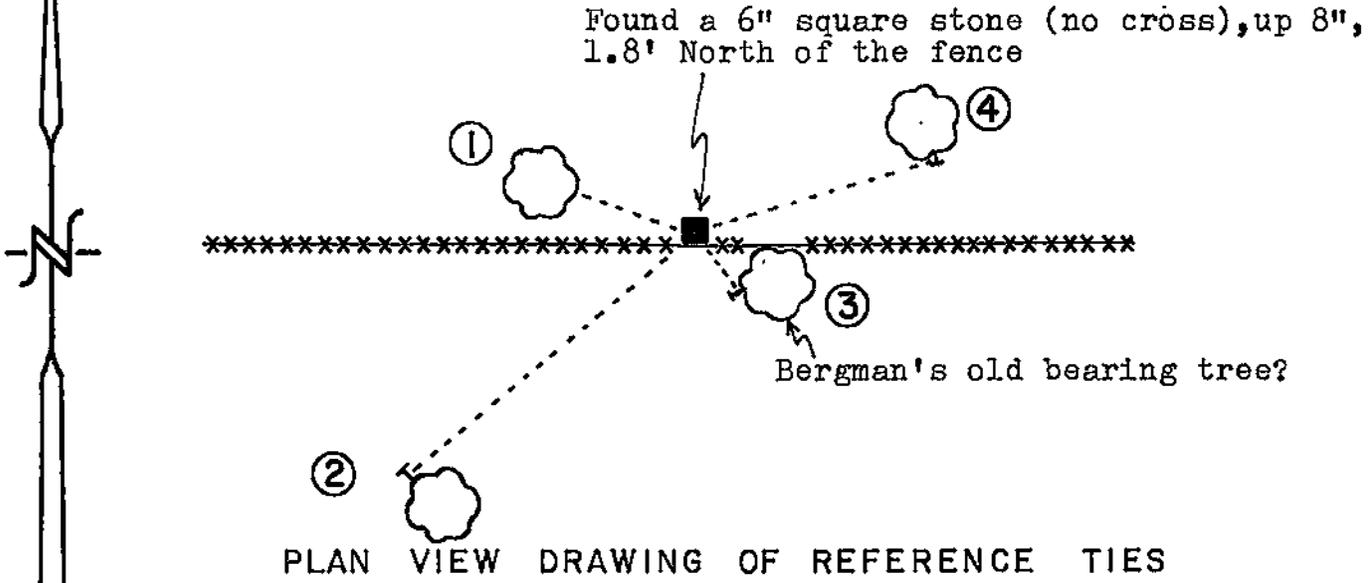

MAP SHOWING DISTANCE AND DIRECTION TO OTHER PUBLIC LAND SURVEY CORNERS USED FOR REESTABLISHING THE CORNER

No measurements made by me at this time. Refer to Kraft's map, dated 12/20/75.

I, William C. Jung, Deputy County Surveyor,  
 HEREBY CERTIFY THAT THE CORNER LOCATION SHOWN ON THIS RECORD  
 WAS DETERMINED BY ME OR UNDER MY DIRECTION AND CONTROL AND  
 THAT THIS U. S. PUBLIC LAND SURVEY MONUMENT RECORD IS CORRECT  
 AND COMPLETE TO THE BEST OF MY KNOWLEDGE AND BELIEF.

William C. Jung  
 Signature

2/13/86  
 Date



Seal