


21606122000

U. S. PUBLIC LAND SURVEY MONUMENT RECORD

SECTION 7 T 16 N, R 5 W, TOWN OF Bangor

LA CROSSE COUNTY

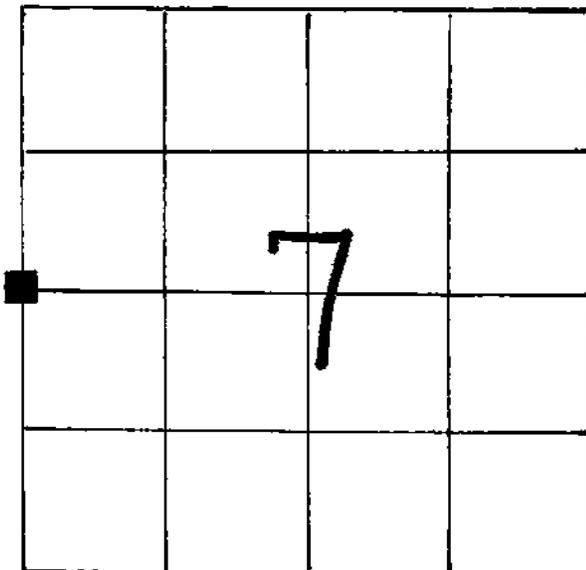

LOCATION OF LANDMARK

WISCONSIN COORDINATE SYSTEM

North

East

Theta Angle

Horiz. Order

Vert. Order

TYPE OF LANDMARK

Stone

BEARINGS ARE REFERENCED TO

Crew: William C. Jung

Date: 5/2/91

Witness: Roy Kolterman

Describe any record evidence, monument evidence, testimonial evidence or any other material evidence you considered and whether the monument was found or restored through acceptance of an obliterated evidence location.


I found a stone at the corner as pointed out to me by Roy Kolterman. His father showed it to him when Roy was a boy. The corner stone was 6" square with the top broken off. I found part of the top at the bottom of the North slope. I buried this top piece by the Northwest side of the stone. As a witness monument, I set a Lunde marker on the Southwest side of the stone. The distance from the center of the Lunde to the center of the stone is 0.27'. The center of "mass" of the stone is the corner. I mounded the corner with field stones. The stone is on the break of the slope, near the West end of the "finger", and East of the sand pit. I accepted this stone as evidence of the original government corner position. Describe or show any material discrepancy between the location of the restored corner and that of the corner previously restored or reestablished.

None known.

RECORD OF DURABLE WITNESS MONUMENTS

Magnetic

NO	DESCRIPTION	BEARING	DISTANCE
1	P.K. nail in double blazed 9" double oak	N52°E	slope = 9.07
2	" 10" " "	S84°E	slope =32.75
3	" 12" oak	S55°E	slope =37.65
4	" 9" white oak	S32°E	horz. =25.60

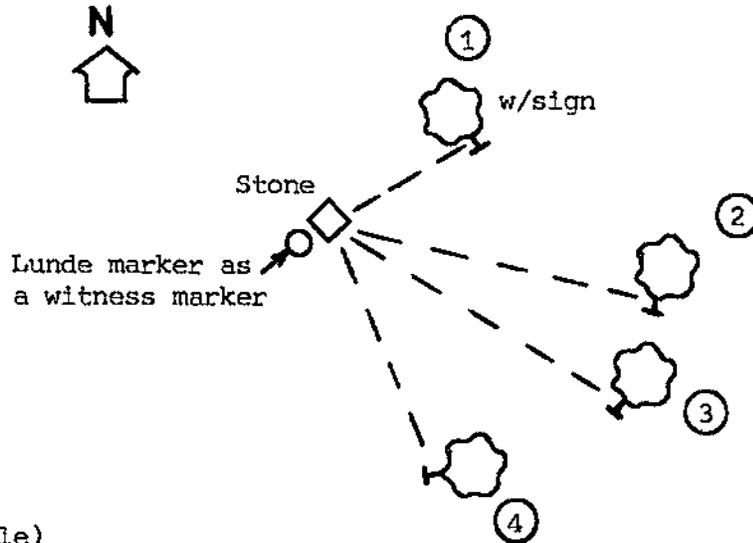

(not to scale)

PLAN VIEW DRAWING OF REFERENCE TIES


MAP SHOWING DISTANCE AND DIRECTION TO OTHER PUBLIC LAND SURVEY CORNERS USED FOR REESTABLISHING THE CORNER

No section measurements made by me at this time.

I, William C. Jung, Deputy County Surveyor,
 HEREBY CERTIFY THAT THE CORNER LOCATION SHOWN ON THIS RECORD
 WAS DETERMINED BY ME OR UNDER MY DIRECTION AND CONTROL AND
 THAT THIS U. S. PUBLIC LAND SURVEY MONUMENT RECORD IS CORRECT
 AND COMPLETE TO THE BEST OF MY KNOWLEDGE AND BELIEF.

William C. Jung
 Signature

May 8, 1991
 Date

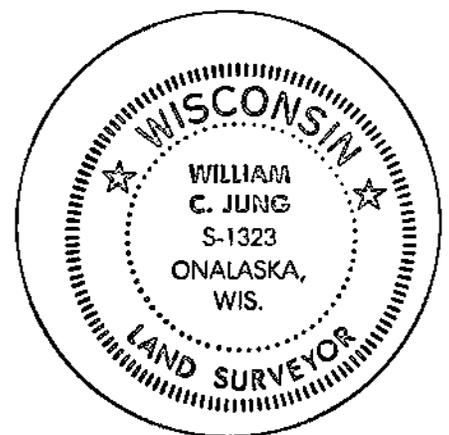

Seal