


21606250000

U. S. PUBLIC LAND SURVEY MONUMENT RECORD

SECTION 30 T 16 N, R 5 W, TOWN OF BANGOR

LA CROSSE COUNTY

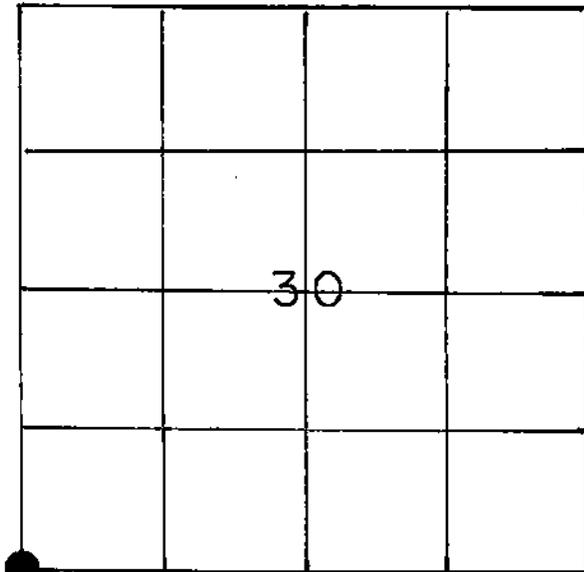

LOCATION OF LANDMARK

Crew: William Jung
Michael Weibel
8/16/84

Crew: William C. Jung
10/30/92

WISCONSIN COORDINATE SYSTEM

North

East

Theta Angle

Horiz. Order

Vert. Order

TYPE OF LANDMARK Brass capped
~~Berntsen marker~~ Lunde marker

BEARINGS ARE REFERENCED TO

Describe any record evidence, monument evidence, testimonial evidence or any other material evidence you considered and whether the monument was found or restored through acceptance of an obliterated evidence location.

Ken Carlson set a rod at this corner in May of 1978. Clayton Solberg used this rod in November of 1980. I removed this 1 $\frac{1}{4}$ " rod and replaced it with a Berntsen marker. I accepted this occupied fence corner as the best available evidence of the original government corner position.


10/30/92 I found the Berntsen with the top broken off. I replaced the Berntsen with a Lunde marker. The old Berntsen is buried with the Lunde. A post with a sign was also set nearby.

Describe or show any material discrepancy between the location of the restored corner and that of the corner previously restored or reestablished.

None known.

RECORD OF DURABLE WITNESS MONUMENTS

NO	DESCRIPTION	BEARING	DISTANCE
1	Set 1½"x2.1' iron pipe, up 1"	West ±	32.90
2	Set 1¼"x30" rebar, flush	Magnetic=S33°W	46.66
3	Set 1½"x2.7' iron pipe, up 1"	South ±	32.98
4			

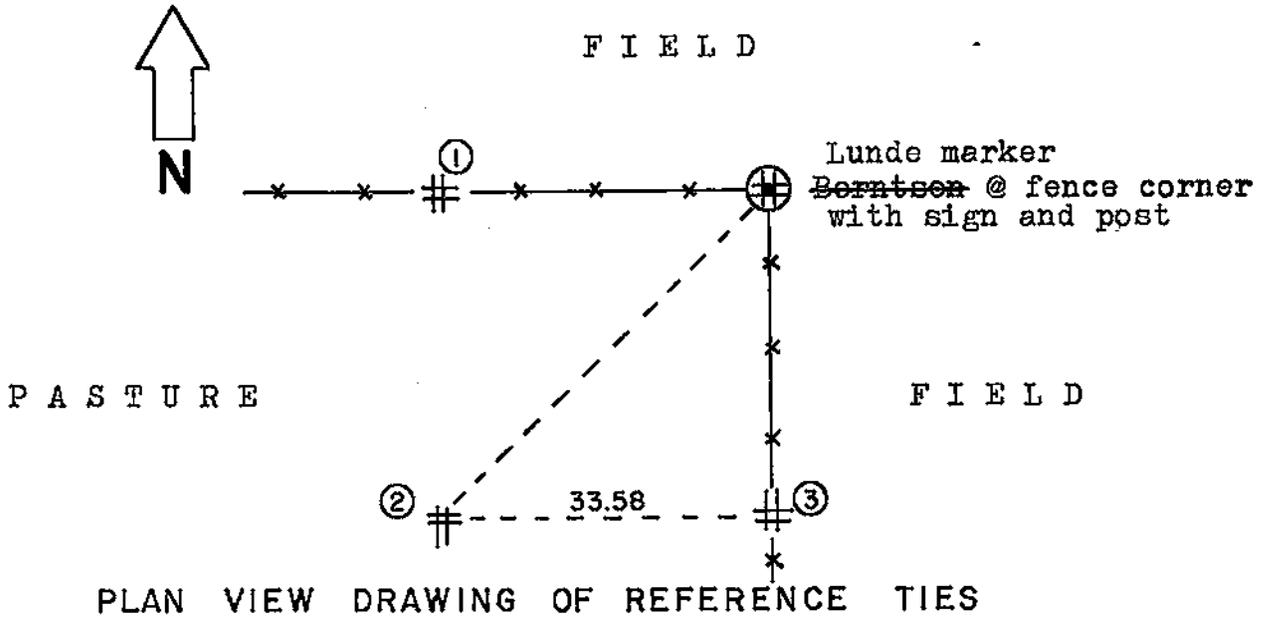

MAP SHOWING DISTANCE AND DIRECTION TO OTHER PUBLIC LAND SURVEY CORNERS USED FOR REESTABLISHING THE CORNER

See Carlson's section summary of Section 30, dated 5/15/78.

I, William C. Jung, Deputy County Surveyor,
 HEREBY CERTIFY THAT THE CORNER LOCATION SHOWN ON THIS RECORD
 WAS DETERMINED BY ME OR UNDER MY DIRECTION AND CONTROL AND
 THAT THIS U. S. PUBLIC LAND SURVEY MONUMENT RECORD IS CORRECT
 AND COMPLETE TO THE BEST OF MY KNOWLEDGE AND BELIEF.

William C. Jung
 Signature

2/11/86
 Date

Revised: 12/16/92



Seal

wey