


21705310020

U. S. PUBLIC LAND SURVEY MONUMENT RECORD

SECTION 6 T 16 N, R 5 W, TOWN OF BANGOR

LA CROSSE COUNTY

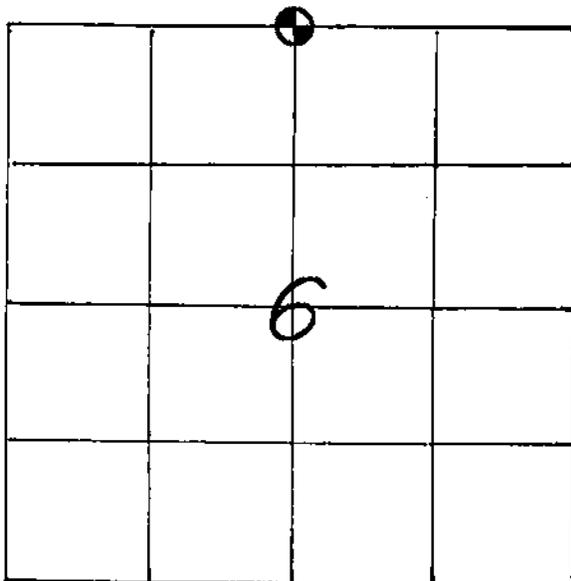

WISCONSIN COORDINATE SYSTEM

North

East

Theta Angle

Horiz. Order

Vert. Order

TYPE OF LANDMARK

BRASS CAP LUNDE MARKER.

BEARINGS ARE REFERENCED TO

TRUE NORTH (±02')

LOCATION OF LANDMARK

CREW: WILLIAM C. JUNG
 PETER F. FOLLANBEE
 DATE: 9/18/1997

Describe any record evidence, monument evidence, testimonial evidence or any other material evidence you considered and whether the monument was found or restored through acceptance of an obliterated evidence location.


I found old line fence East of the N1/16NE, projected a line from the NE corner West through this fence and intersected this line with oldest North-South fence remnants at the N1/4 corner of Section 6. A brass capped Lunde marker was set at this location. We had repeatedly searched at great length for Bliss' old 1867 stone of record, but had no luck.

Describe or show any material discrepancy between the location of the restored corner and that of the corner previously restored or reestablished.

NONE KNOWN.


RECORD OF DURABLE WITNESS MONUMENTS

NO	DESCRIPTION	BEARING	DISTANCE
1	SET A 3/4" x 30" ROUND IRON BAR DOWN 16"s	N'WESTERLY ±	32.93 FT.
2	SET A 3/4" x 30" ROUND IRON BAR DOWN 12"s	NORTHERLY ±	33.09 FT.
3	SET A 3/4" x 30" ROUND IRON BAR DOWN 4"s	EASTERLY ±	33.07 FT.
4	SET A 3/4" x 30" ROUND IRON BAR DOWN 4"s	SOUTHERLY ±	32.92 FT.

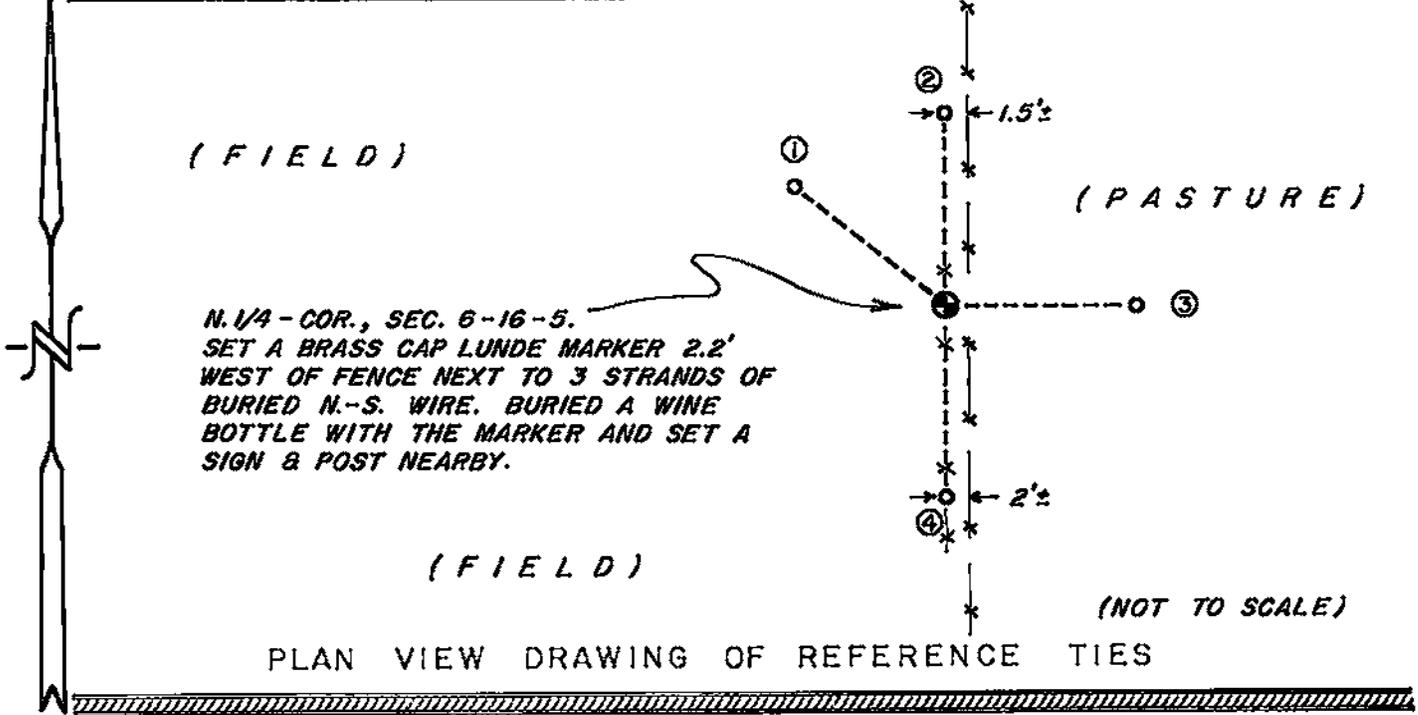

MAP SHOWING DISTANCE AND DIRECTION TO OTHER PUBLIC LAND SURVEY CORNERS USED FOR REESTABLISHING THE CORNER


(not to scale)

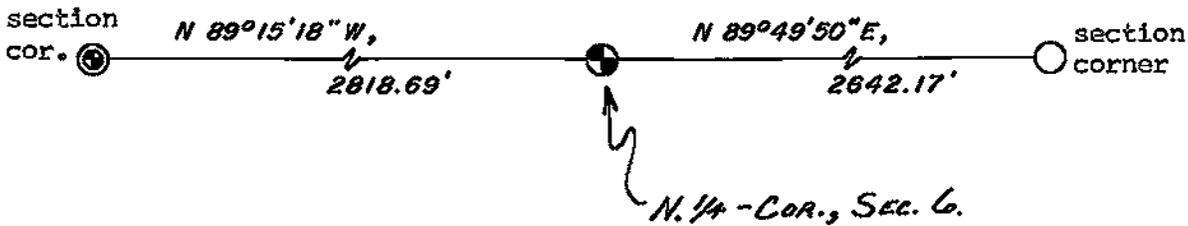

I, WILLIAM C. JUNG, COUNTY SURVEYOR
 HEREBY CERTIFY THAT THE CORNER LOCATION SHOWN ON THIS RECORD
 WAS DETERMINED BY ME OR UNDER MY DIRECTION AND CONTROL AND
 THAT THIS U. S. PUBLIC LAND SURVEY MONUMENT RECORD IS CORRECT
 AND COMPLETE TO THE BEST OF MY KNOWLEDGE AND BELIEF.

William C. Jung
 Signature

March 5, 1998
 Date

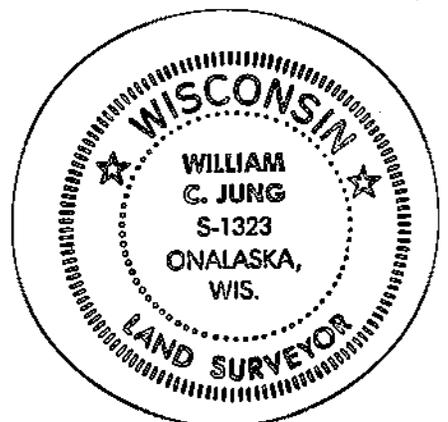

Seal