


21705330000

## U. S. PUBLIC LAND SURVEY MONUMENT RECORD

SECTION 3 T 16 N, R 5 W, TOWN OF BANGOR/BURNS

LA CROSSE COUNTY

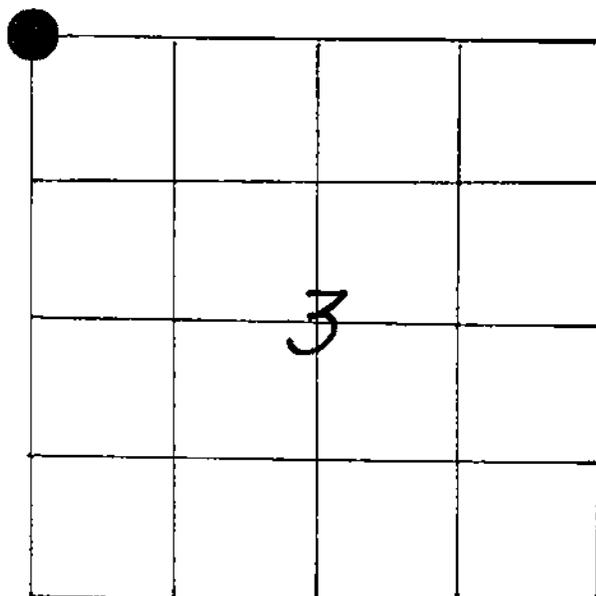

LOCATION OF LANDMARK

CREW: **WILLIAM C. JUNG**  
**PETER F. FOLLANSBEE**  
 DATE: **10/06/2003**

## WISCONSIN COORDINATE SYSTEM

North

East

Theta Angle

Horiz. Order

Vert. Order

## TYPE OF LANDMARK

EX. 1-3/8" ROUND IRON BAR.

BEARINGS ARE REFERENCED TO

TRUE NORTH AS PER SECTION DATA.

Describe any record evidence, monument evidence, testimonial evidence or any other material evidence you considered and whether the monument was found or restored through acceptance of an obliterated evidence location.

Chris Running, RLS, was at this corner in 2002. My Lunde marker was gone. In its place was an iron bar. Apparently someone took out my marker and the sign and post that I set back in 1986. I could not find the Lunde. I don't know who set the iron bar in its place. Running checks my 1/2 mile distance to the South. My ties from 1986 are gone. However, ties "2" and "3" from 1986 are now stumps. These stumps check with the iron bar. The remains of the stone are also on the West side of the bar. The bar is at the old Lunde marker location.

Describe or show any material discrepancy between the location of the restored corner and that of the corner previously restored or reestablished.

**NONE KNOWN.**

RECORD OF DURABLE WITNESS MONUMENTS

NO	DESCRIPTION	BEARING	DISTANCE
1	SET A 3/4" x 30" IRON BAR WITH RED PLASTIC CAP	N 42° E (MAG.)	48.16 FT.
2	SET A 3/4" x 30" IRON BAR WITH RED PLASTIC CAP	N 80° E (MAG.)	38.68 FT.
3	SET A 3/4" x 30" IRON BAR WITH RED PLASTIC CAP	S. 'EASTERLY ±	47.61 FT.
4	SET A 3/4" x 30" IRON BAR WITH RED PLASTIC CAP	S. 'EASTERLY ±	68.67 FT.

(NOTE: THE TIE POINTS ARE SET FLUSH INSIDE THE EDGE OF THE WOODS APPROXIMATELY 30 FEET APART. POINT No. 2 IS 1'± WEST OF AN EXISTING STEEL FENCE POST.)

(FIELD)

N.W. - COR., SEC. 3-16-5.  
FOUND A 1-3/8" ROUND IRON BAR BURIED 8" IN A FIELD. STONE REMNANTS ARE ON THE WEST SIDE OF THE IRON BAR.


(NOT TO SCALE)

PLAN VIEW DRAWING OF REFERENCE TIES

SCRUB TREES AND BRUSH REMAIN. (LOGGED OUT WOODS)

MAP SHOWING DISTANCE AND DIRECTION TO OTHER PUBLIC LAND SURVEY CORNERS USED FOR REESTABLISHING THE CORNER

(1986 MEASUREMENTS)  
(TRUE BEARINGS)

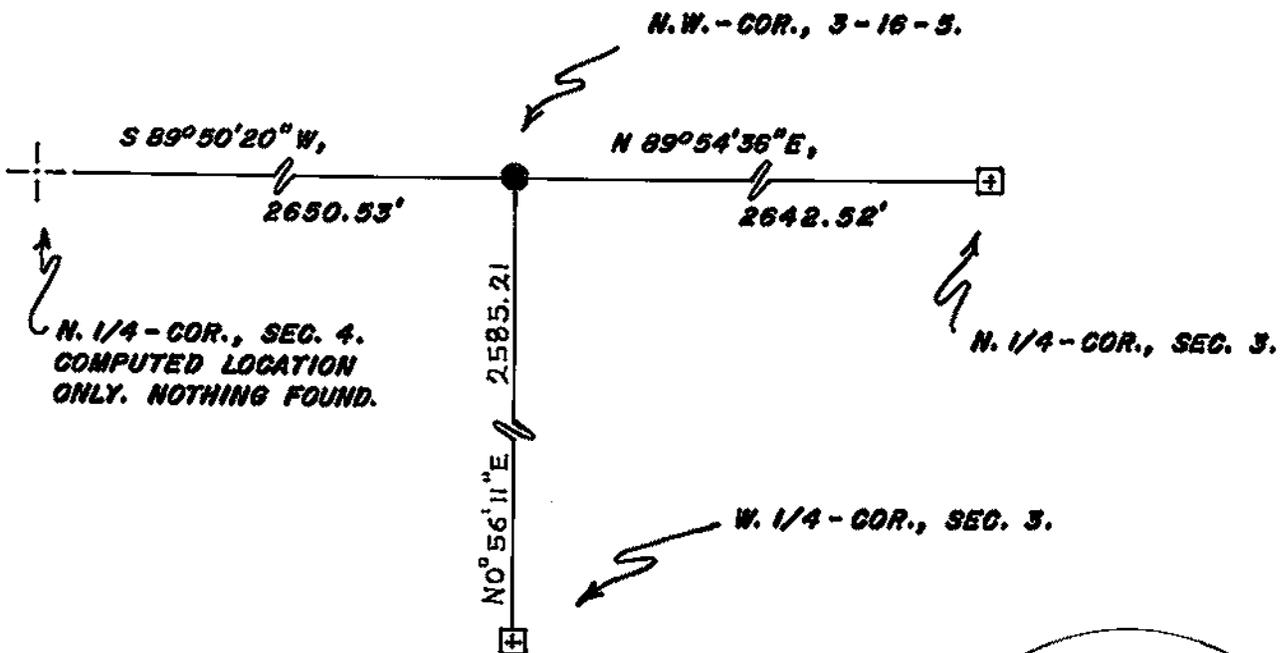

I, WILLIAM G. JUNG, COUNTY SURVEYOR  
HEREBY CERTIFY THAT THE CORNER LOCATION SHOWN ON THIS RECORD WAS DETERMINED BY ME OR UNDER MY DIRECTION AND CONTROL AND THAT THIS U. S. PUBLIC LAND SURVEY MONUMENT RECORD IS CORRECT AND COMPLETE TO THE BEST OF MY KNOWLEDGE AND BELIEF.

William G. Jung                      2/5/04  
Signature                                      Date




Seal

## U. S. PUBLIC LAND SURVEY MONUMENT RECORD

SECTION 4 T 16 N, R 5 W, TOWN OF BANGOR

LA CROSSE COUNTY

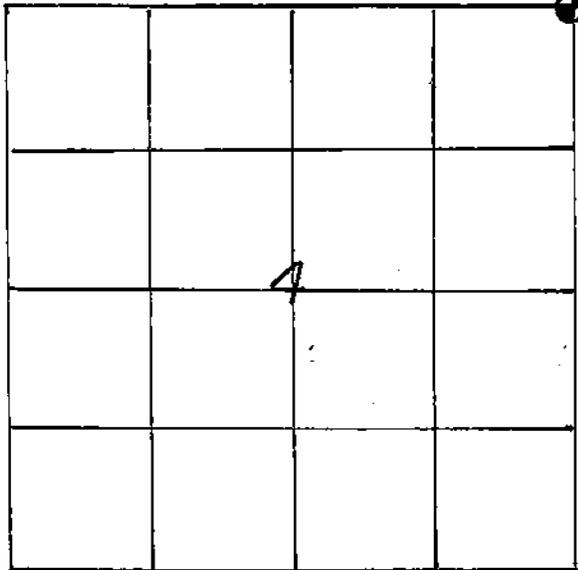

LOCATION OF LANDMARK

DATE: 11-17-86

CREW: BILL JUNG, PERRY DAHL

WISCONSIN COORDINATE SYSTEM

North

East

Theta Angle

Horiz. Order

Vert. Order

TYPE OF LANDMARK

BRASS CAPPED LUNDE MARKER

BEARINGS ARE REFERENCED TO

True

Describe any record evidence, monument evidence, testimonial evidence or any other material evidence you considered and whether the monument was found or restored through acceptance of an obliterated evidence location.


I found a stone at the corner and accepted it as the best available evidence of the original government corner. The stone is in a plowed field with the top of the stone broken off. I removed the stone and replaced it with a brass capped Lunde marker. The remains of the stone are buried on the West side of the marker.

Describe or show any material discrepancy between the location of the restored corner and that of the corner previously restored or reestablished.

None known.

**RECORD OF DURABLE WITNESS MONUMENTS**  
MAGNETIC

NO	DESCRIPTION	BEARING	DISTANCE
1	P.K. NAIL IN DOUBLE-BLAZED 8" NORWAY	N34°E	110.3'
2	P.K. NAIL IN DOUBLE-BLAZED 7" OAK	N53°E	84'
3	P.K. NAIL IN DOUBLE-BLAZED 9" SPRUCE	S89°E	86.04'
4	P.K. NAIL IN DOUBLE-BLAZED 9" OAK	S35°E	107.6'

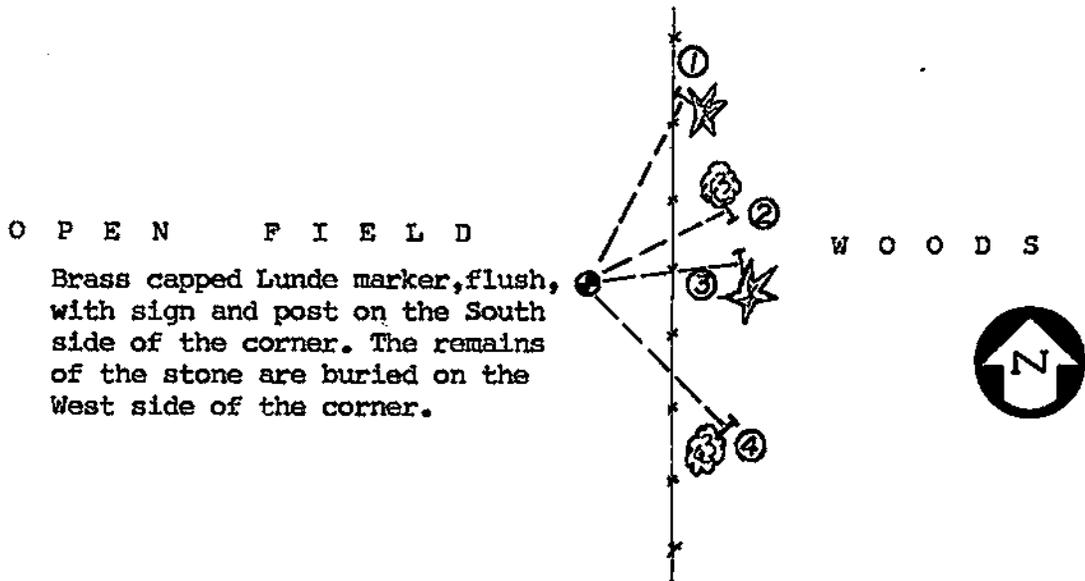


PLAN VIEW DRAWING OF REFERENCE TIES



**MAP SHOWING DISTANCE AND DIRECTION TO OTHER PUBLIC LAND SURVEY CORNERS USED FOR REESTABLISHING THE CORNER**

(not to scale)

Computed location only,  
no monument found

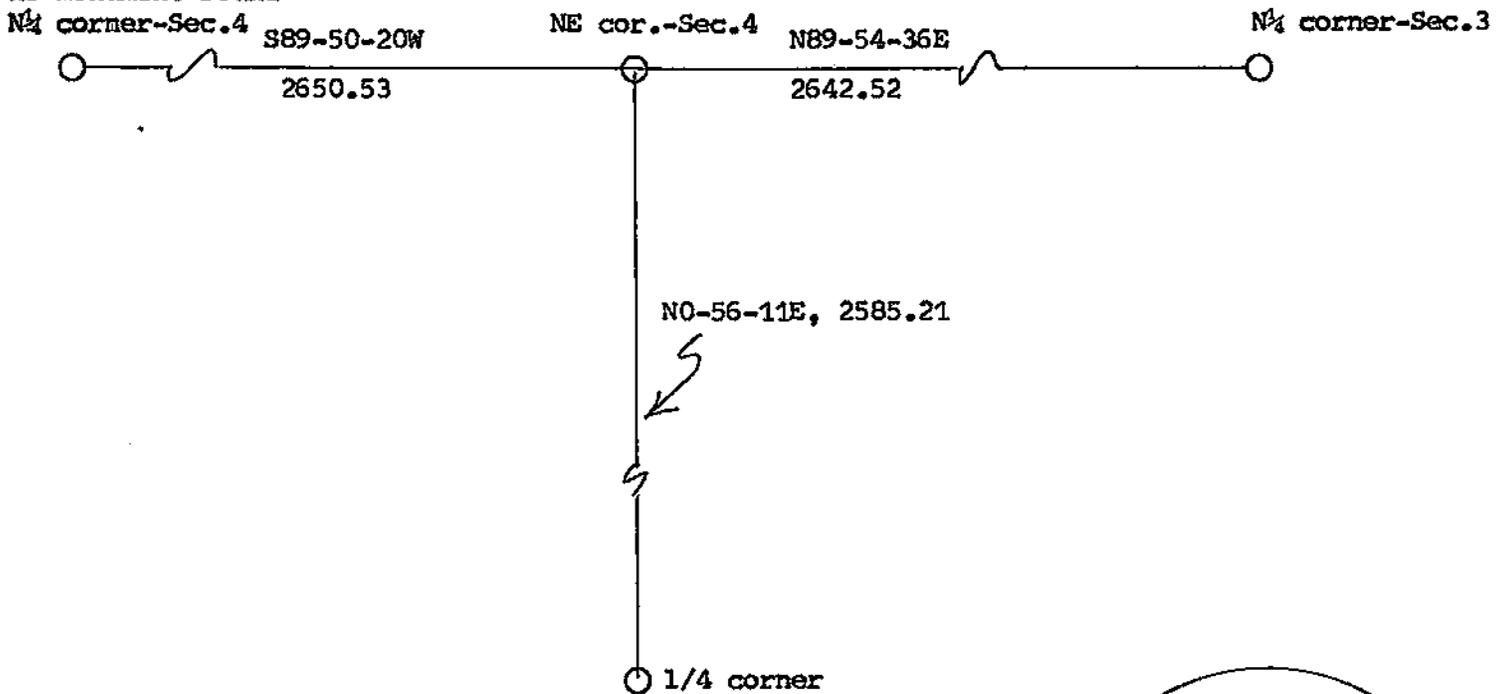

I, William C. Jung, Deputy County Surveyor,  
HEREBY CERTIFY THAT THE CORNER LOCATION SHOWN ON THIS RECORD  
WAS DETERMINED BY ME OR UNDER MY DIRECTION AND CONTROL AND  
THAT THIS U. S. PUBLIC LAND SURVEY MONUMENT RECORD IS CORRECT  
AND COMPLETE TO THE BEST OF MY KNOWLEDGE AND BELIEF.

William C. Jung  
Signature

March 10, 1987  
Date

