


21705340000

U. S. PUBLIC LAND SURVEY MONUMENT RECORD

SECTION 3 T 16 N, R 5 W, TOWN OF Bangor
 LA CROSSE COUNTY

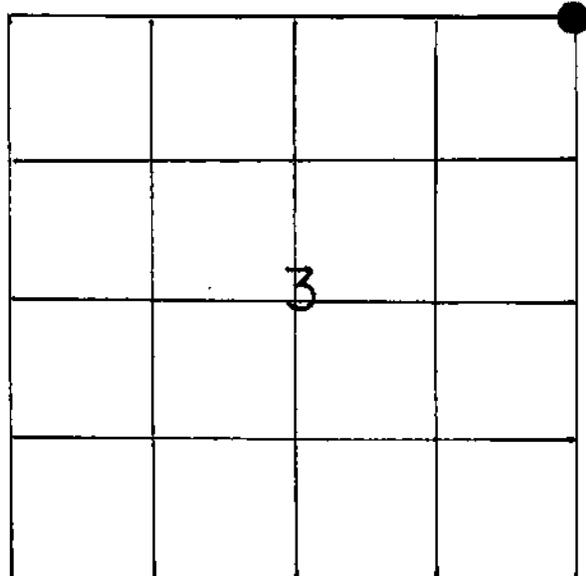

LOCATION OF LANDMARK

Crew: William C. Jung
 Perry L. Dahl
 10-8-86

WISCONSIN COORDINATE SYSTEM

North

East

Theta Angle

Horiz. Order

Vert. Order

TYPE OF LANDMARK

Set P.K. nail in road centerline

BEARINGS ARE REFERENCED TO

True

Describe any record evidence, monument evidence, testimonial evidence or any other material evidence you considered and whether the monument was found or restored through acceptance of an obliterated evidence location.


I set the corner at a location as shown on previous surveys and accepted this location as the best available evidence of the original government corner position. I set a P.K. nail in the centerline of the road.

Describe or show any material discrepancy between the location of the restored corner and that of the corner previously restored or reestablished.

None known.


RECORD OF DURABLE WITNESS MONUMENTS

NO	DESCRIPTION	BEARING	DISTANCE
1	Existing iron pipe, buried, 19" South of fence	S89-47-18W (True)	212.17
2	Existing 1 1/2" iron pipe, buried	S89-47-18W (True)	33.00
3	Set 1" iron pipe, flush	N89-47-18E (True)	33.00
4	P.K. nail in unblazed 23" burr oak	S62E (Magnetic)	69.34

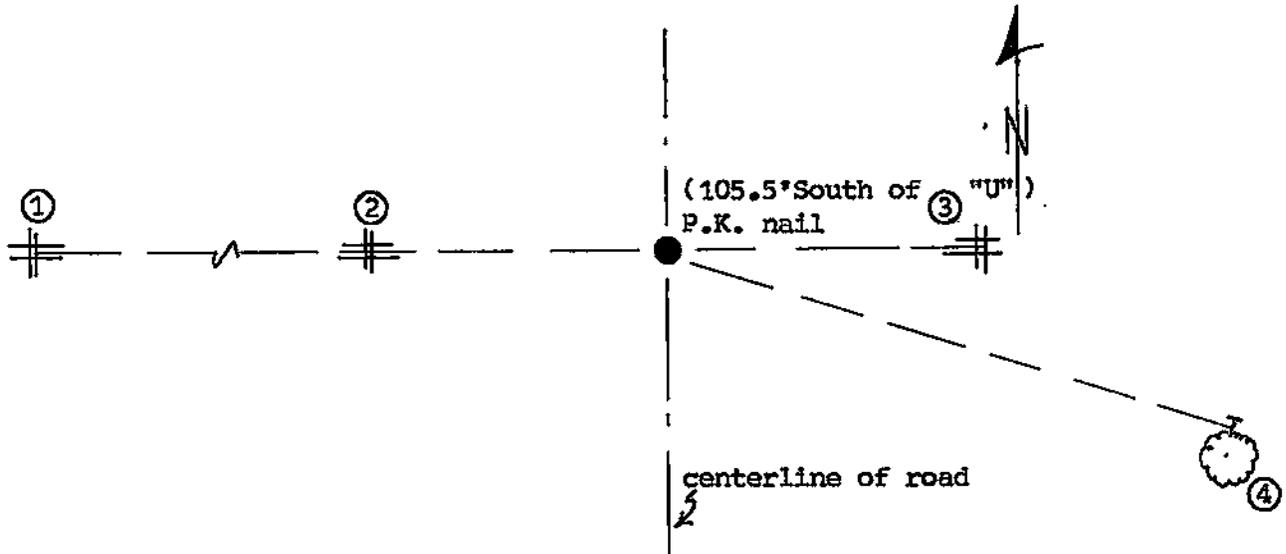

PLAN VIEW DRAWING OF REFERENCE TIES


MAP SHOWING DISTANCE AND DIRECTION TO OTHER PUBLIC LAND SURVEY CORNERS USED FOR REESTABLISHING THE CORNER
(not to scale)

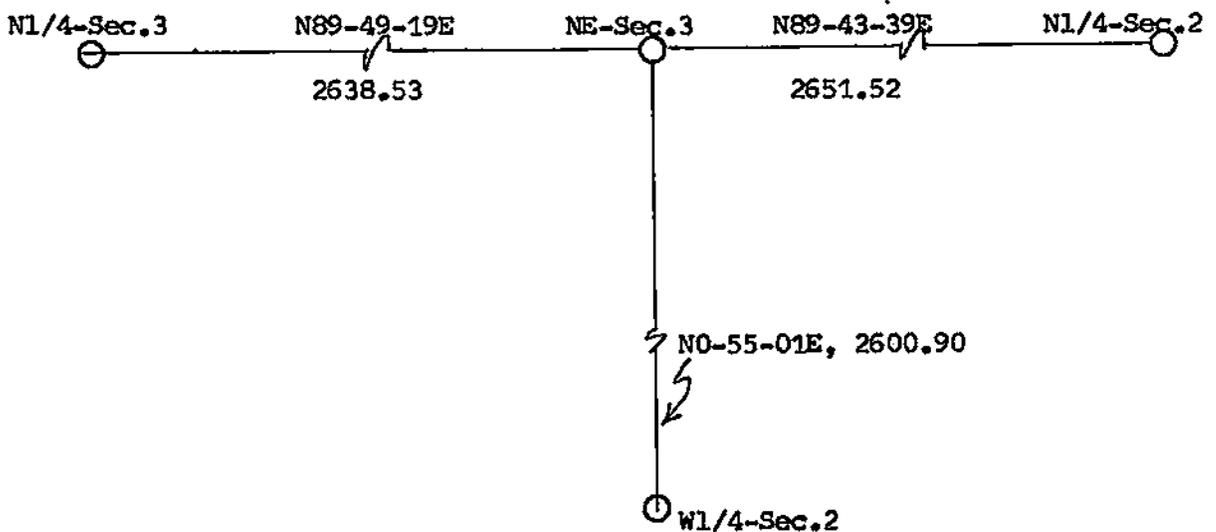

I, William C. Jung, Deputy County Surveyor,
HEREBY CERTIFY THAT THE CORNER LOCATION SHOWN ON THIS RECORD
WAS DETERMINED BY ME OR UNDER MY DIRECTION AND CONTROL AND
THAT THIS U. S. PUBLIC LAND SURVEY MONUMENT RECORD IS CORRECT
AND COMPLETE TO THE BEST OF MY KNOWLEDGE AND BELIEF.

William C. Jung
Signature

March 18, 1987
Date

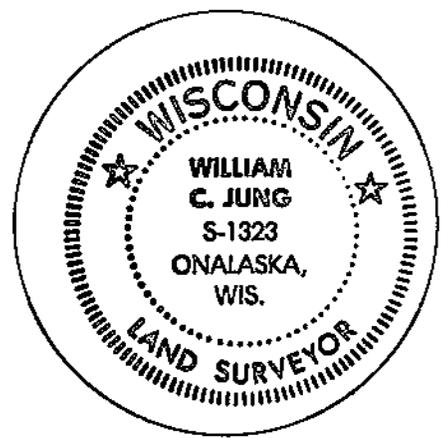

Seal