


21705350020

U. S. PUBLIC LAND SURVEY MONUMENT RECORD

SECTION 2 T 16 N, R 5 W, TOWN OF BANGOR

LA CROSSE COUNTY

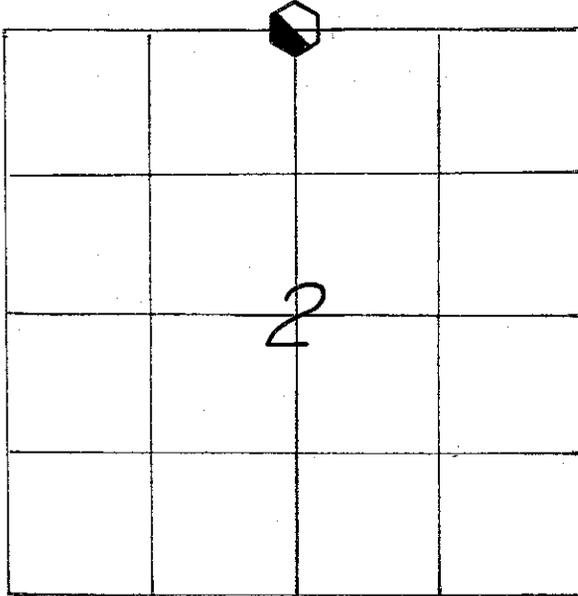

LOCATION OF LANDMARK

DATE: 11-24-86

CREW: BILL JUNG, PERRY DAHL

WISCONSIN COORDINATE SYSTEM

North 693,640.483

East 1,720,696.405

Theta Angle

Horiz. Order

Vert. Order

Datum: NAD 1983('91)

TYPE OF LANDMARK

BERNTSEN TOP IN IRON PIPE

BEARINGS ARE REFERENCED TO

Grid North as per Section
Data.

Revised: 11/09/2009.

Describe any record evidence, monument evidence, testimonial evidence or any other material evidence you considered and whether the monument was found or restored through acceptance of an obliterated evidence location.

I set the corner on line with the old line fence to the South and 295' North of the centerline of the most Northerly railroad track. This location fits the old railroad map and section data very well. I dug and probed for a buried stone but could not find one. I set a Berntsen top in an iron pipe at the corner.

Describe or show any material discrepancy between the location of the restored corner and that of the corner previously restored or reestablished.

None known.


RECORD OF DURABLE WITNESS MONUMENTS

NO	DESCRIPTION	BEARING	DISTANCE
1	1 1/4" IRON PIPE (set)	SOUTH \pm	242.37
2	1 1/4" IRON PIPE "	SOUTH \pm	346.10
3	TIMBER SPIKE " 117.65' South of centerline of N. track	SOUTH \pm	412.65
4	1 1/4" IRON PIPE "	SOUTH \pm	456.88

N. 1/4-Cor., 2-16-5. Buried a Berntsen top in an iron pipe, down 18" at the corner, out in a field.

(Revised: 11/09/2009.)


(Note: set a sign & post facing north 1' \pm south of the tie pipe at #2).

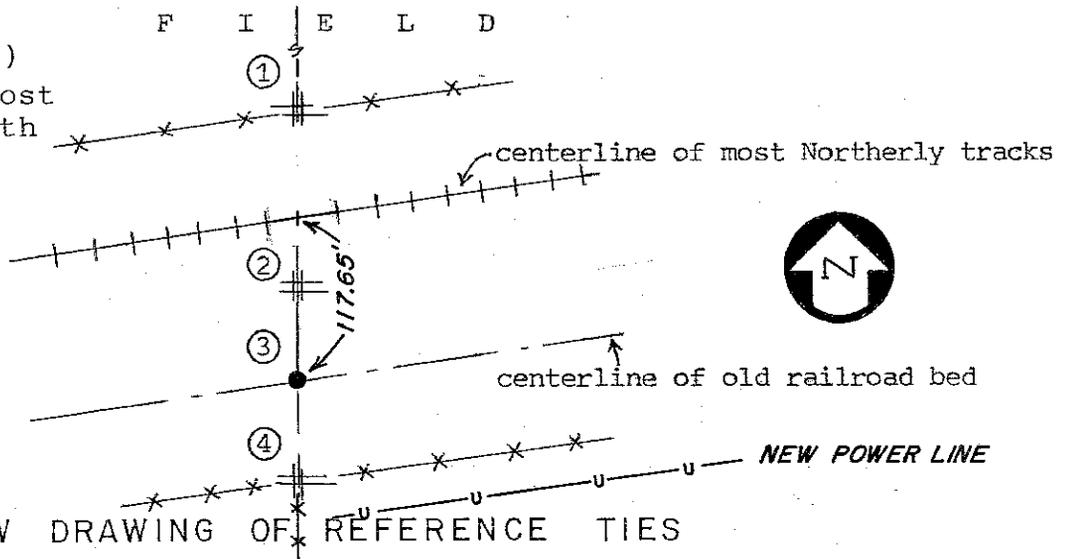

PLAN VIEW DRAWING OF REFERENCE TIES

MAP SHOWING DISTANCE AND DIRECTION TO OTHER PUBLIC LAND SURVEY CORNERS USED FOR REESTABLISHING THE CORNER


(Grid bearings and distances)
 (Grid Factor: 0.999937)
 (Not to scale)
 (Revised: 11/09/2009)

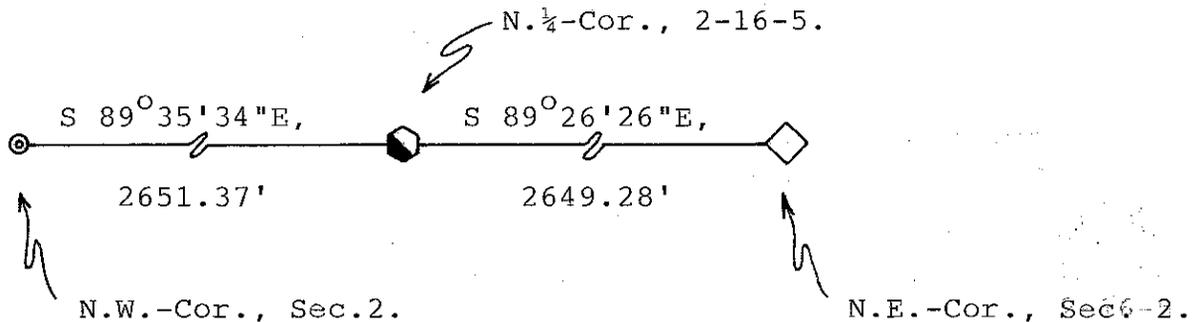

I, ~~William C. Jung, Deputy County Surveyor~~
 HEREBY CERTIFY THAT THE CORNER LOCATION SHOWN ON THIS RECORD WAS DETERMINED BY ME OR UNDER MY DIRECTION AND CONTROL AND THAT THIS U. S. PUBLIC LAND SURVEY MONUMENT RECORD IS CORRECT AND COMPLETE TO THE BEST OF MY KNOWLEDGE AND BELIEF.

Signature

March 17, 1987
 Date

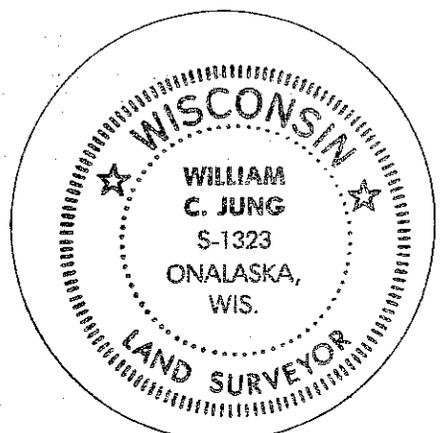


Seal

21705350020

U. S. PUBLIC LAND SURVEY MONUMENT RECORD

SECTION 2 T 16 N, R 5 W, TOWN OF BANGOR

LA CROSSE COUNTY

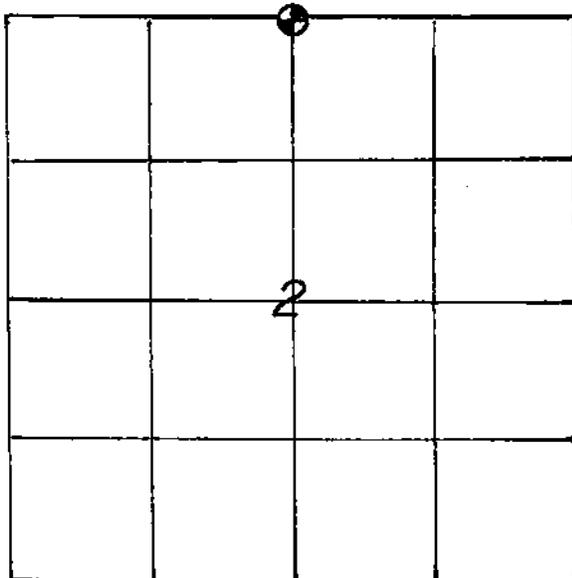

LOCATION OF LANDMARK

DATE: 11-24-86

CREW: BILL JUNG, PERRY DAHL

WISCONSIN COORDINATE SYSTEM

North

East

Theta Angle

Horiz. Order

Vert. Order

TYPE OF LANDMARK

BERNTSEN TOP IN IRON PIPE

BEARINGS ARE REFERENCED TO

True

Describe any record evidence, monument evidence, testimonial evidence or any other material evidence you considered and whether the monument was found or restored through acceptance of an obliterated evidence location.

I set the corner on line with the old line fence to the South and 295' North of the centerline of the most Northerly railroad track. This location fits the old railroad map and section data very well. I dug and probed for a buried stone but could not find one. I set a Berntsen top in an iron pipe at the corner.

Describe or show any material discrepancy between the location of the restored corner and that of the corner previously restored or reestablished.

None known.

