


21706360000

U. S. PUBLIC LAND SURVEY MONUMENT RECORD

SECTION 6 T 16 N, R 5 W, TOWN OF BANGOR

LA CROSSE COUNTY

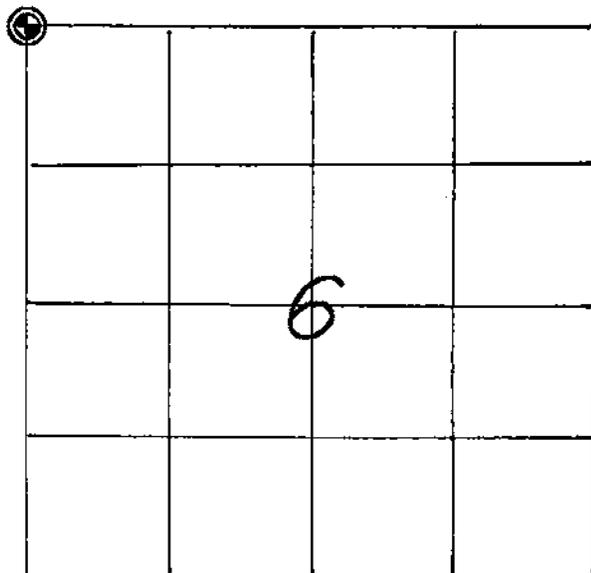

LOCATION OF LANDMARK

CREW: WILLIAM C. JUNG
 PETER F. FOLLANSBEE
 DATE: 9/08/1997

WISCONSIN COORDINATE SYSTEM

North

East

Theta Angle

Horiz. Order

Vert. Order

TYPE OF LANDMARK

BERNTSEN TOP IN AN IRON PIPE,

BEARINGS ARE REFERENCED TO

TRUE NORTH. ($\pm 02'$)

Describe any record evidence, monument evidence, testimonial evidence or any other material evidence you considered and whether the monument was found or restored through acceptance of an obliterated evidence location.

I found an iron pipe at the old occupied corner. We dug and searched at great length for the old stone of record, but had no luck. I accepted this location as the best available evidence of the original government corner position.


I set a Berntsen top in the existing iron pipe.

Describe or show any material discrepancy between the location of the restored corner and that of the corner previously restored or reestablished.

NONE KNOWN.


RECORD OF DURABLE WITNESS MONUMENTS

NO	DESCRIPTION	BEARING	DISTANCE
1	SET A 1/2" X 4' ROD 6" WEST OF FENCE	NORTH ±	33.01 FT.
2	SET A NAIL IN THE N.W.-SIDE OF A LARGE OAK (UNBLAZED)	SOUTH ±	60.87 FT.
3	SET A NAIL IN THE N.W.-SIDE 13-1/2" OAK (DOUBLE BLAZED)	S 18° W (MAG.)	sl=97.70 FT.
4	SET A NAIL IN THE N.W.-SIDE 12" DOUBLE OAK (DOUBLE BLAZED)	S 25° W (MAG.)	sl=101.50 FT.

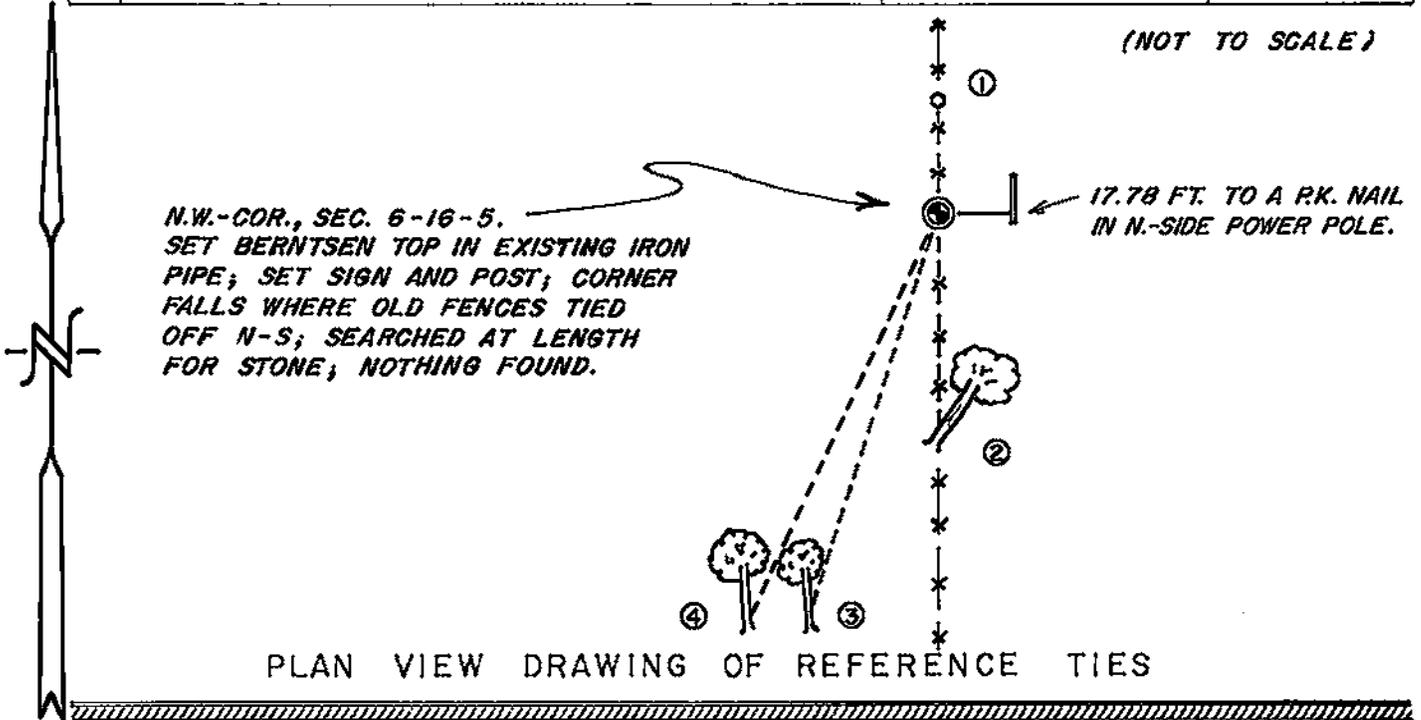


MAP SHOWING DISTANCE AND DIRECTION TO OTHER PUBLIC LAND SURVEY CORNERS USED FOR REESTABLISHING THE CORNER

(not to scale)

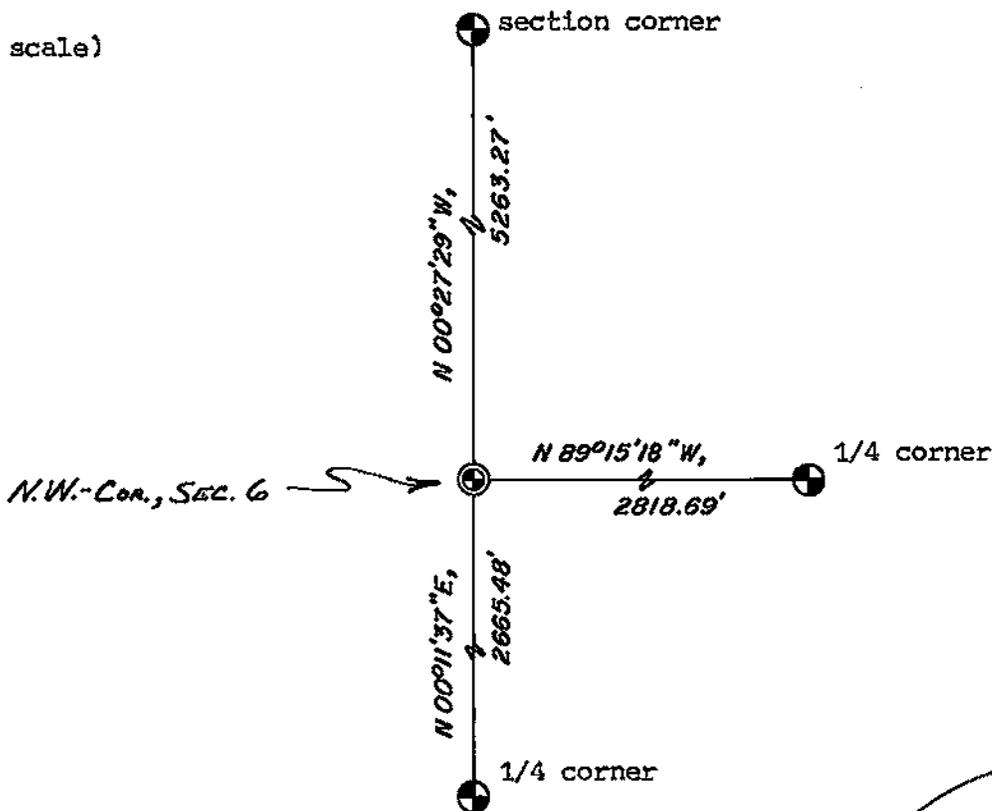

I, WILLIAM C. JUNG, COUNTY SURVEYOR
HEREBY CERTIFY THAT THE CORNER LOCATION SHOWN ON THIS RECORD WAS DETERMINED BY ME OR UNDER MY DIRECTION AND CONTROL AND THAT THIS U. S. PUBLIC LAND SURVEY MONUMENT RECORD IS CORRECT AND COMPLETE TO THE BEST OF MY KNOWLEDGE AND BELIEF.

William C. Jung March 5, 1998
Signature Date

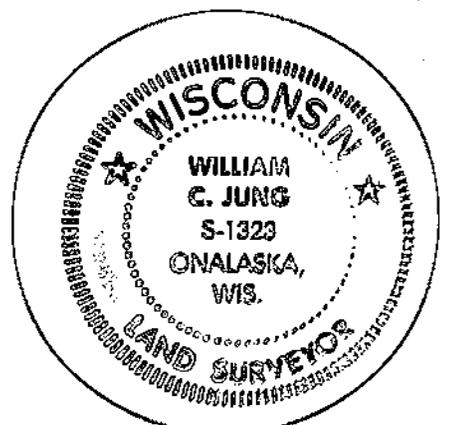

Seal