


U. S. PUBLIC LAND SURVEY MONUMENT RECORD

SECTION 1 T 16 N, R 6 W, TOWN OF HAMILTON
LA CROSSE COUNTY

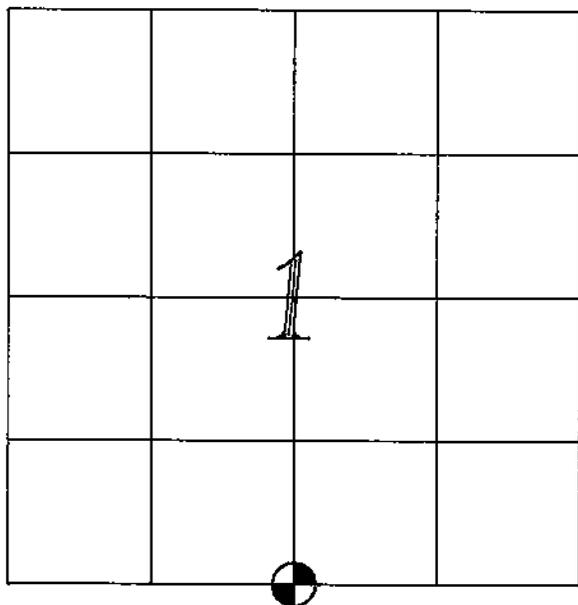

LOCATION OF LANDMARK

WISCONSIN COORDINATE SYSTEM
North
East
Theta Angle
Horiz. Order
Vert. Order
TYPE OF LANDMARK
1 1/4" IRON BAR
BEARINGS ARE REFERENCED TO
La Crosse County Coordinates

CREW: CF

KK TS


DATE: 10/13/2006

Describe any record evidence, monument evidence, testimonial evidence, or any other material evidence you considered and whether the monument was found or restored through acceptance of an obliterated evidence location.

K. DON PEDERSON AND STEVE SOLBERG INDICATE IN PREVIOUS SURVEYS THAT THE IRON PIPE 1874.54 FEET SOUTH OF THE N 1/4 CORNER WAS ON THE N/S 1/4 LINE. THIS INFORMATION WAS USED TO DETERMINE THE POSITION OF THE S 1/4 CORNER OF SECTION ONE FOR PREVIOUS WORK PERFORMED IN SECTIONS 1 AND 12.


Describe or show any material discrepancy between the location of the restored corner and that of the corner previously restored or reestablished.

NONE KNOWN

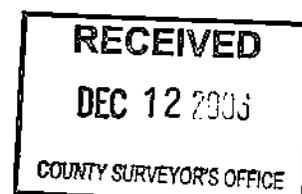


RECORD OF DURABLE WITNESS MONUMENTS

NO	DESCRIPTION	BEARING	DISTANCE
1	SET 3/4" IRON BAR 2' SOUTH OF UP #9404AQ11	N 74°27'55" W	219.38'
2	SET 3/4" IRON BAR EAST SIDE OF GATE	N 52°03'14" W	159.29'
3	SET 3/4" IRON BAR	N 37°57'16" W	41.86'
4	SET 3/4" IRON BAR IN FENCE LINE	N 59°17'11" E	24.05'

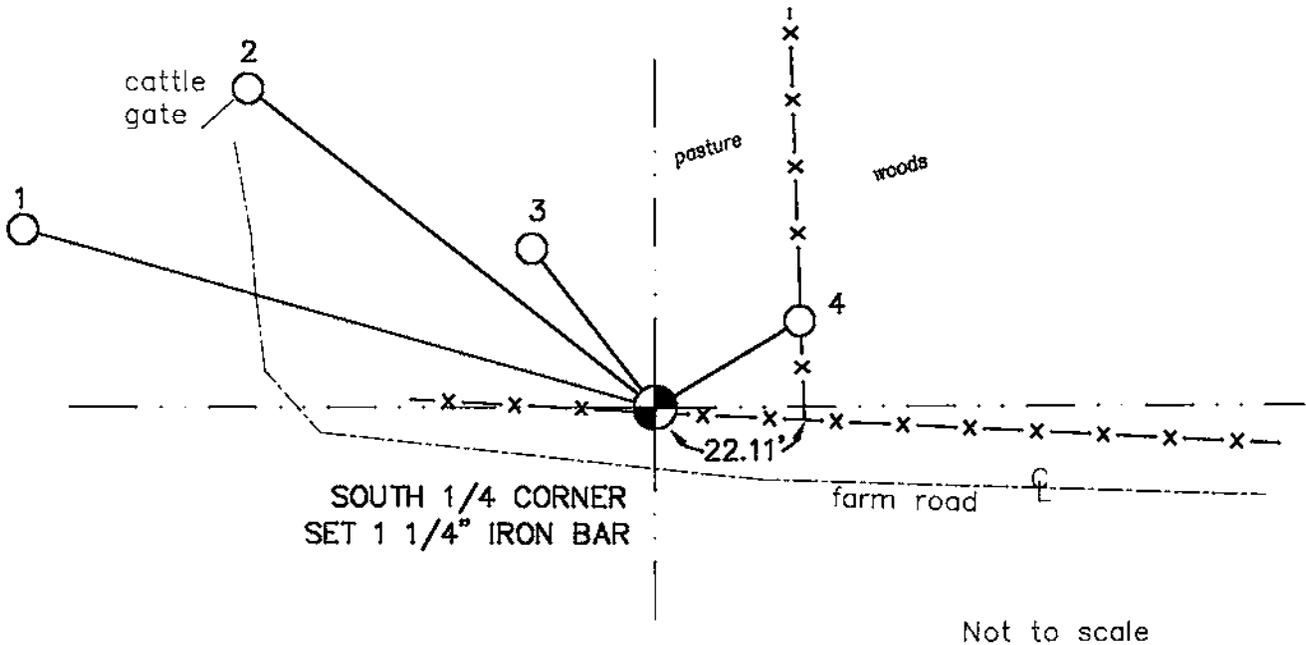

PLAN VIEW DRAWING OF REFERENCE TIES

MAP SHOWING DISTANCE AND DIRECTION TO OTHER PUBLIC LAND SURVEY CORNERS USED FOR REESTABLISHING THE CORNER

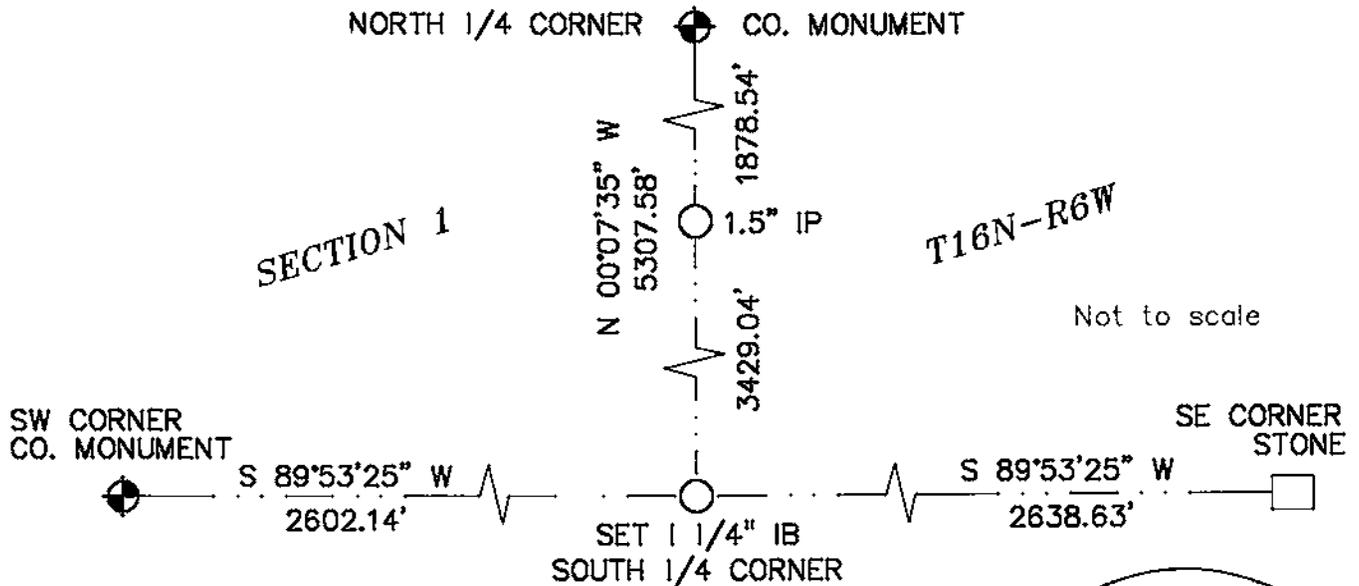

I, Christopher Wm. Fechner


HEREBY CERTIFY THAT THE CORNER LOCATION SHOWN ON THIS RECORD WAS DETERMINED BY ME OR UNDER MY DIRECTION AND CONTROL AND THAT THIS U. S. PUBLIC LAND SURVEY MONUMENT RECORD IS CORRECT AND COMPLETE TO THE BEST OF MY KNOWLEDGE AND BELIEF.

Christopher Wm. Fechner

10/24/06

Signature

Date

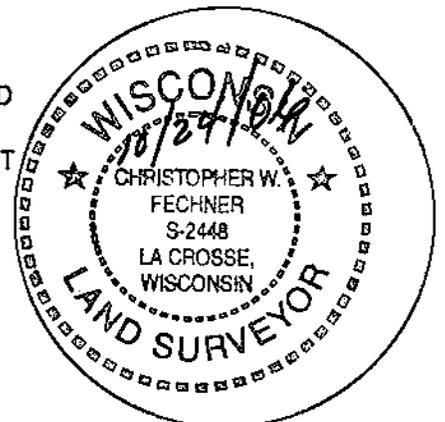

Seal