


21606020000

## U. S. PUBLIC LAND SURVEY MONUMENT RECORD

SECTION 2 T 16 N, R 6 W, TOWN OF HAMILTON

LA CROSSE COUNTY

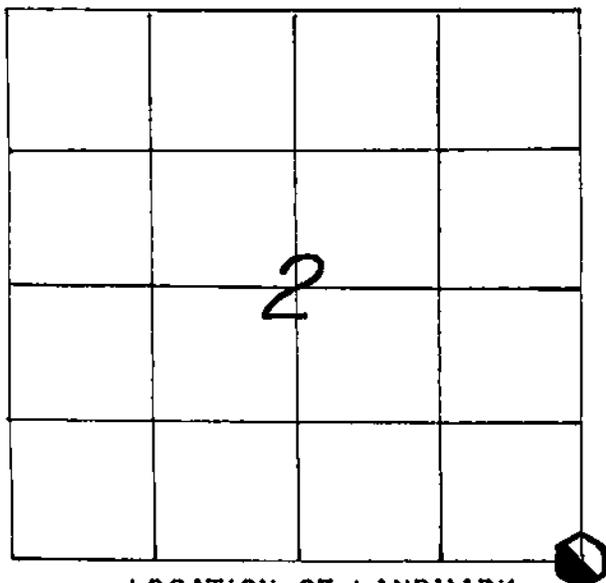

LOCATION OF LANDMARK

CREW: WILLIAM C. JUNG  
 PETER F. FOLLANSBEE  
 DATE: 5/03/2006

WISCONSIN COORDINATE SYSTEM	
North	688,627.652
East	1,691,423.706
Theta Angle	
Horiz. Order	
Vert. Order	
DATUM:	1983('91)
TYPE OF LANDMARK	
BERNTSEN TOP IN IRON PIPE.	
BEARINGS ARE REFERENCED TO	
GRID NORTH AS PER SECTION DATA.	

Describe any record evidence, monument evidence, testimonial evidence or any other material evidence you considered and whether the monument was found or restored through acceptance of an obliterated evidence location.


At the corner I set a Berntsen "shorty" in an iron pipe. I set it at Chris Fechner's computed location. This also appears to fit Bob Chalsma's section corner location. I removed the iron pipe that I found 4.44 feet to the Southeast.

Describe or show any material discrepancy between the location of the restored corner and that of the corner previously restored or reestablished.

**NONE KNOWN.**


RECORD OF DURABLE WITNESS MONUMENTS

NO	DESCRIPTION	MAGNETIC	
		BEARING	DISTANCE
1	SET A NAIL IN W.-SIDE OF A 13" DOUBLE BLAZED OAK	N 23° E	12.70 FT.
2	SET A 3/4" x 30" IRON BAR 4' SOUTH OF A PASTURE FENCE	N 54° E	33.17 FT.
3	SET A 3/4" x 30" IRON BAR WITH A RED PLASTIC CAP	S 56° W	14.88 FT.
4	SET A 3/4" x 30" IRON BAR WITH A RED PLASTIC CAP	N 85° W	12.83 FT.

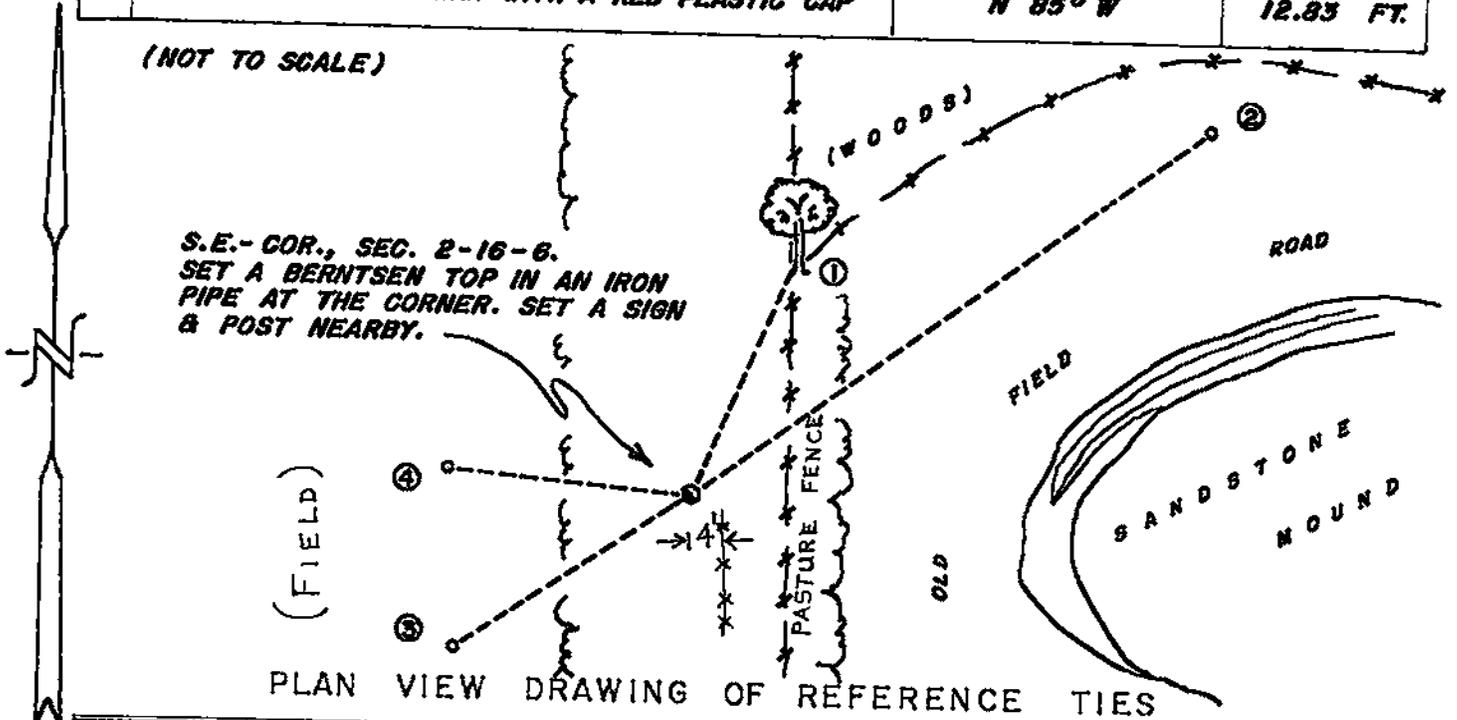

MAP SHOWING DISTANCE AND DIRECTION TO OTHER PUBLIC LAND SURVEY CORNERS USED FOR REESTABLISHING THE CORNER


(GRID BEARINGS AND DISTANCES)  
(GRID FACTOR: 0.999938)  
(NOT TO SCALE)

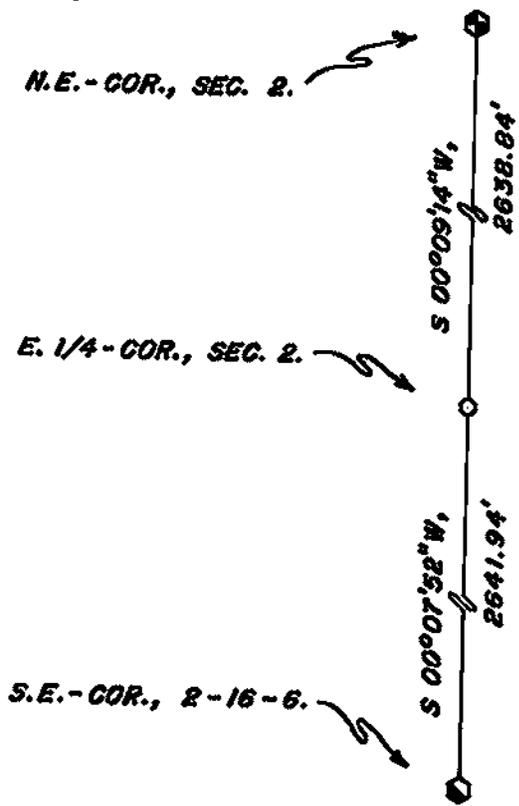

I, WILLIAM C. JUNG, COUNTY SURVEYOR  
HEREBY CERTIFY THAT THE CORNER LOCATION SHOWN ON THIS RECORD WAS DETERMINED BY ME OR UNDER MY DIRECTION AND CONTROL AND THAT THIS U. S. PUBLIC LAND SURVEY MONUMENT RECORD IS CORRECT AND COMPLETE TO THE BEST OF MY KNOWLEDGE AND BELIEF.

William C. Jung  
Signature

7/6/06  
Date

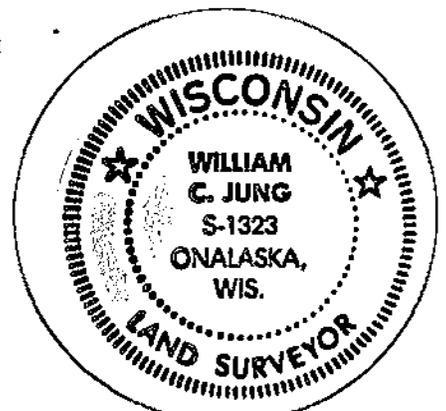

Seal