


U. S. PUBLIC LAND SURVEY MONUMENT RECORD

SECTION 2 T 16 N, R 6 W, TOWN OF Hamilton

LA CROSSE COUNTY

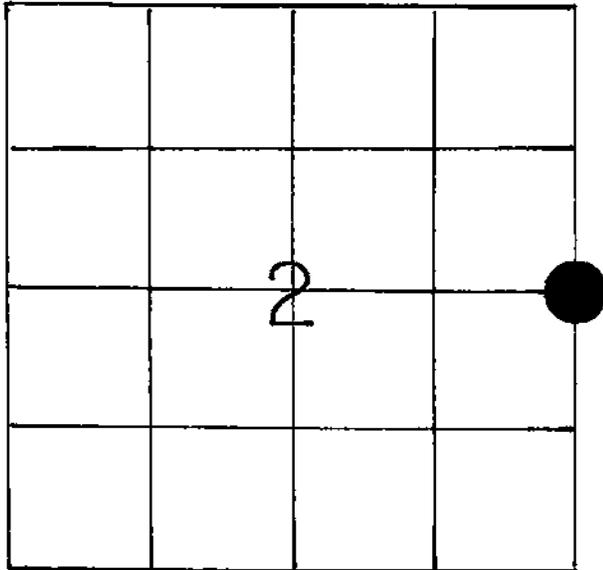

LOCATION OF LANDMARK

WISCONSIN COORDINATE SYSTEM

North

East

Theta Angle

Horiz. Order

Vert. Order

TYPE OF LANDMARK

Existing $\frac{1}{4}$ " Iron Pipe

BEARINGS ARE REFERENCED TO

True

Crew: WILLIAM C. JUNG
PETER F. FOLLANSBEE

Date: 4/05/1989

Describe any record evidence, monument evidence, testimonial evidence or any other material evidence you considered and whether the monument was found or restored through acceptance of an obliterated evidence location.


I found an iron pipe at the corner that had been used in previous surveys and accepted it as the best available evidence of the original government corner position.

Describe or show any material discrepancy between the location of the restored corner and that of the corner previously restored or reestablished.

NONE KNOWN

RECORD OF DURABLE WITNESS MONUMENTS


NO	DESCRIPTION	BEARING	DISTANCE
1	Set P.K. Nail in Power Pole	Southwesterly	44.86 Ft.
2	Southeast corner of Shed	Northwesterly	165.0 Ft.
3	Set P.K. Nail in Power Pole	Northwesterly	44.53 Ft.
4	Set 1" Iron Pipe 3' N. of R/W Fence	South ±	47.40 Ft.

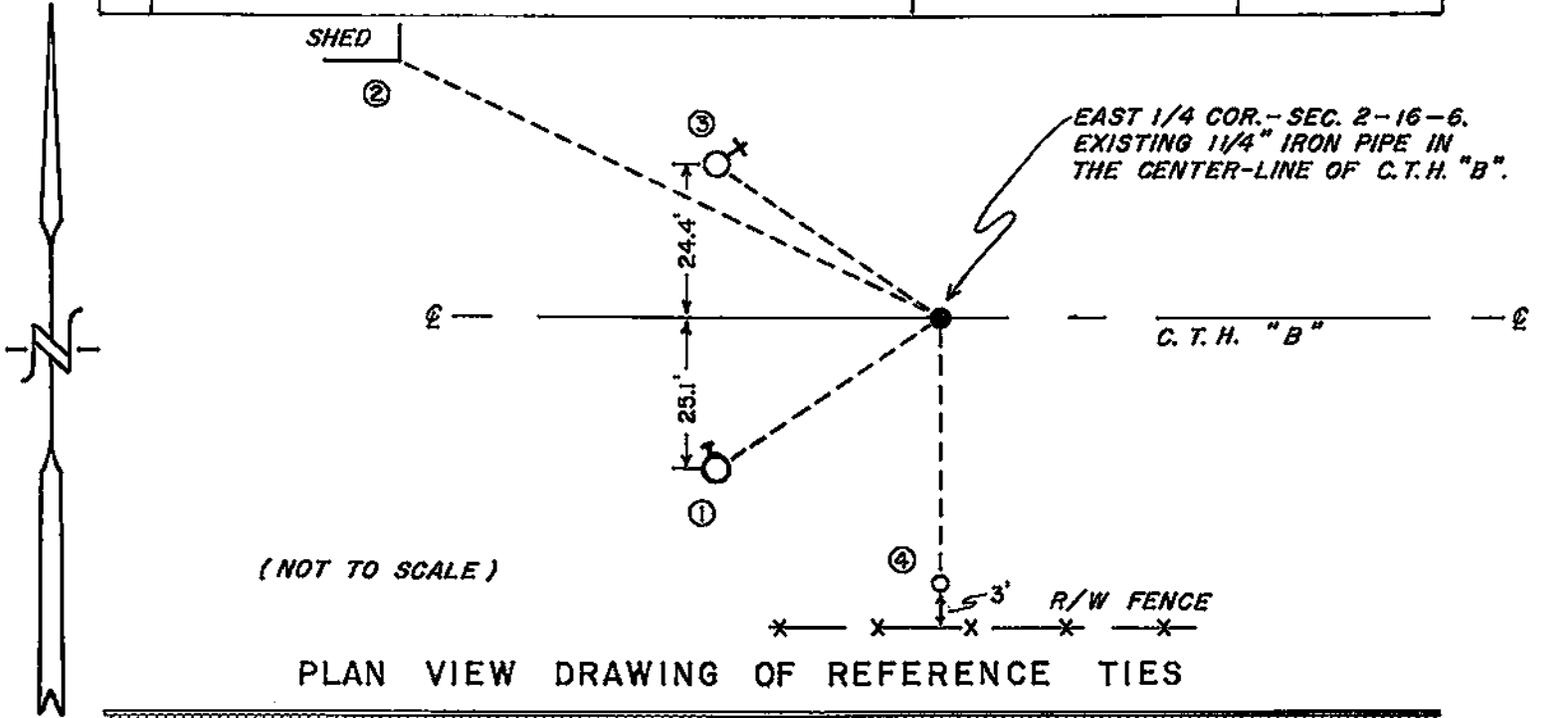

PLAN VIEW DRAWING OF REFERENCE TIES

MAP SHOWING DISTANCE AND DIRECTION TO OTHER PUBLIC LAND SURVEY CORNERS USED FOR REESTABLISHING THE CORNER

(not to scale)

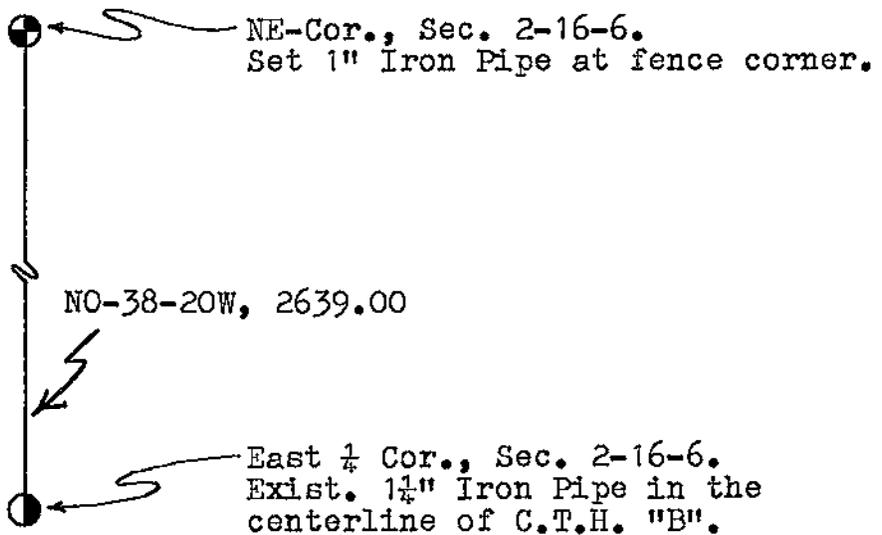

I, William C. Jung, Deputy County Surveyor
 HEREBY CERTIFY THAT THE CORNER LOCATION SHOWN ON THIS RECORD
 WAS DETERMINED BY ME OR UNDER MY DIRECTION AND CONTROL AND
 THAT THIS U. S. PUBLIC LAND SURVEY MONUMENT RECORD IS CORRECT
 AND COMPLETE TO THE BEST OF MY KNOWLEDGE AND BELIEF.

William C. Jung
 Signature

July 20, 1989
 Date



Seal