


21606030000

## U. S. PUBLIC LAND SURVEY MONUMENT RECORD

SECTION 11 T 16 N, R 6 W, TOWN OF HAMILTON

LA CROSSE COUNTY

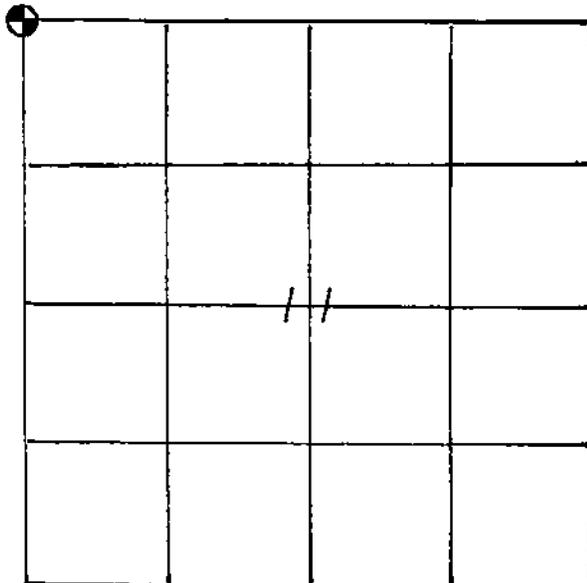

LOCATION OF LANDMARK

DATE: 12-16-86

CREW: BILL JUNG, PERRY DAHL

## WISCONSIN COORDINATE SYSTEM

North

East

Theta Angle

Horiz. Order

Vert. Order

## TYPE OF LANDMARK

BRASS CAPPED LUNDE MARKER

## BEARINGS ARE REFERENCED TO

True North ( $\pm 2'$ )

Describe any record evidence, monument evidence, testimonial evidence or any other material evidence you considered and whether the monument was found or restored through acceptance of an obliterated evidence location.


Gary Sime set an iron bar at the occupied fence corner in September of 1978. Dick Berg used this bar as the corner in 1985 as did Bob Chalsma. I accepted this point as the best available evidence of the original government corner position, removed the bar, and replaced it with a Lunde Marker.

Describe or show any material discrepancy between the location of the restored corner and that of the corner previously restored or reestablished.

None known.

RECORD OF DURABLE WITNESS MONUMENTS


NO	DESCRIPTION	BEARING	DISTANCE
1	P.K. NAIL IN DOUBLE-BLAZED 6" OAK	---	30.96'
2	P.K. NAIL IN DOUBLE-BLAZED 7" OAK	(Mag) N66°E	13.1'
3	P.K. NAIL IN DOUBLE-BLAZED 19" OAK	EAST ±	21.6'
4	P.K. NAIL IN UNBLAZED 3.5' DIAM. OAK	SOUTH ±	25.84'

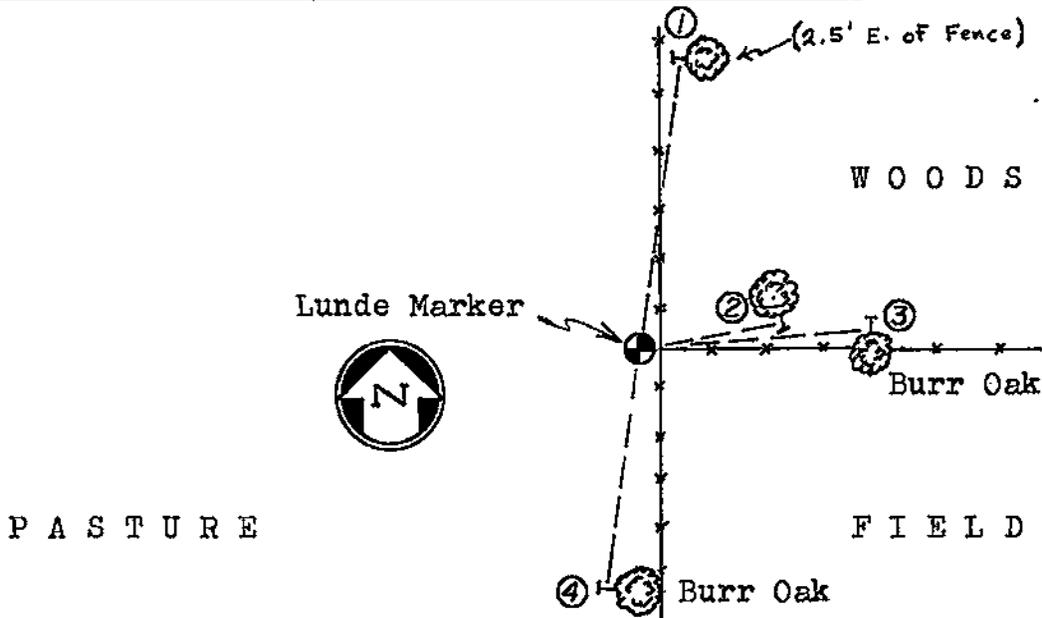

PLAN VIEW DRAWING OF REFERENCE TIES

MAP SHOWING DISTANCE AND DIRECTION TO OTHER PUBLIC LAND SURVEY CORNERS USED FOR REESTABLISHING THE CORNER


(Not to scale)

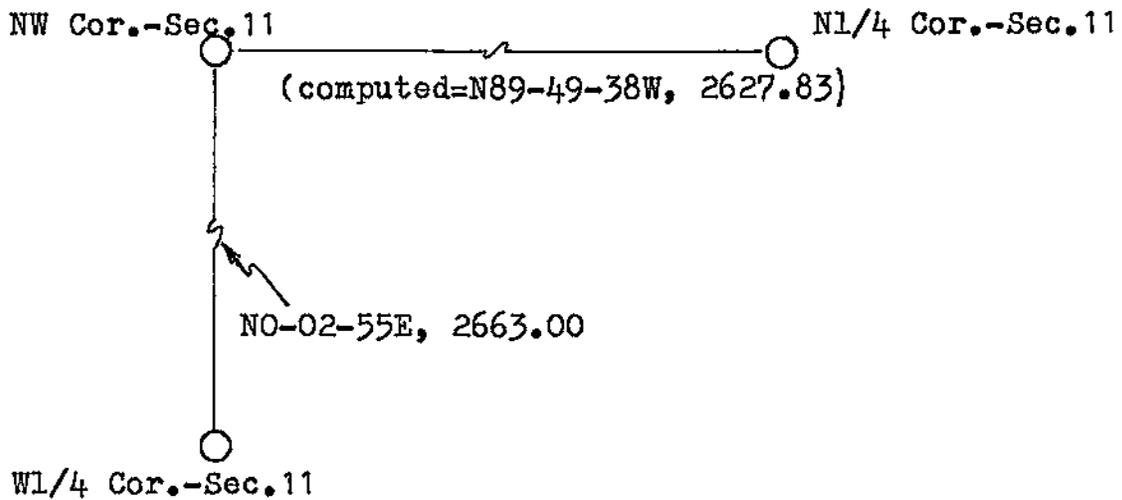

I, William C. Jung, Deputy County Surveyor  
 HEREBY CERTIFY THAT THE CORNER LOCATION SHOWN ON THIS RECORD  
 WAS DETERMINED BY ME OR UNDER MY DIRECTION AND CONTROL AND  
 THAT THIS U. S. PUBLIC LAND SURVEY MONUMENT RECORD IS CORRECT  
 AND COMPLETE TO THE BEST OF MY KNOWLEDGE AND BELIEF.

William C. Jung  
 Signature

December 31, 1986  
 Date

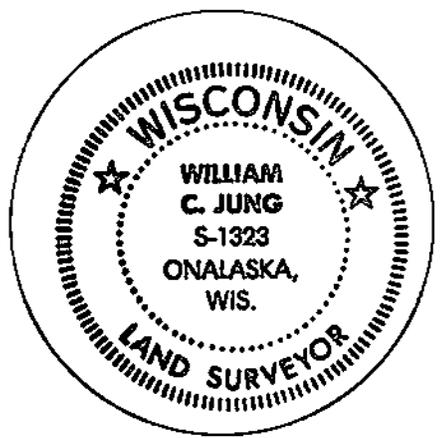

Seal