


21606030020

## U. S. PUBLIC LAND SURVEY MONUMENT RECORD

SECTION 3 T 16 N, R 6 W, TOWN OF HAMILTON

LA CROSSE COUNTY

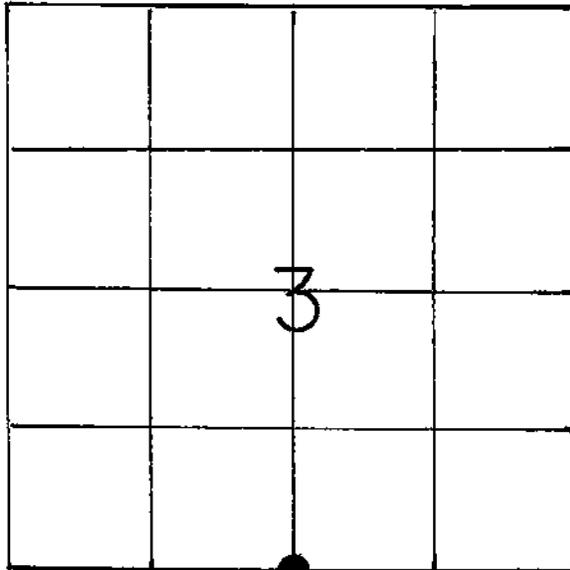

LOCATION OF LANDMARK

Crew: William Jung  
Perry Dahl

11/6/84

## WISCONSIN COORDINATE SYSTEM

North

East

Theta Angle

Horiz. Order

Vert. Order

## TYPE OF LANDMARK

Berntsen Monument

## BEARINGS ARE REFERENCED TO

Assumed

Describe any record evidence, monument evidence, testimonial evidence or any other material evidence you considered and whether the monument was found or restored through acceptance of an obliterated evidence location.


Middlebrook was at this corner in 1876. Fred Zietlow shows an existing nail and cap at the corner in 1971. An iron rod shows on the 1976 plans of Fennighkoh Road. I believe that Gary Sime used this point in September of 1978. I set a Berntsen marker over the top of an iron bar. The Berntsen marker is 1.1' North of the centerline. There are also P.K. nails 1.33' to the SW and 1.31' to the SE of the Berntsen. I accepted this occupied corner as the best available evidence of the original government corner position. I knocked off the bottom 1' of the marker. The marker is down 1/2".

Describe or show any material discrepancy between the location of the restored corner and that of the corner previously restored or reestablished.

None known.


RECORD OF DURABLE WITNESS MONUMENTS

NO	DESCRIPTION	BEARING	DISTANCE
1	EXISTING NAIL AND CAP IN POWER POLE	N64°28'30"W	43.31'
2	EXISTING 1 1/2" IRON PIPE	S56°32'30"W	45.24'
3	SET PIECE OF GRADER BLADE	SOUTH	23.65'
4	EXISTING IRON MONUMENT	S79°38'E	100.53'
5	EXISTING NAIL AND CAP IN POWER POLE	N76°36'E	102.24'

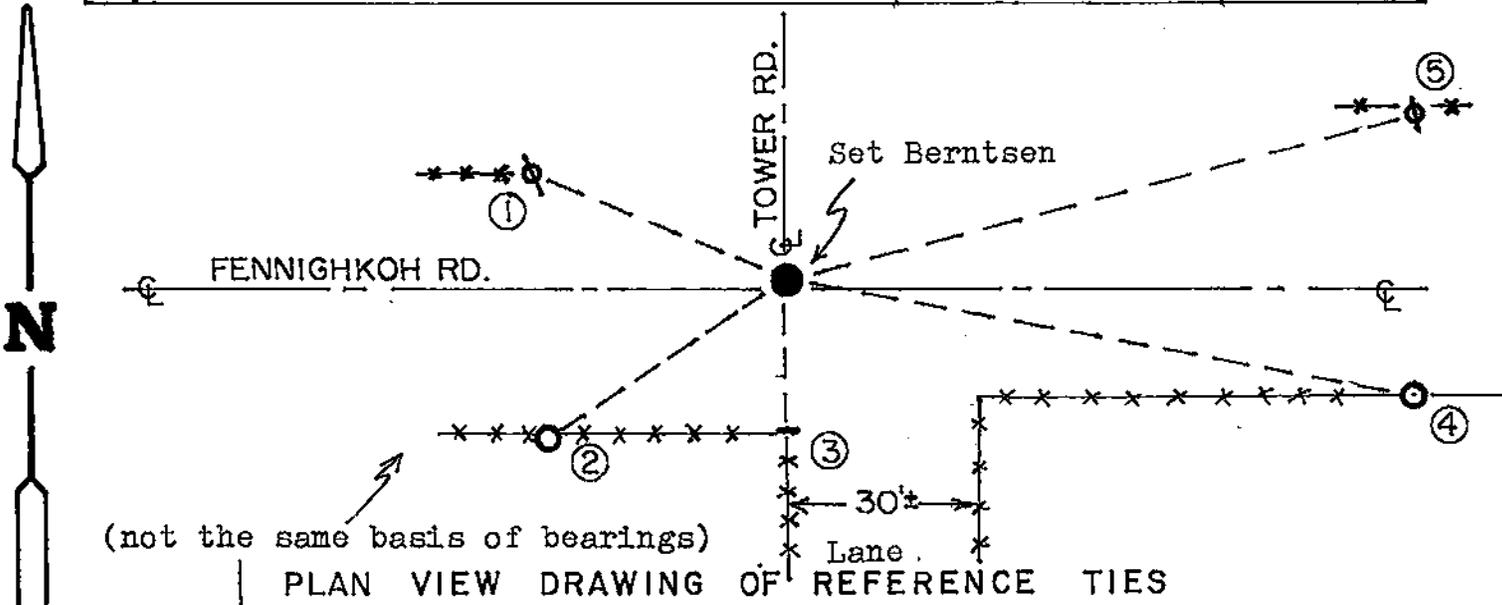

MAP SHOWING DISTANCE AND DIRECTION TO OTHER PUBLIC LAND SURVEY CORNERS USED FOR REESTABLISHING THE CORNER

(not to scale)

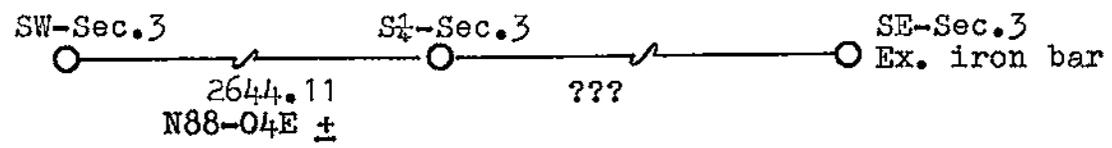

I, William C. Jung, Deputy County Surveyor,  
 HEREBY CERTIFY THAT THE CORNER LOCATION SHOWN ON THIS RECORD  
 WAS DETERMINED BY ME OR UNDER MY DIRECTION AND CONTROL AND  
 THAT THIS U. S. PUBLIC LAND SURVEY MONUMENT RECORD IS CORRECT  
 AND COMPLETE TO THE BEST OF MY KNOWLEDGE AND BELIEF.

William C. Jung  
 Signature

3/14/86  
 Date

