


21606040000

U. S. PUBLIC LAND SURVEY MONUMENT RECORD

SECTION 4 T 16 N, R 6 W, TOWN OF HAMILTON

LA CROSSE COUNTY

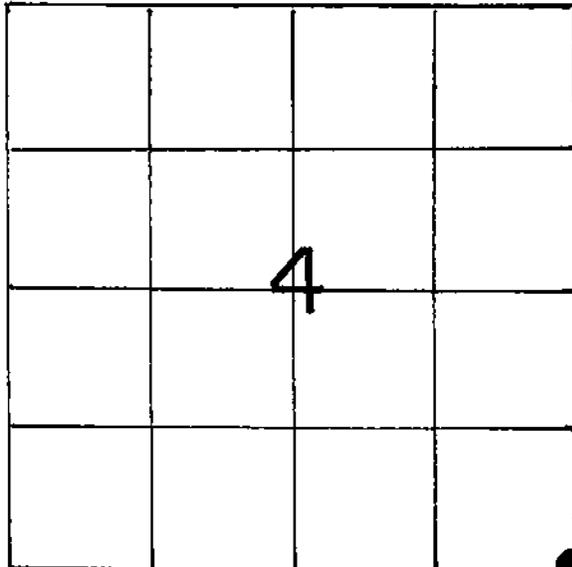

LOCATION OF LANDMARK

Crew: William Jung
Perry Dahl
9/28/84

WISCONSIN COORDINATE SYSTEM

North

East

Theta Angle

Horiz. Order

Vert. Order

TYPE OF LANDMARK

BERNTSEN

BEARINGS ARE REFERENCED TO

Assumed


Describe any record evidence, monument evidence, testimonial evidence or any other material evidence you considered and whether the monument was found or restored through acceptance of an obliterated evidence location.

Middlebrook was at this corner in 1876. Fred Zietlow set an iron bar at this corner in June of 1970. He used it again in 1971. Duane Marten used this bar in January of 1975. Wil Clark used the corner in April of 1979 and April of 1982. I set a nail and cap over an existing iron bar in November of 1979. Wil Clark shows a nail and tab at the corner in June of 1983. Chalsma used this corner in May of 1984. The iron bar showed on the 1976 plans of Fennighkoh Road. I found the nail and cap, removed it, and set a Berntsen, down $\frac{1}{2}$ ". The road had been built up. I got a Schonstedt reading at the bottom of the hole.
Describe or show any material discrepancy between the location of the restored corner and that of the corner previously restored or reestablished.


None known.

RECORD OF DURABLE WITNESS MONUMENTS

NO	DESCRIPTION	BEARING	DISTANCE
1	HOLE IN TOP OF END OF CULVERT	N50°47'W	29.34'
2	CENTER OF STREET SIGN POST	S12°59'W	28.4'
3	HOLE IN TOP OF END OF CULVERT	N66°55'E	51.32'
4	EXISTING 1 1/4" IRON PIPE	NORTH	32.83'

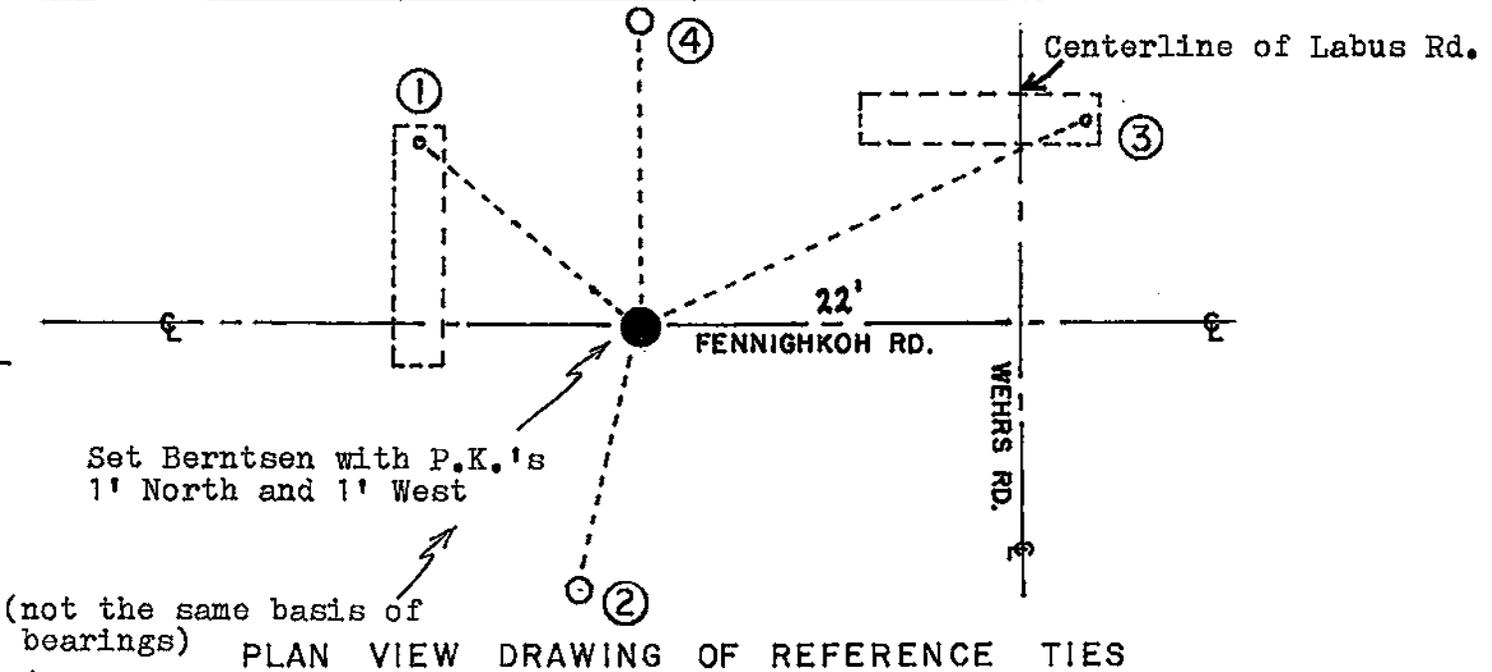

MAP SHOWING DISTANCE AND DIRECTION TO OTHER PUBLIC LAND SURVEY CORNERS USED FOR REESTABLISHING THE CORNER

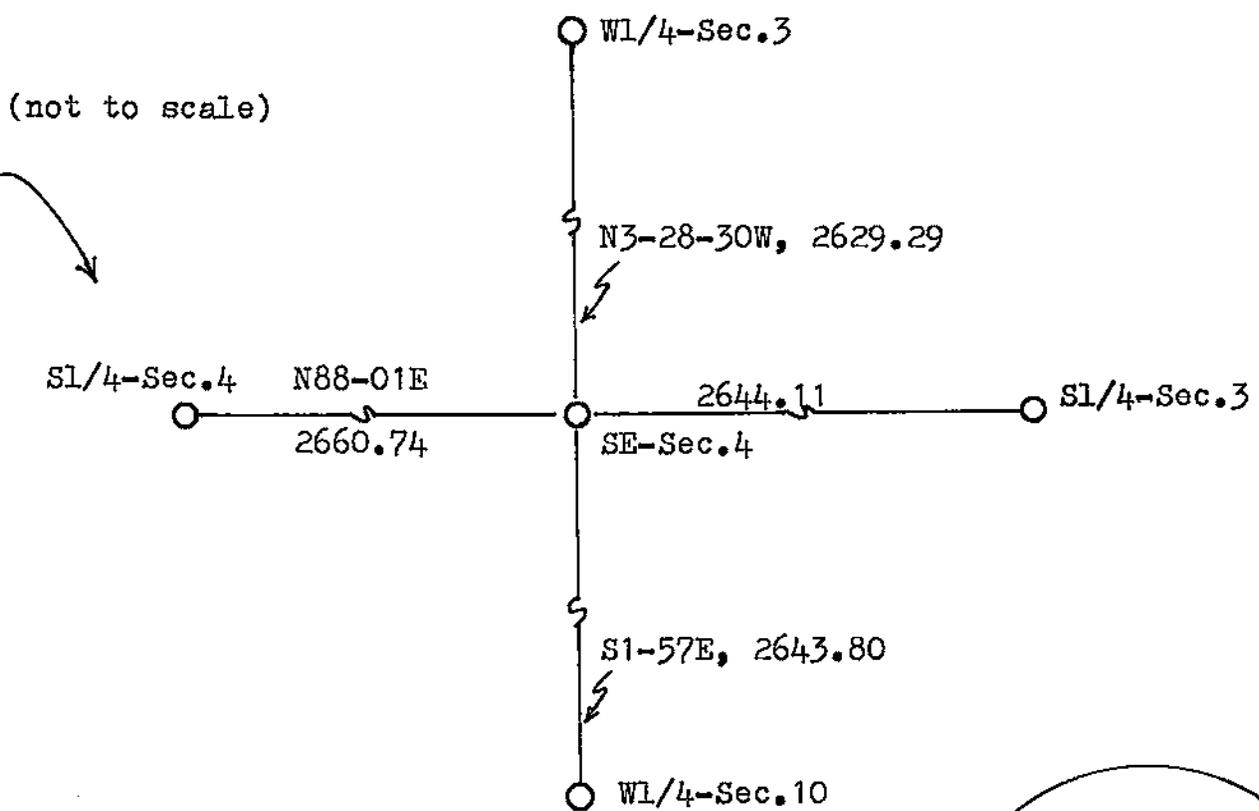

I, William C. Jung, Deputy County Surveyor,
 HEREBY CERTIFY THAT THE CORNER LOCATION SHOWN ON THIS RECORD
 WAS DETERMINED BY ME OR UNDER MY DIRECTION AND CONTROL AND
 THAT THIS U. S. PUBLIC LAND SURVEY MONUMENT RECORD IS CORRECT
 AND COMPLETE TO THE BEST OF MY KNOWLEDGE AND BELIEF.

William C. Jung
 Signature

3/14/86
 Date

